


All dimensions shall be verified by the contractor on site prior to work commencing.

Do not scale from this drawing. Only work to written dimensions

This drawing is the property of Robert Sheard and copyright is reserved by him. The drawing is not to be copied or disclosed by or to any unauthorised persons without prior written consent.

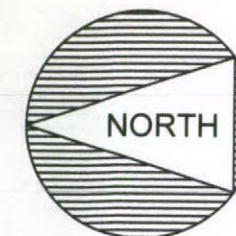

EX. 179.400+ Existing Levels

8.350+ Proposed Levels

STATUS: as built

F	AS BUILT	10/09
E	elec/water meter position added	10/08
D	Issued for Construction	28/07
C	Issued for Building Regulations	18/07
B	Issued for planning.	15/07
A	updated in line with planners Com.	08/07

REV ITEM date by



ROB SHEARD
ARCHITECTURAL DRAFTING SERVICE
tel. 01457 865489
mob. 07733098362
email. robbsheard@aol.com

Client:

Mr D ROSTRON

Project: PLOT 1
NORTH ROAD
GLOSSOP

Title: SITE PLAN

Scale: 1: 200 @ A3

Drawn by:
RS

Date: JUNE 2011


Checked by:

Drawing no:

Revision:

RS2011/14 - P-200

F

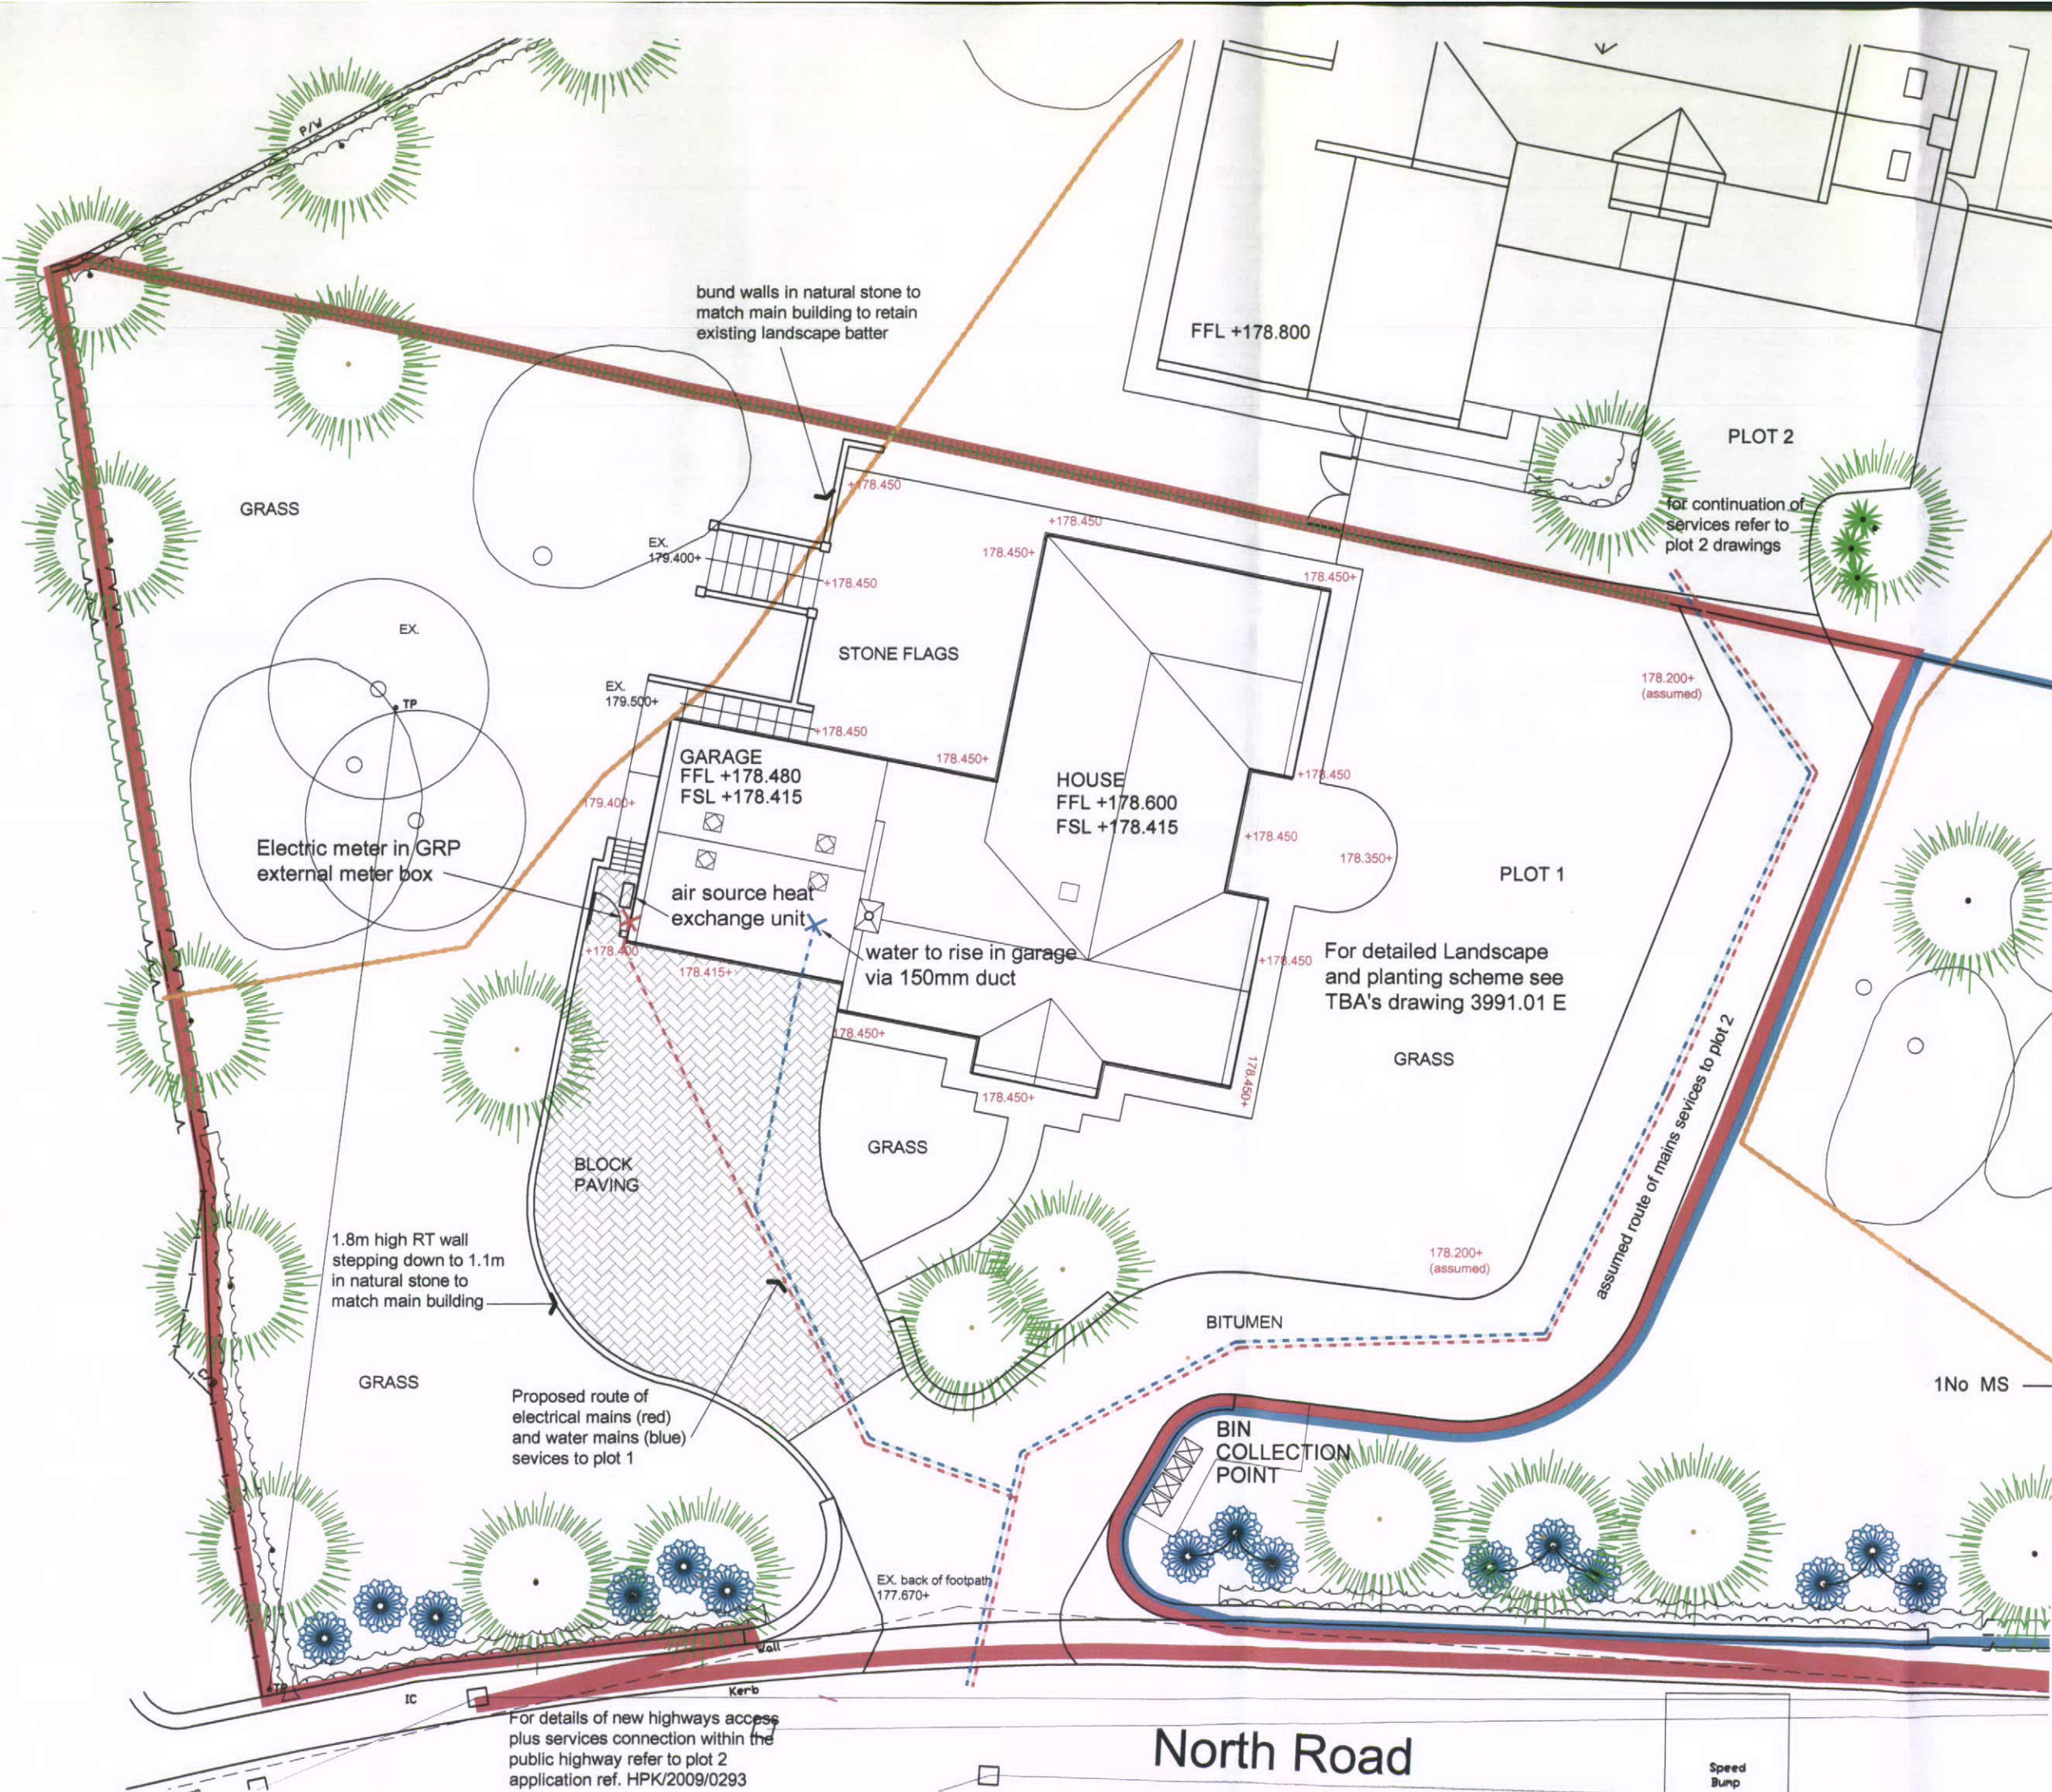

For details of new highways access plus services connection within the public highway refer to plot 2 application ref. HPK/2009/0293

North Road

Speed Bump