



propsoed ground floor plan

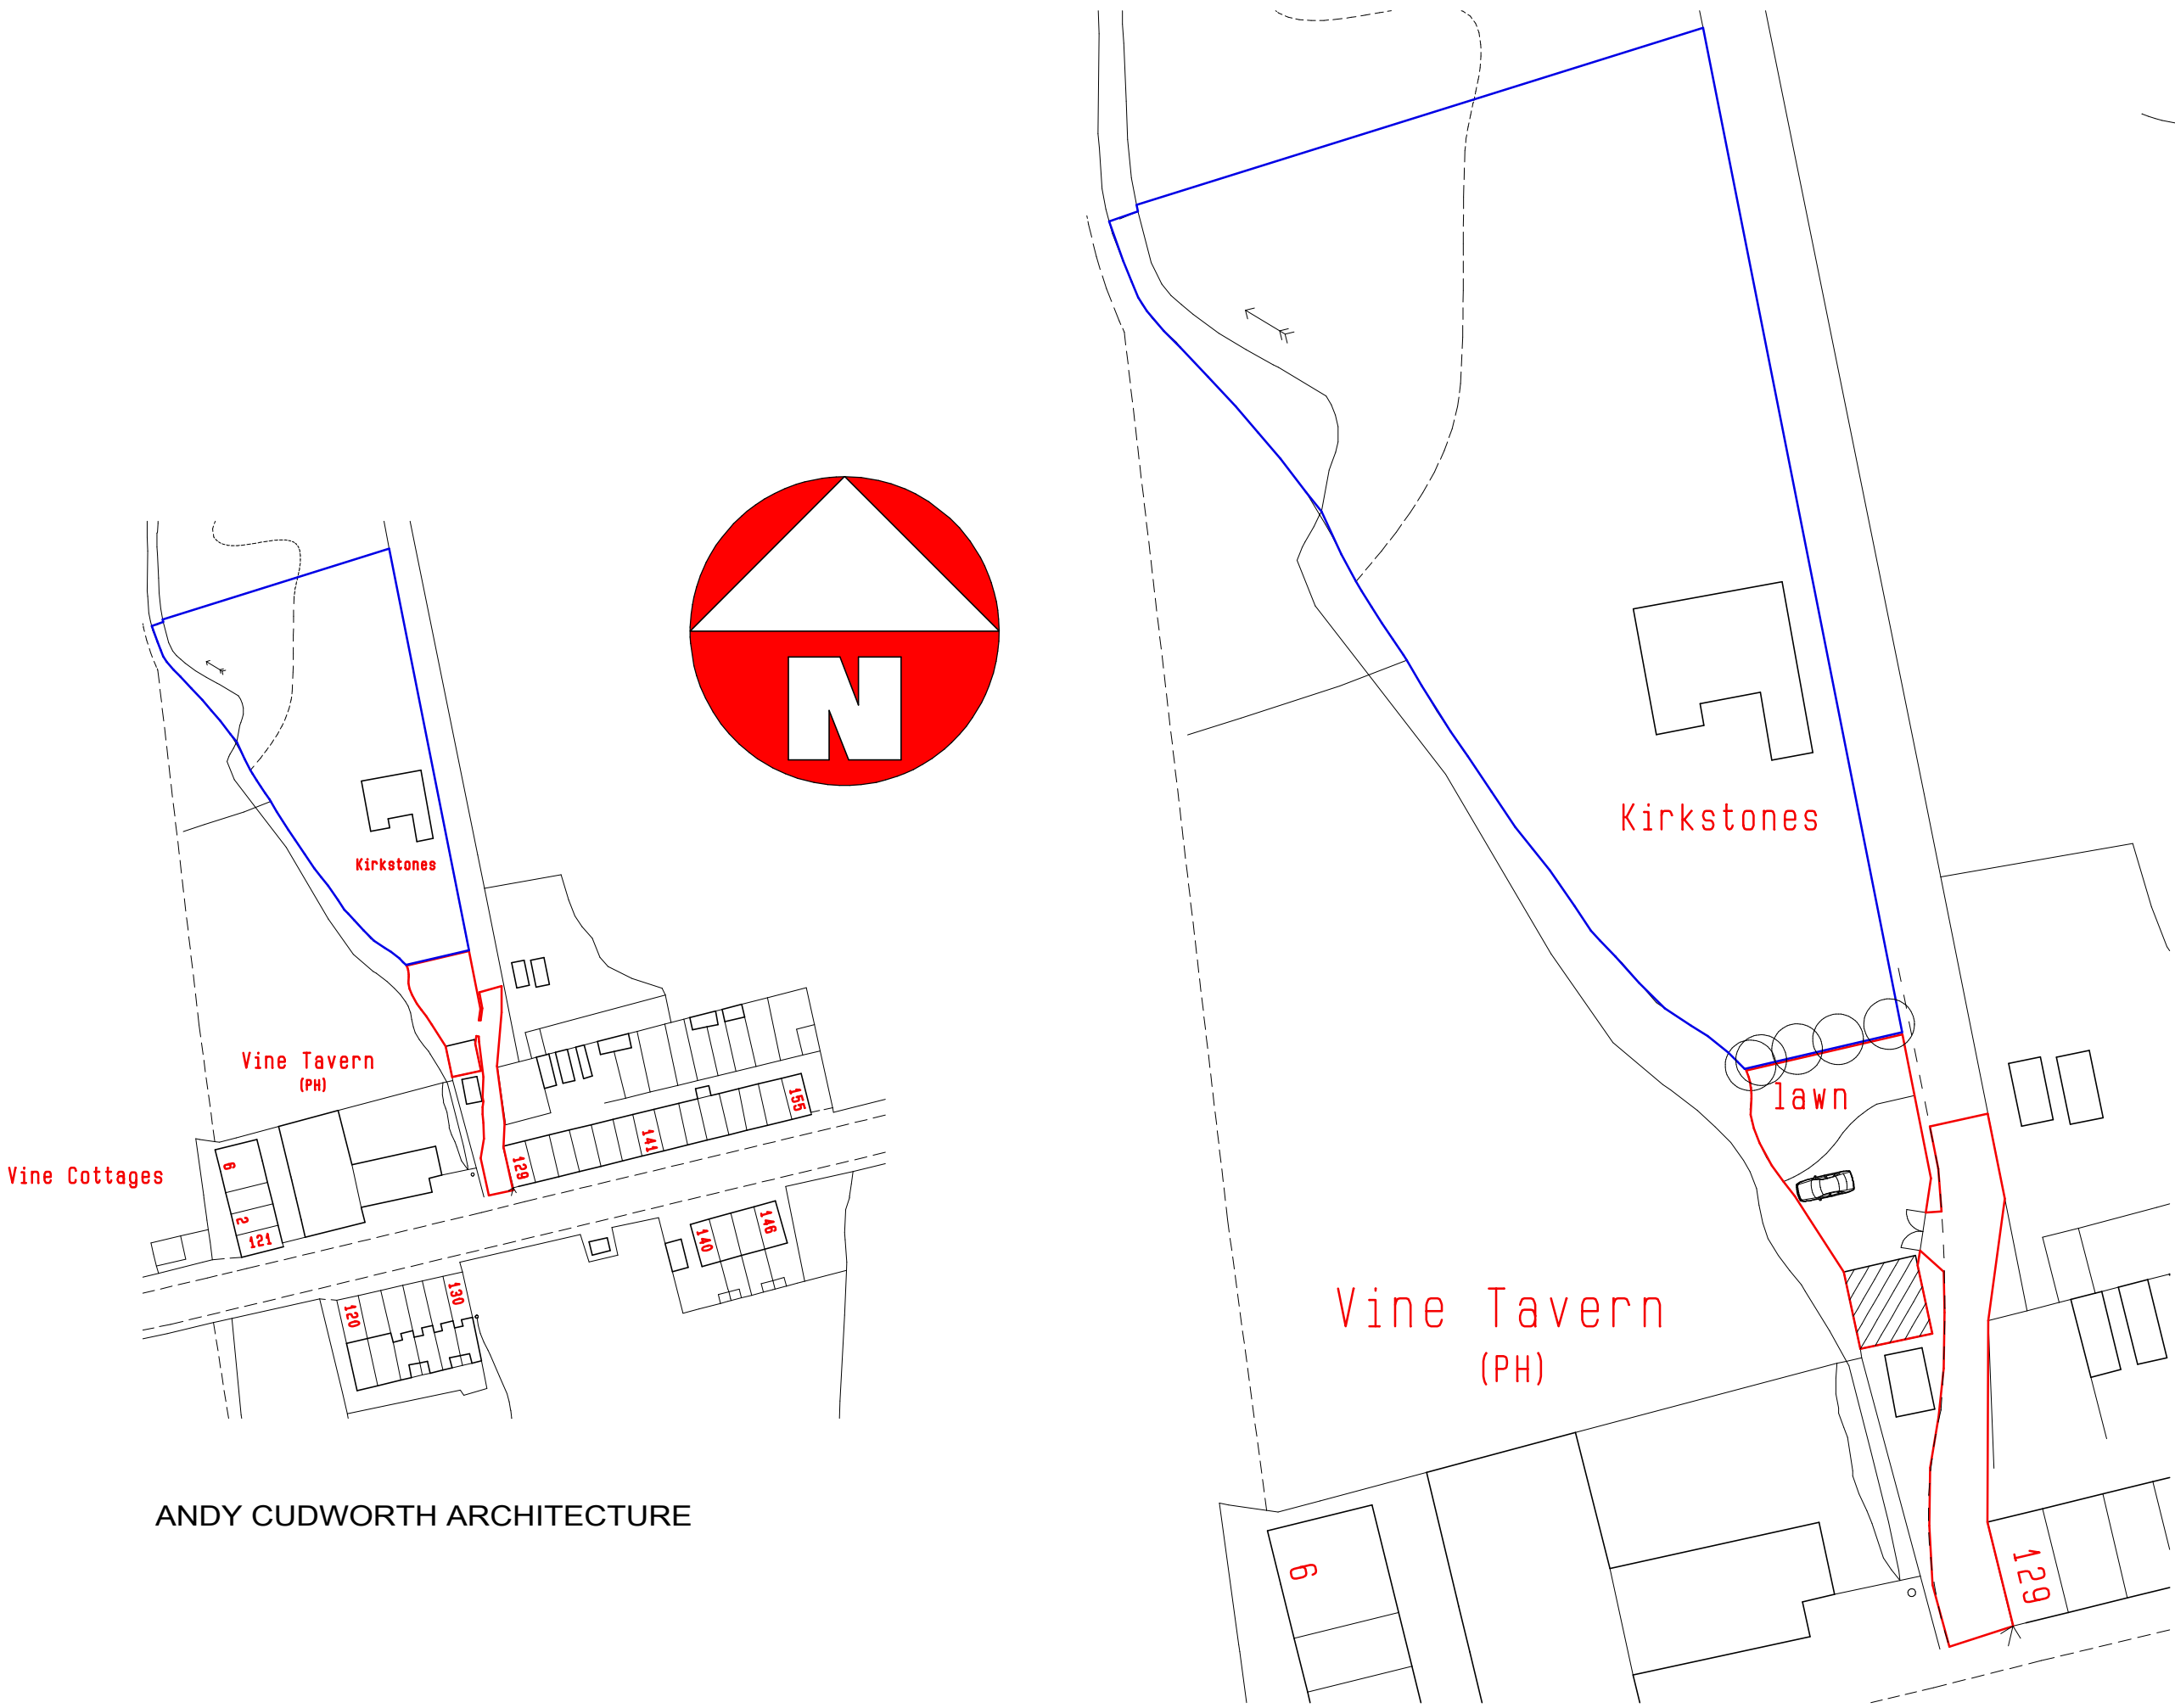

REV B - RED LINE APPLICATION AMENDED - 14/1/13

REV A - EXTENSION REMOVED AND INTERNAL LAYOUT AMENDED - 12/9/12

CLIENT B HOWAT & L CHITTY
TITLE PROPOSED CONVERSION OF BARN
TO 1 BED HOLIDAY LET
AT KIRKSTONES
GARRISON ROAD
BIRCH VALE, SK22 1DQ

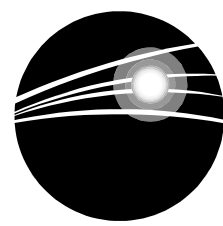

ANDY CUDWORTH ARCHITECTURE
35 Hopwood Street
Barnsley
S70 2BS
01226 215586
07931 365804
acudworth@virginmedia.com

SCALE 1:100, 1:50 DATE MAR 12 DRAWN AMC
DRWG No BHBV-312-2 REV B

This drawing is the sole property of the author (A Cudworth) and will not be used, copied in whole or in part, by any other individual, company or organisation without the consent of the author. All dimensions to be checked on site & not scaled from any drawing.