

DO NOT SCALE FROM DRAWING - USE WRITTEN DIMENSIONS ONLY -ANY DISCREPANCIES SHOULD BE REPORTED TO THE AUTHOR.

ORIGINAL DESIGN COPYRIGHT RETAINED BY PAUL DINSDALE ARCHITECTURE LIMITED 2007. COPIED UNDER LICENCE BY PAUL SEARLE.

TO BE READ IN CONJUNCTION WITH STRUCTURAL ENGINEER'S DETAILS AND SPECIFICATION. ANY DISCREPANCIES TO BE REPORTED TO THE AUTHOR WITHOUT DELAY.

THESE DRAWINGS ARE ISSUED FOR CONSTRUCTION PURPOSES.



Planning Notation

REVISION E DEC14: As-built revisions. Stone detailing & coursing to elevations revised and high-performance window style.

All elevations: 150mm coursed Natural Stone external face with dressed ashlar quoins/cills and heads to doors and windows, stone taken up chimney.

Roof slate in natural blue with roof lights to front elevation and dormers and rooflight to bathrooms to rear elevation.



Dormers to have stone panels with vert. slate hanging/lead to cheeks.

Rainwater goods to be black Upvc gutters and rainwater pipes.

All windows to be high performance double glazed with upvc white. Bays to be stonework with dressed ashlar heads, cills and mullions. Lead flashings and soakers to bay to stonework.

Chimney to be coursed stone with dressed stone cap and clayware pot.

Doors to be white upvc with feature canopy and decorative brackets to ends and mid point.

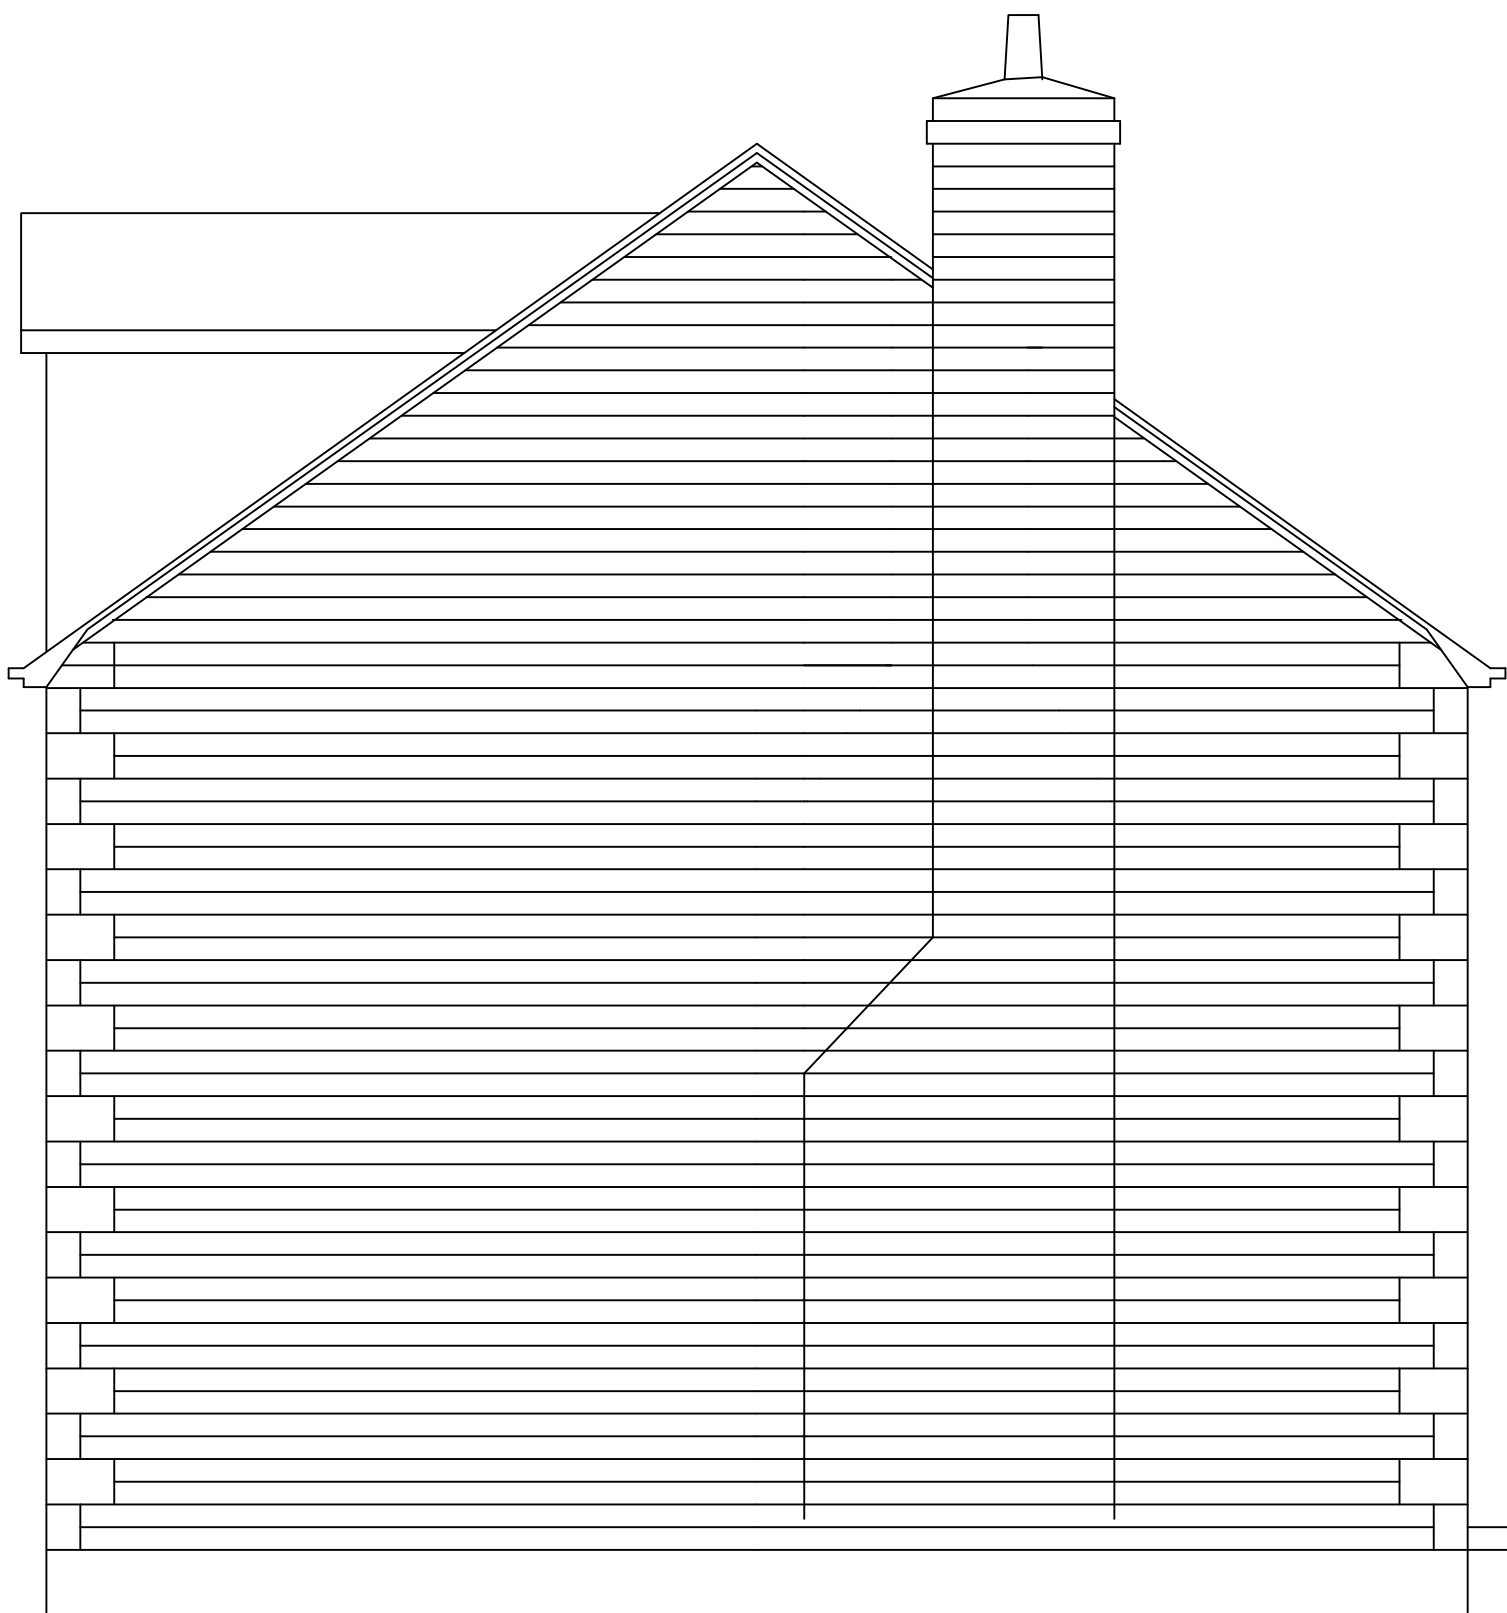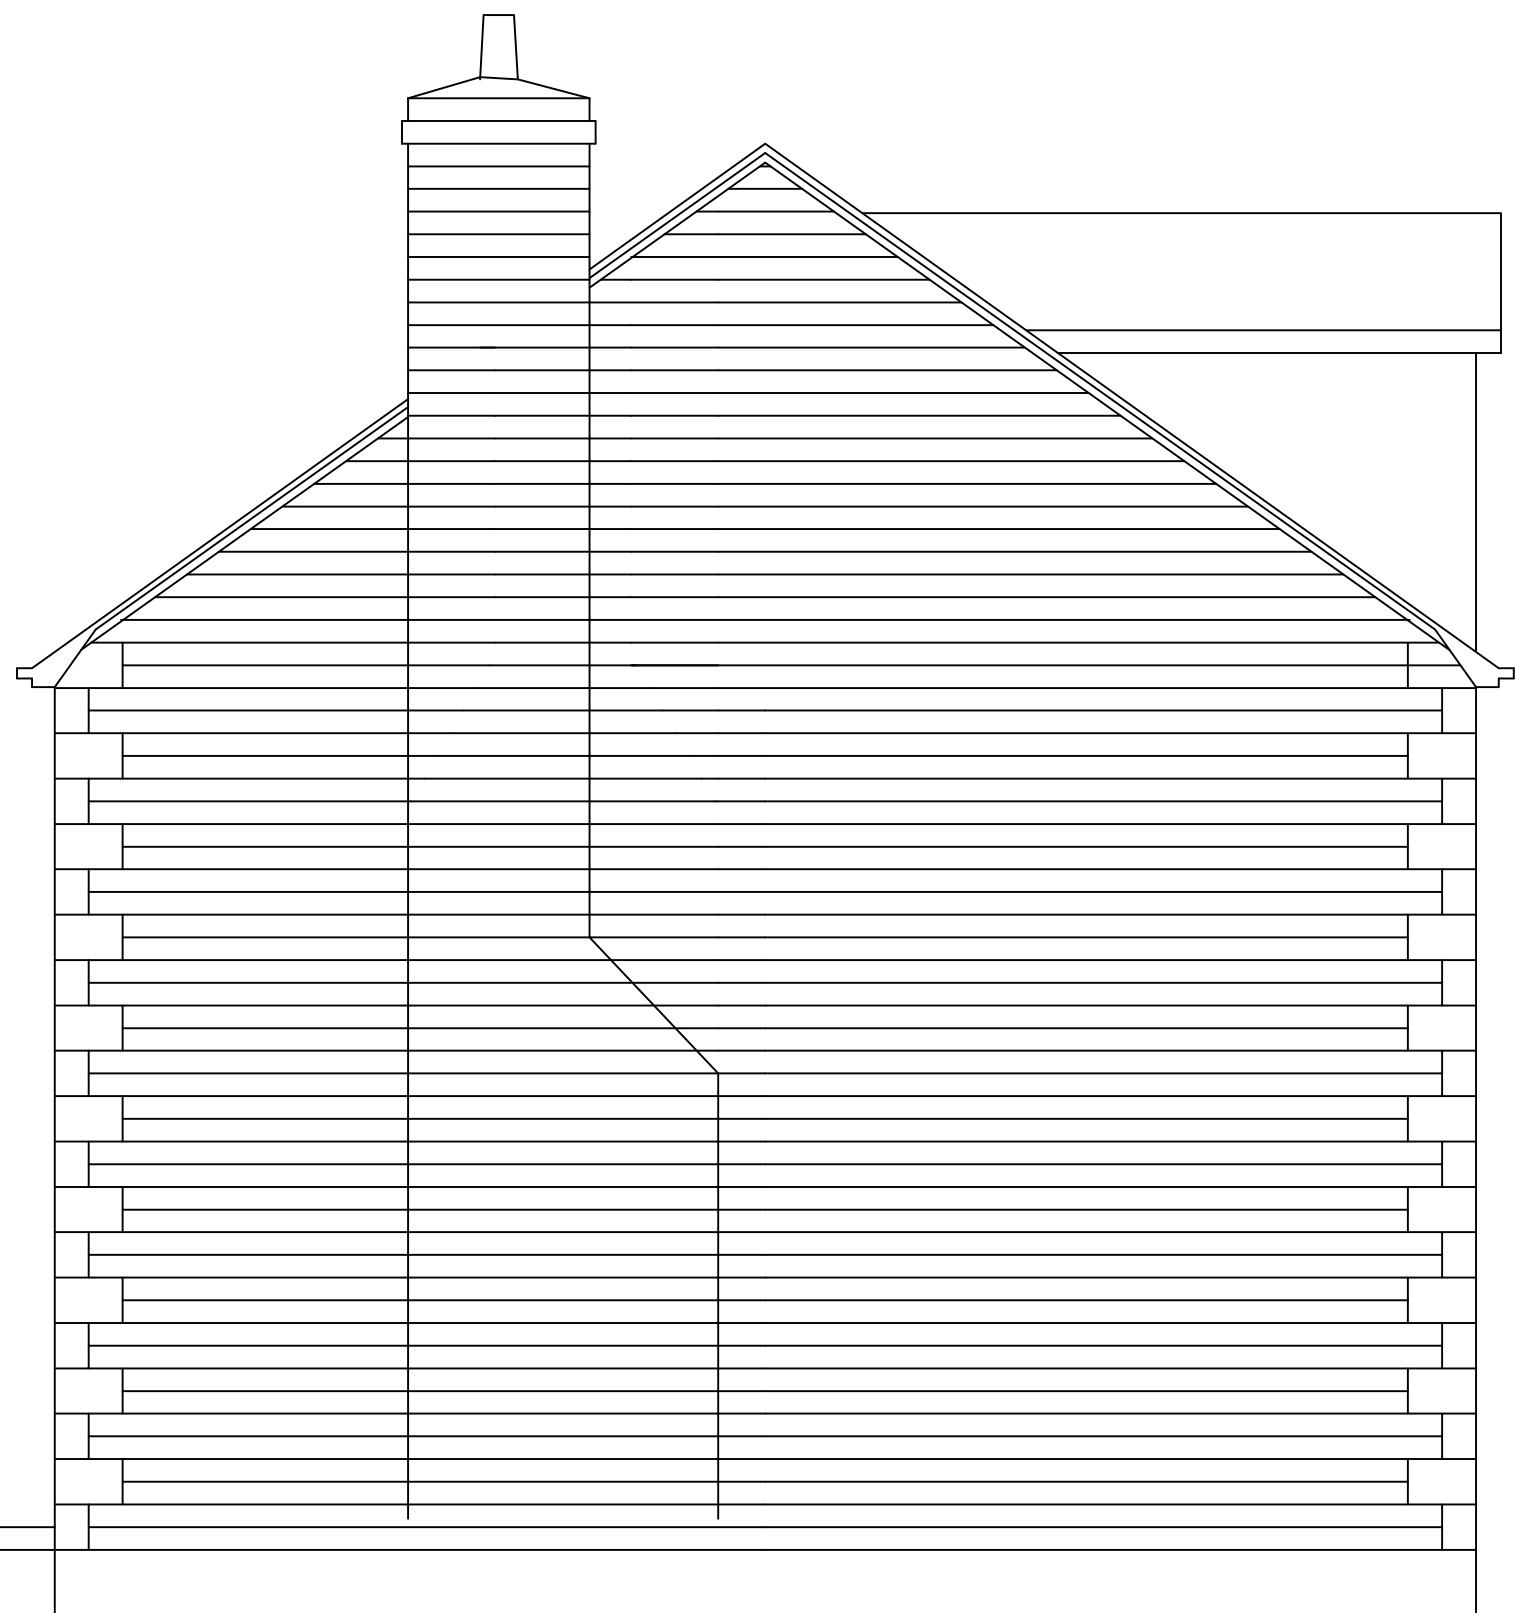

© Copyright 2012 Paul Searle Architect Ltd.			
File: h:\ThePunchBowl\1205_06.dwg			
G1	13MAR15	ps	as-built glazing revs
G	MAR 15	ps	as-built detail48&50
E	DEC 14	ps	as-built detail
Rev	Date	Initials	Description

PAUL SEARLE ARCHITECT LTD
CHARTERED ARCHITECT

MILLINGTON HSE 12 LEEK ROAD CONGLETON CW12 3HU
(01260) 278076 OR MOBILE 07989 410658

JOB
Manchester Road, BUXTON.
CLIENT
Searle Building Co. Ltd.

DRAWING
Proposed House Elevations (as-built).
48&50 Manchester Road

DATE
26/6/2012
DRWG No.
1205/06.

SCALE
1:100 @A3.
REVISION
G1