


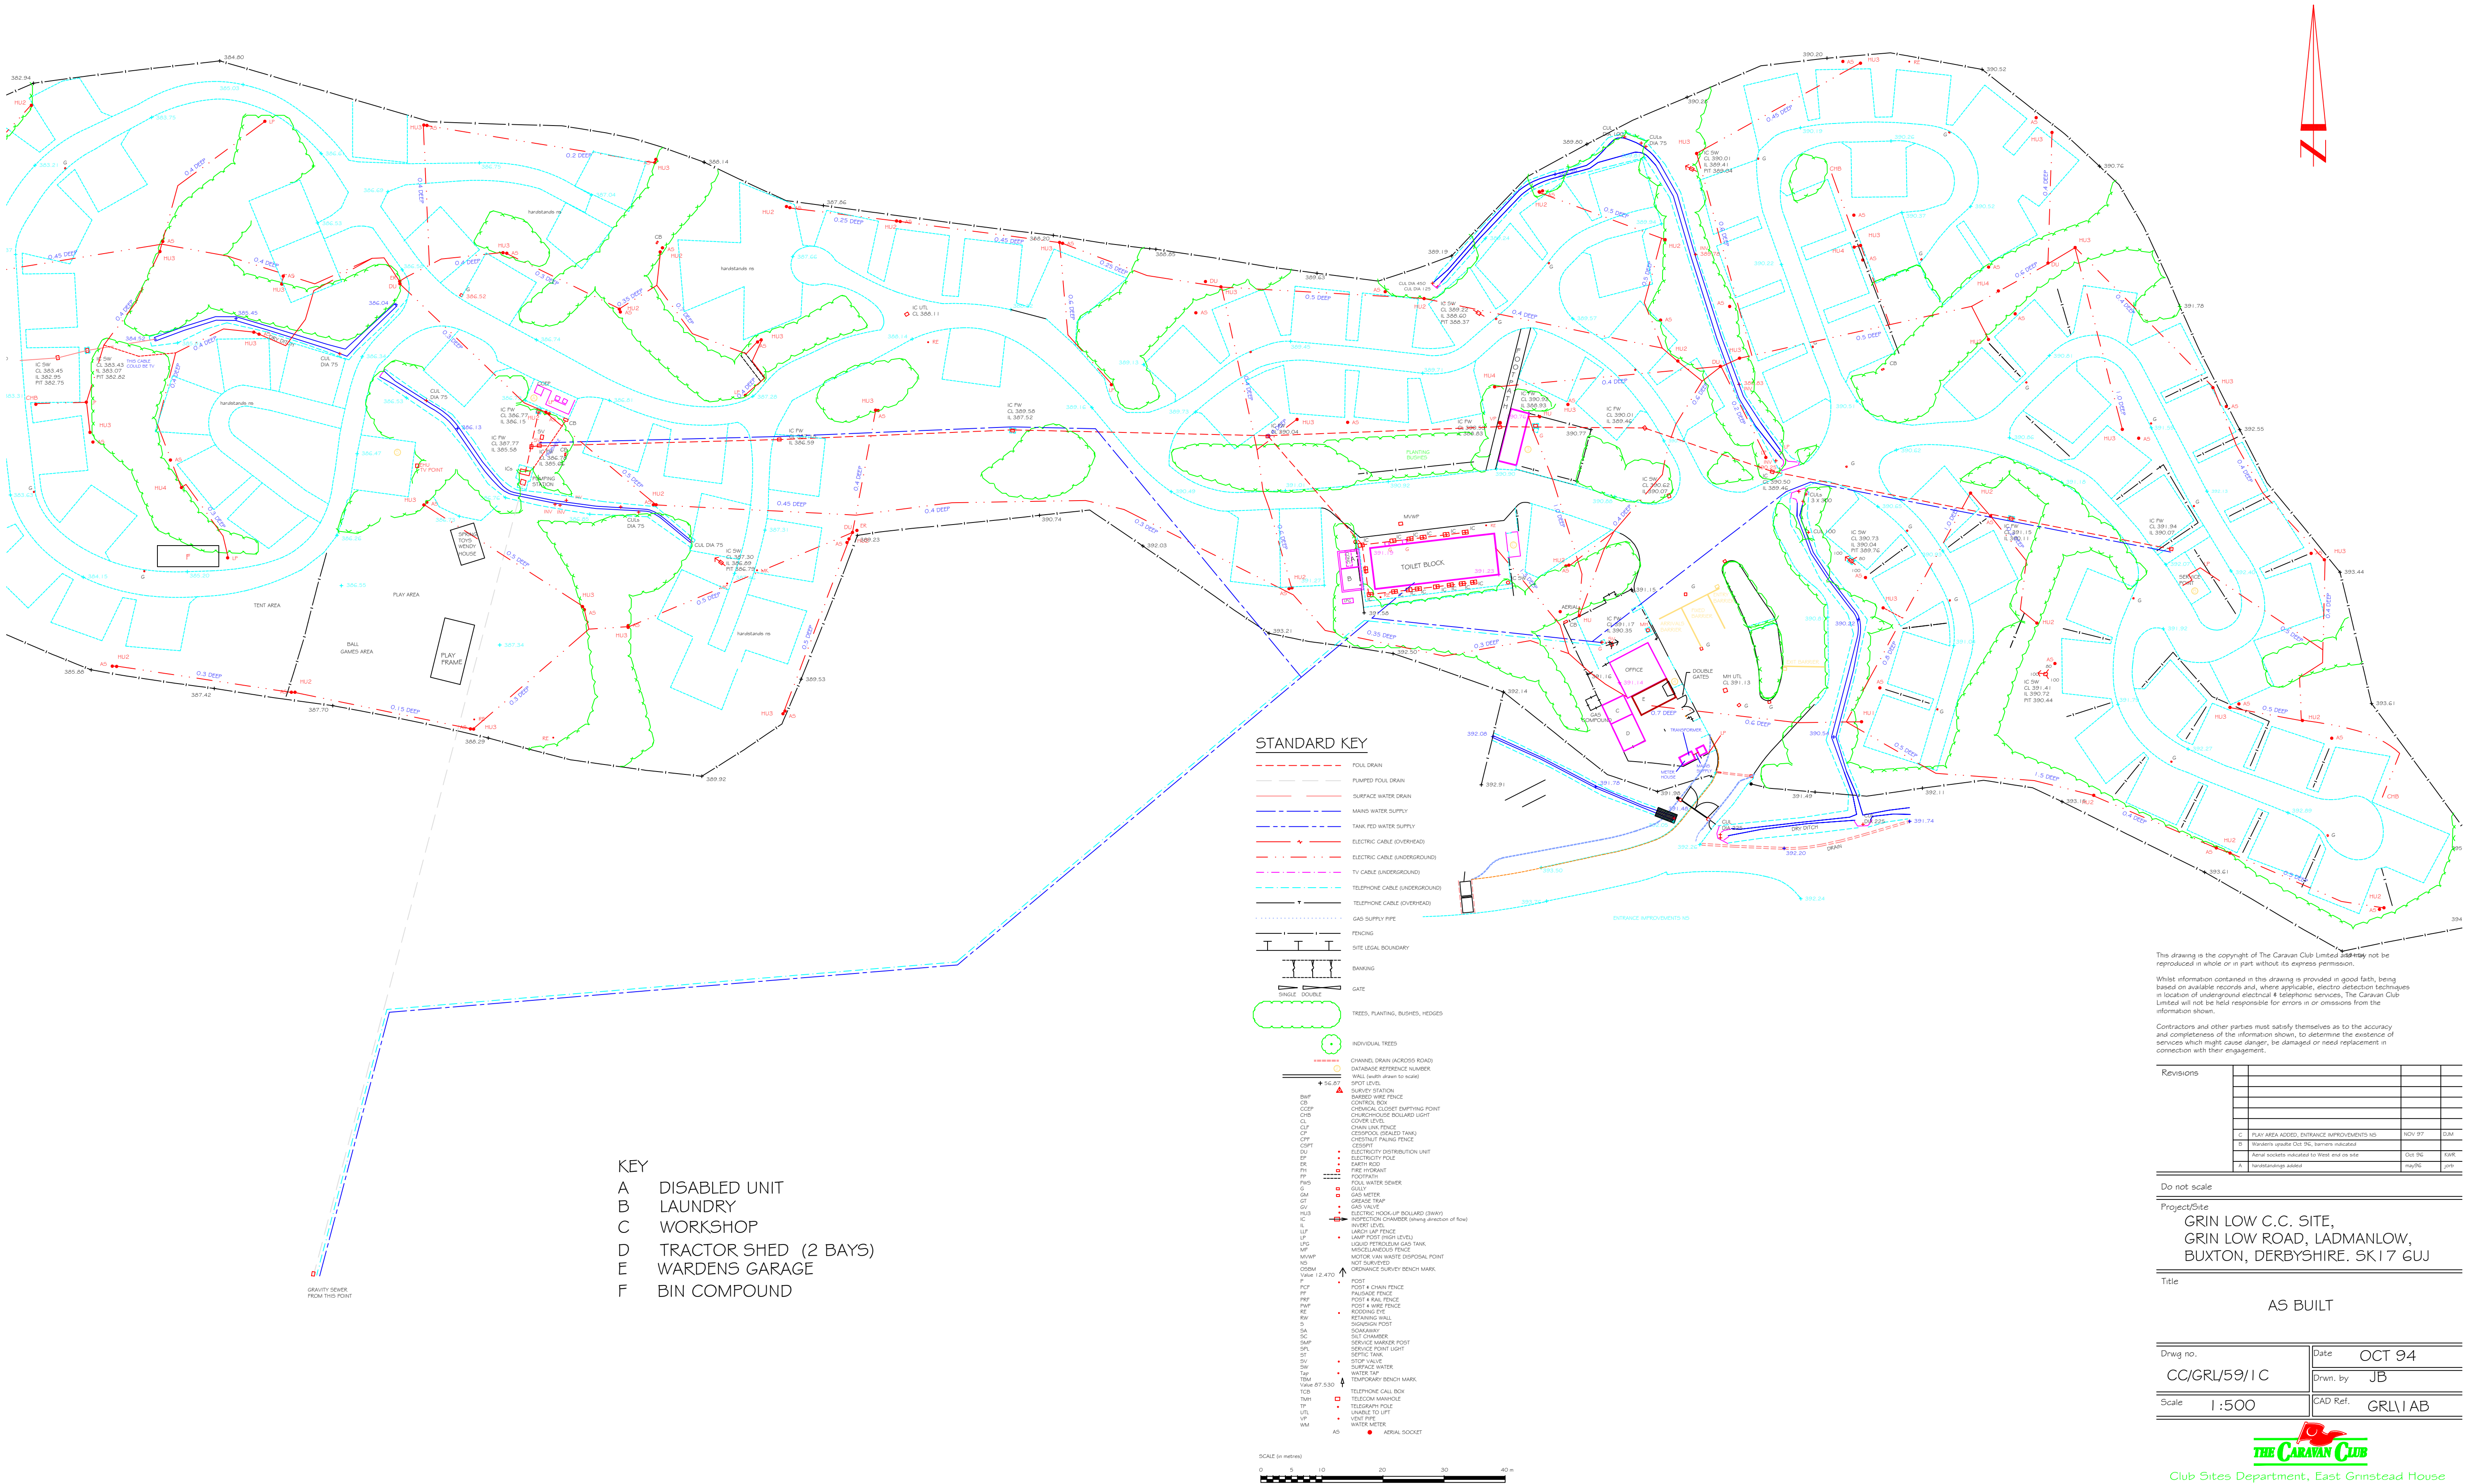

This drawing is the copyright of The Caravan Club Limited and may not be reproduced in whole or in part without its express permission.

Whilst information contained in this drawing is provided in good faith, being based on available records and, where applicable, electro detection techniques in location of underground electrical & telephonic services, The Caravan Club Limited will not be held responsible for errors in or omissions from the information shown.

Contractors and other parties must satisfy themselves as to the accuracy and completeness of the information shown, to determine the existence of services which might cause danger, be damaged or need replacement in connection with their engagement.

Revisions			
C	PLAY AREA ADDED, ENTRANCE IMPROVEMENTS NO.	NOV 97	DMJ
B	Wardens updated Oct 96, barriers indicated		
	Aerial sockets indicated to limit end of site	OCT 96	6406
A	Handover/Storage address	MAY 96	209

Do not scale

Project/Site
GRIN LOW C.C. SITE,
GRIN LOW ROAD, LADMANLOW,
BUXTON, DERBYSHIRE, SK17 6JG

Title
AS BUILT

Drwg no.	Date
CC/GR/59/1C	OCT 94
Drwn. by	JB
Scale	CAD Ref.
1:500	GR/1 AB

THE CARAVAN CLUB

Club Sites Department, East Grinstead House
East Grinstead, West Sussex RH19 1UA
Tel. (01342) 326944
Fax. (01342) 327653