



Existing Site
Scale 1:500

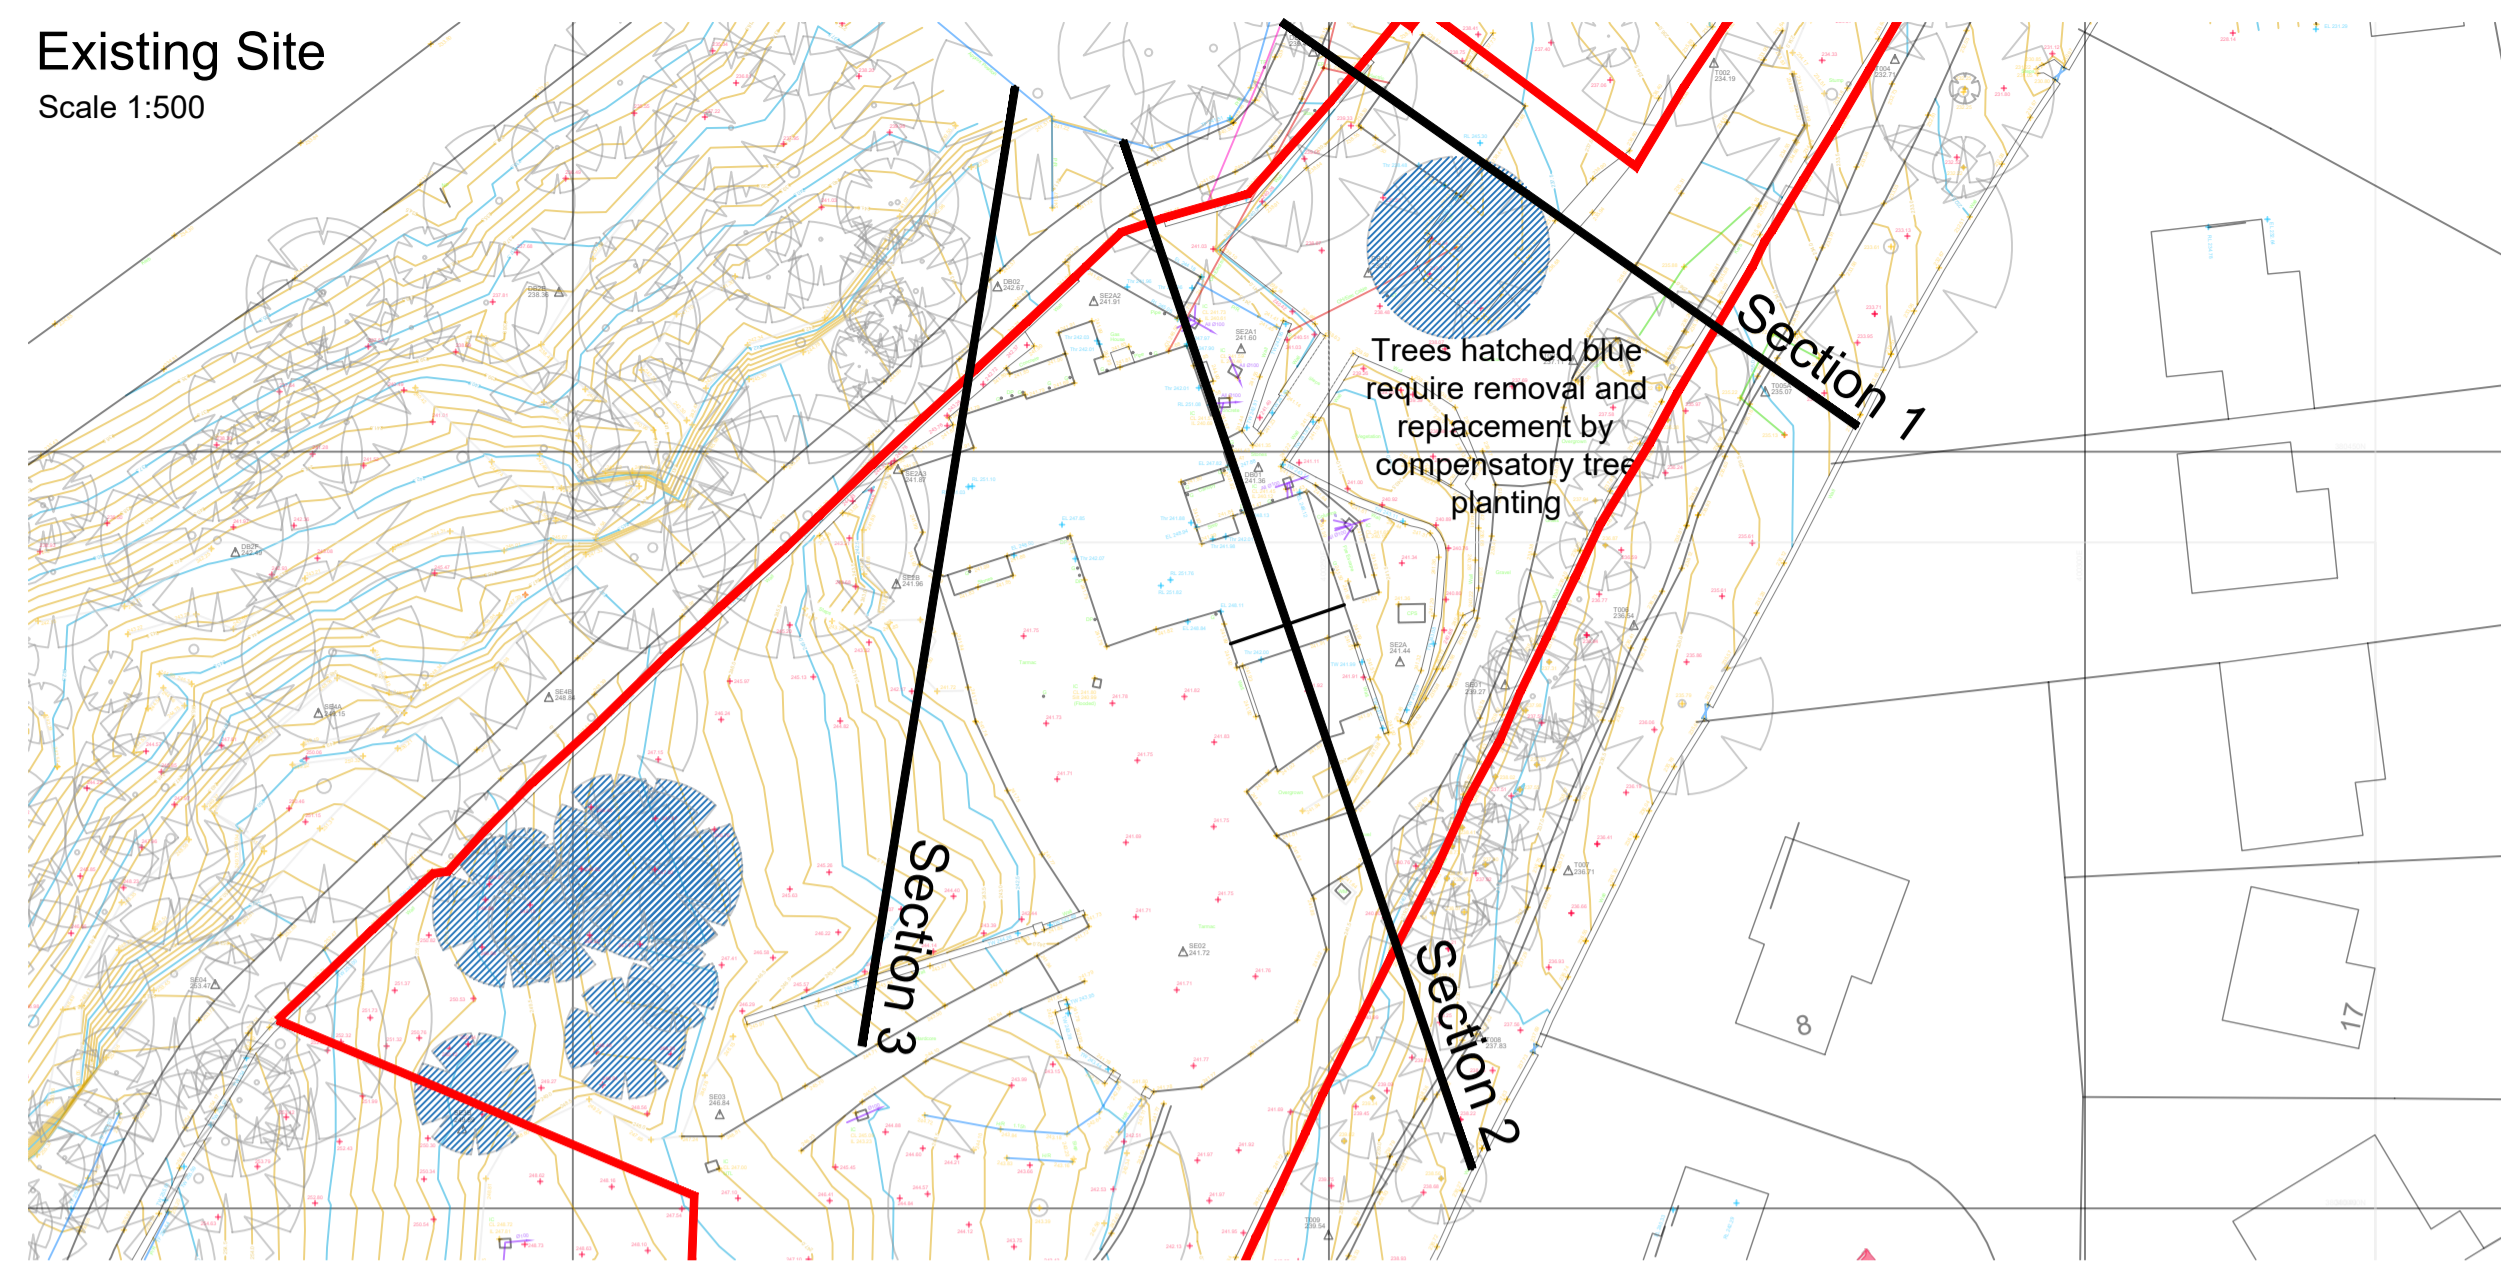


Proposed Site
Scale 1:500

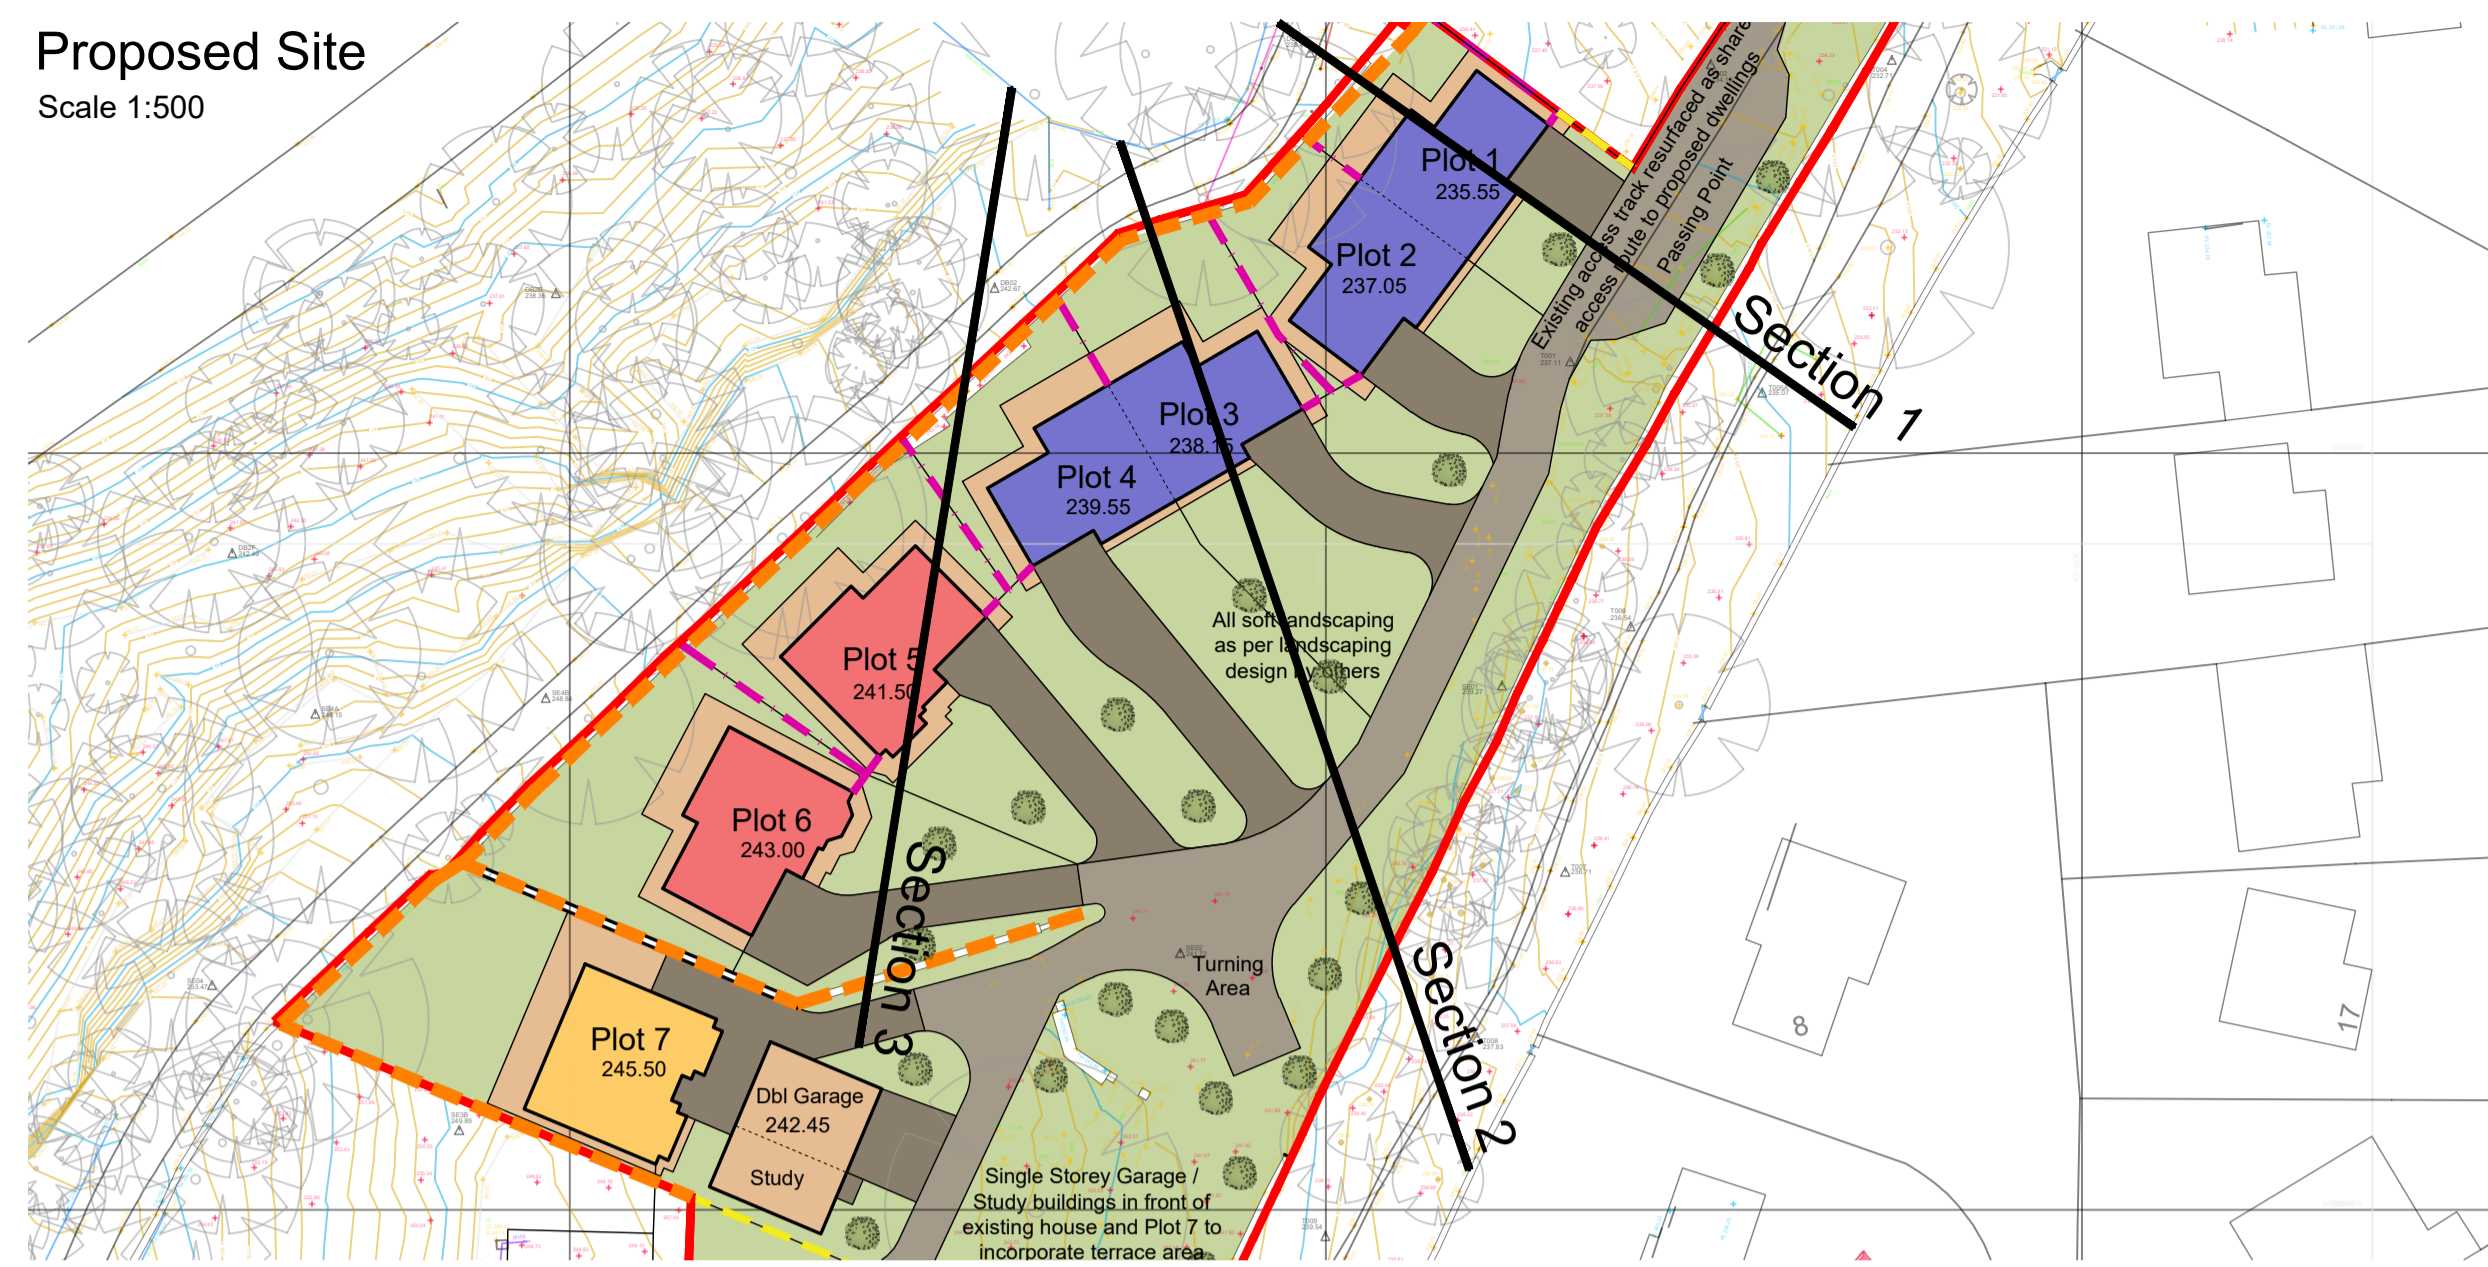

General Notes
 01: Ensure drawing is printed to accurate scale before scaling any dimensions, the scale bar below is to assist. If in doubt, contact TADW Architects.
 02: All dimensions are in millimetres unless noted otherwise.
 03: All dimensions should be verified on site before proceeding with the work.
 04: TADW Architects shall be notified in writing of any discrepancies.
 05: © TADW Limited (UK) 2020

Legend

Section 1
Scale 1:100

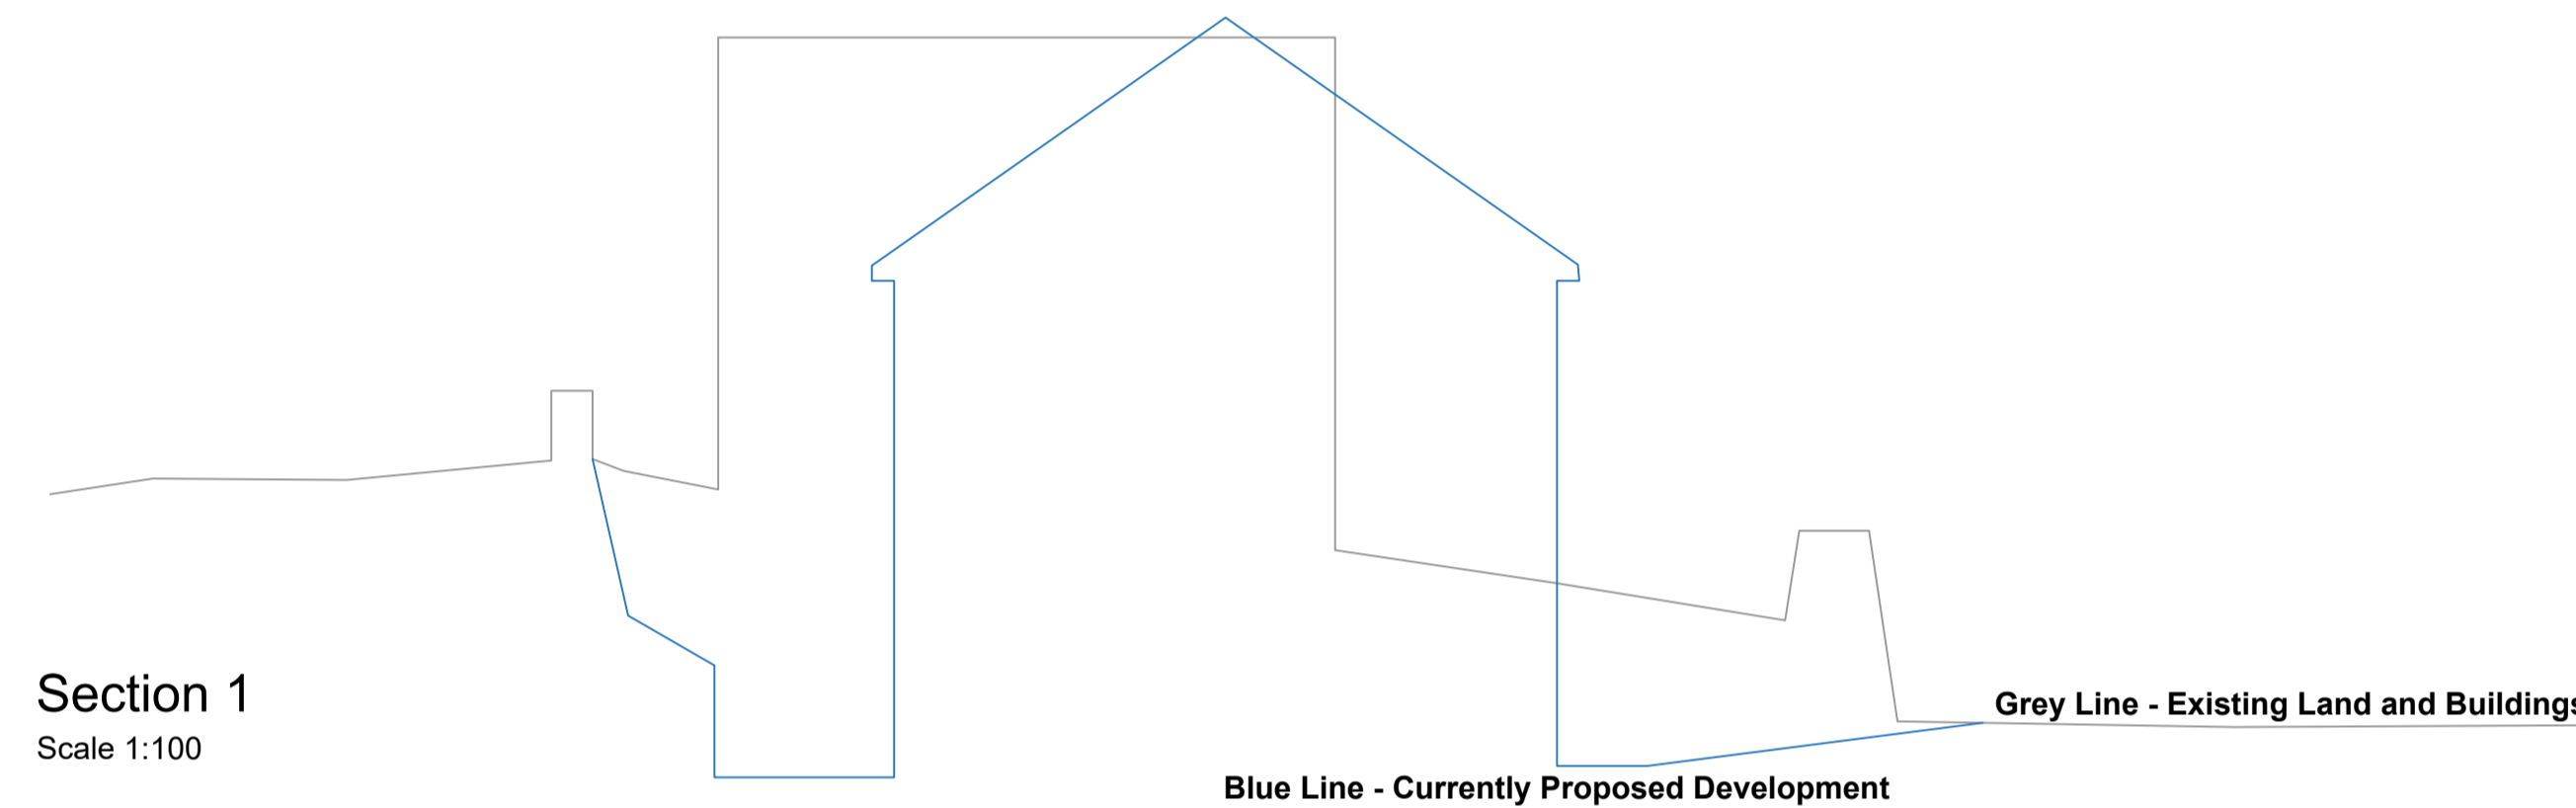


Grey Line - Existing Land and Buildings

Blue Line - Currently Proposed Development

Grey Line - Existing Land and Buildings

Section 2
Scale 1:100

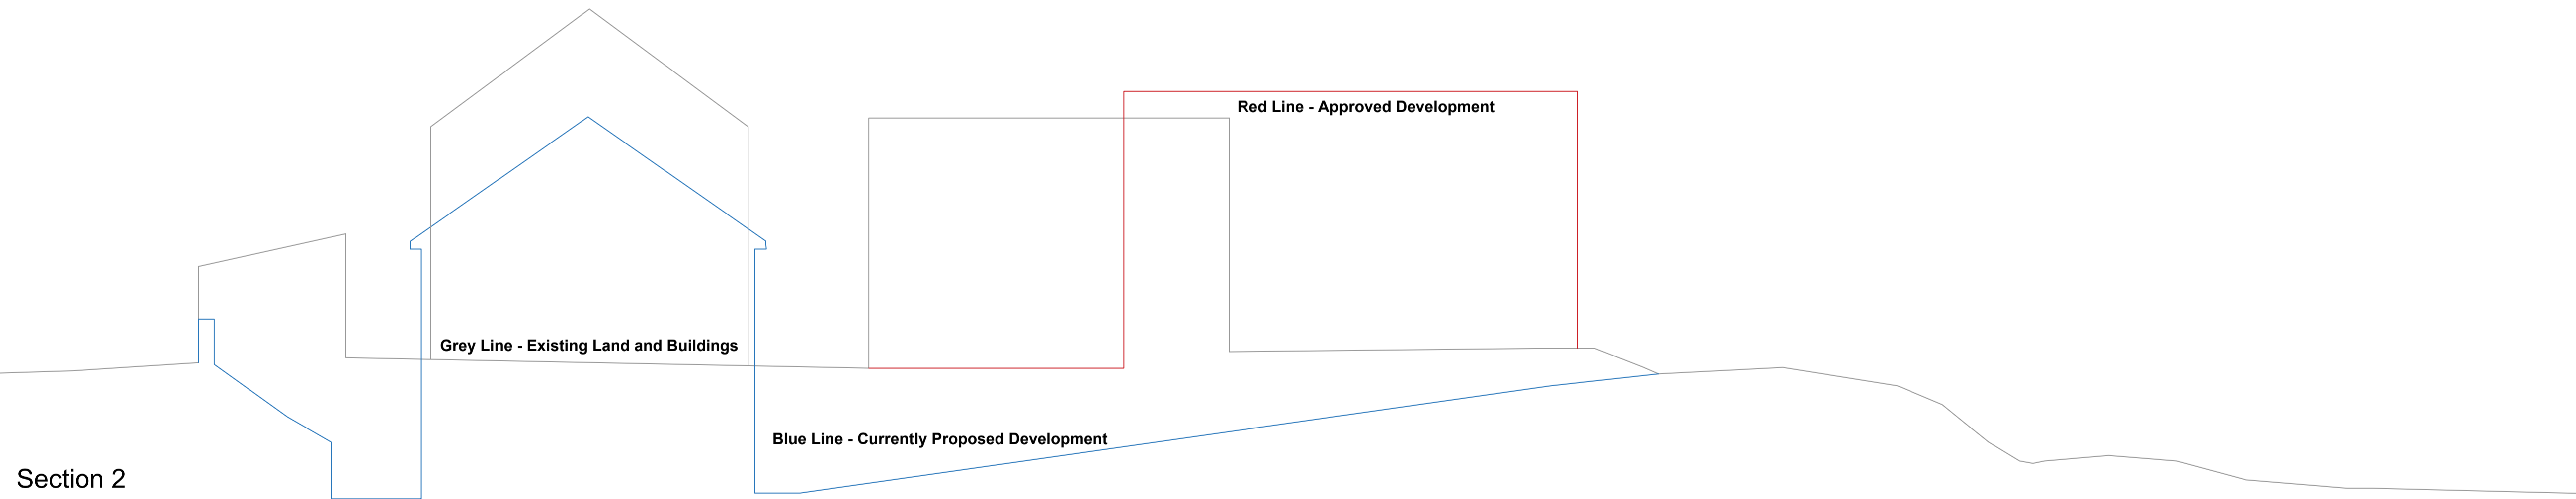


Grey Line - Existing Land and Buildings

Blue Line - Currently Proposed Development

Red Line - Approved Development

Section 3
Scale 1:100

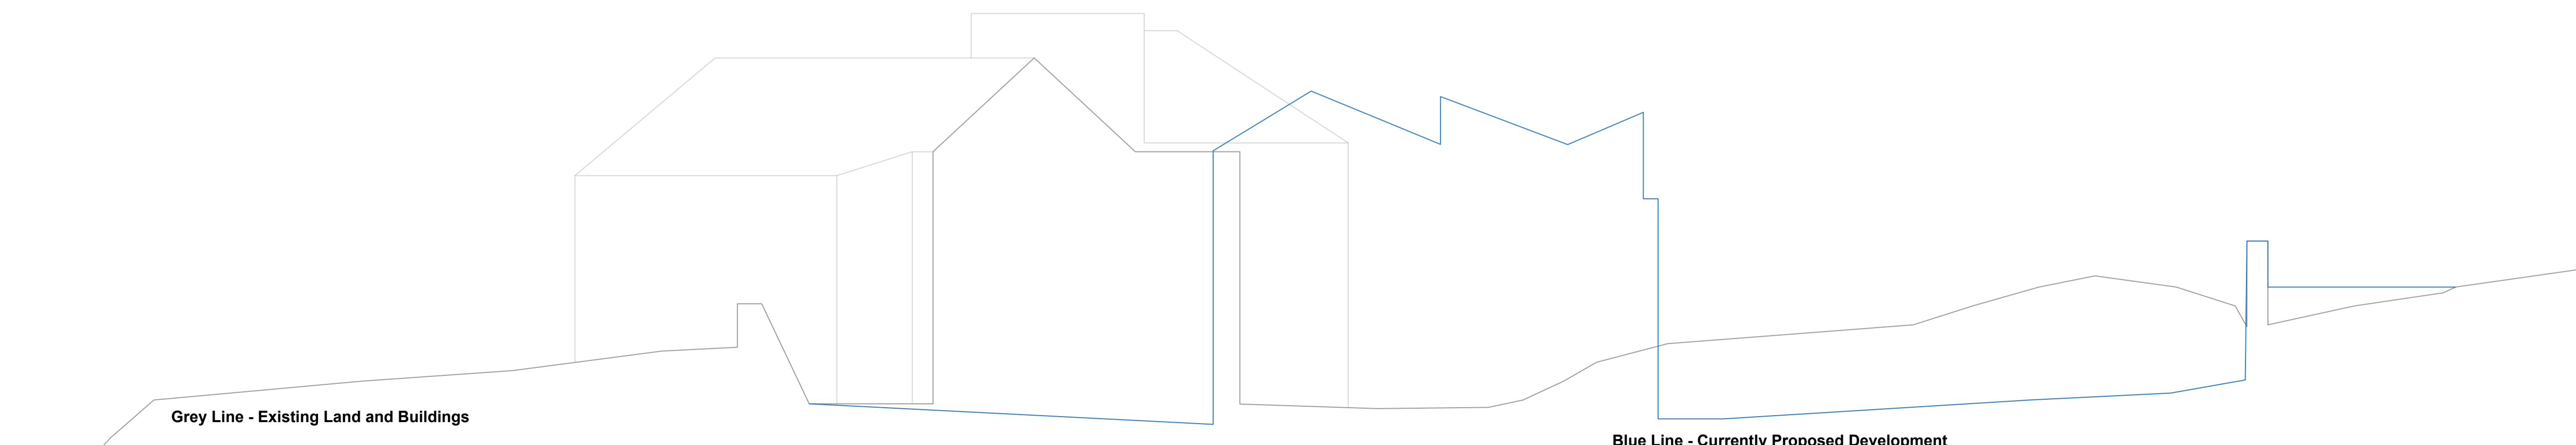

Grey Line - Existing Land and Buildings

Blue Line - Currently Proposed Development

P1	Drawn for comments	25.08.20	AM	GN
Issue	Description	Date	Drawn	Checked

Drawing Status
 P - Planning | T - Tender | C - Construction | R - As Record

For Approval

tadw architects 

Six St. Petersgate Stockport Cheshire SK1 1HD
 Ph 0161 477 6158 Fx 0161 480 8342 mail@tadw.co.uk www.tadw.co.uk

Client **Treville Properties Ltd.**

Job **Taxal Edge, Whaley Bridge**

Title **Site Sections**

Scale **1:100, 1:500 @ A1**

Note - Prints from PDF files may not be to scale, check accuracy against scale



Job Number 411179	Drawing Number 25	Issue P1
-----------------------------	-----------------------------	--------------------