

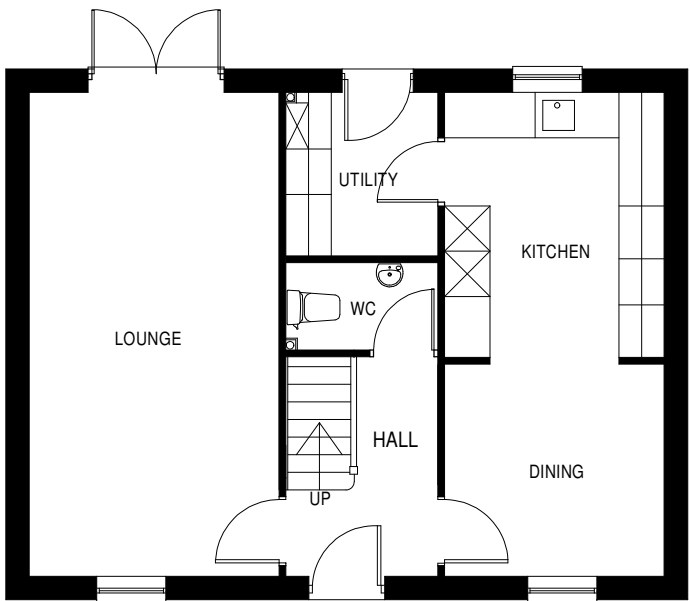


CWG3 / 4 BEDROOM DETACHED HOUSE 107.5 M2 / 1157 SQ FT GI

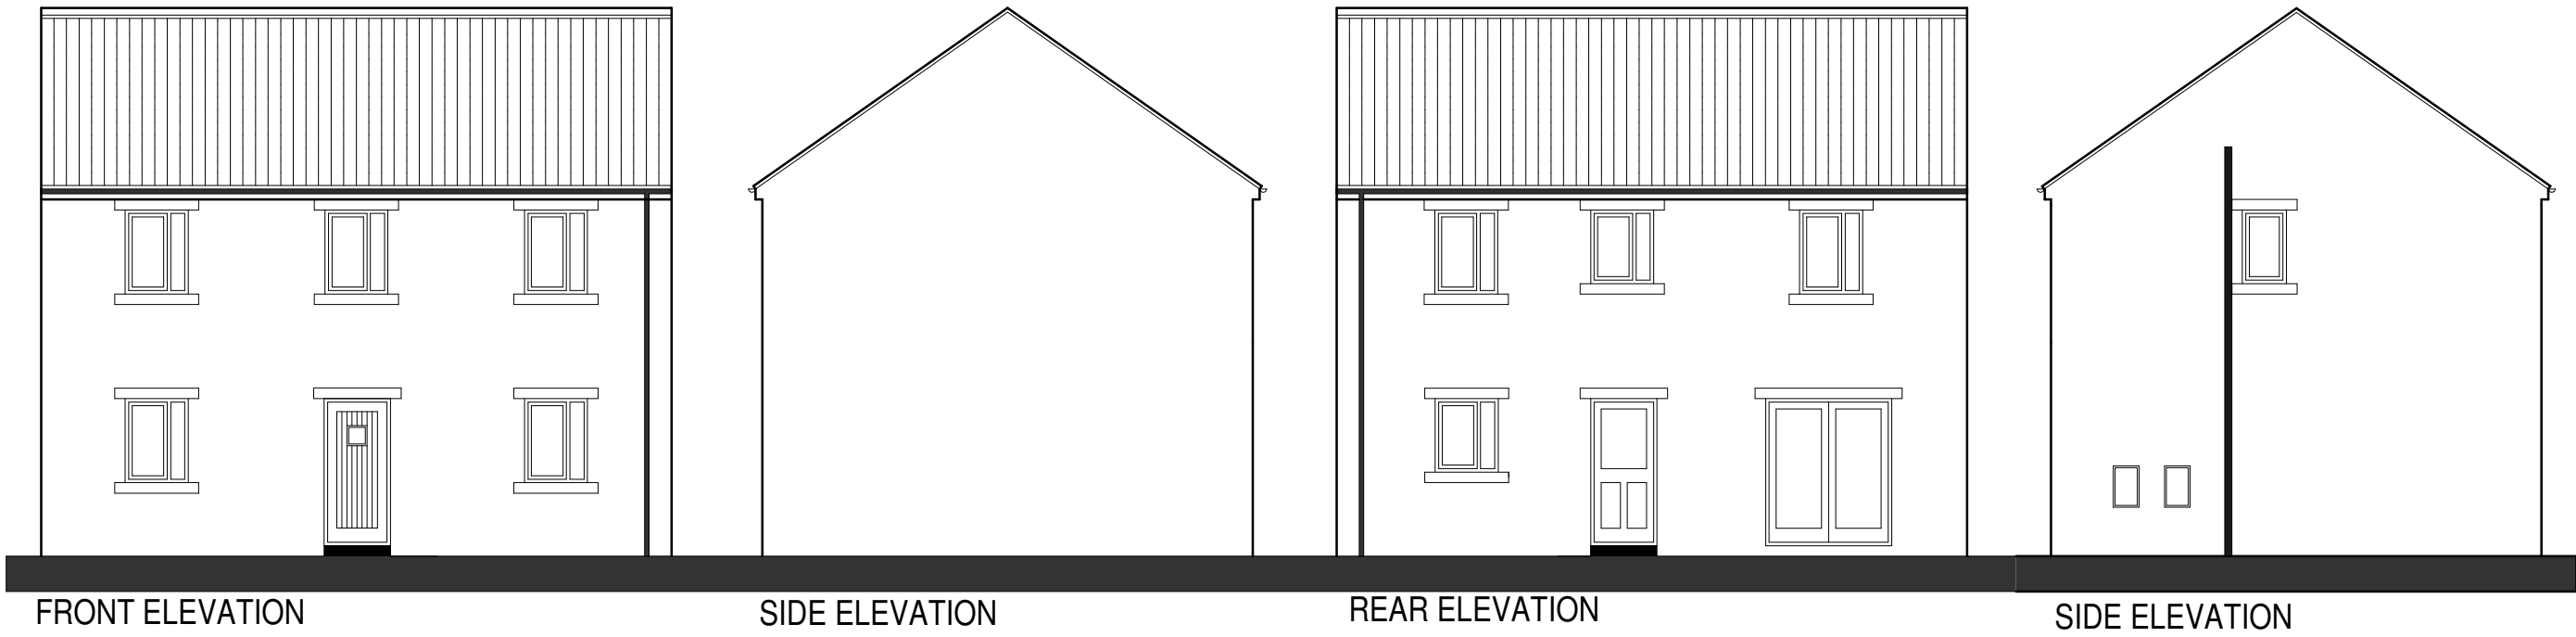

GROUND FLOOR PLAN.

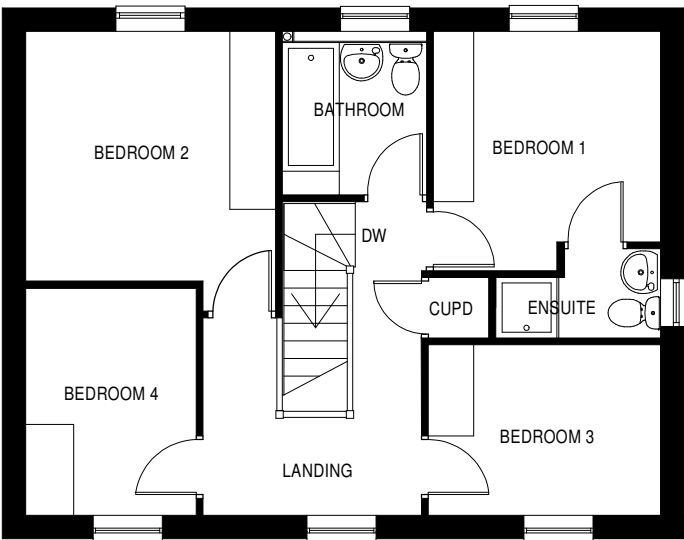

FIRST FLOOR PLAN.



REVISIONS

CLIENT
SHERWOOD HOMES

DRAWING TITLE
ASBUILT DRAWING CW3


PROJECT:
PROPOSED DEVELOPMENT AT
THE FORMER CHARLESTOWN WORKS
CHARLESTOWN ROAD
GLOSSOP

DRAWING No
018 / 07/ CW3 / AB

DRAWING DATE
DECEMBER 2018

DRAWN BY
IKB

SCALE
1:100 @A3

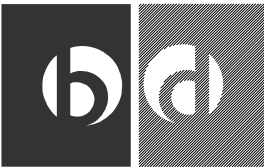

BARRATON
DESIGN STUDIO

BARRATON DESIGN STUDIO
UNIT 1
BRANCROFT FARM
BAWTRY ROAD
AUSTERFIELD
DONCASTER
SOUTH YORKSHIRE
DN10 6EZ
TEL: 01302 771188
EMAIL: ianbarraton30@gmail.com