


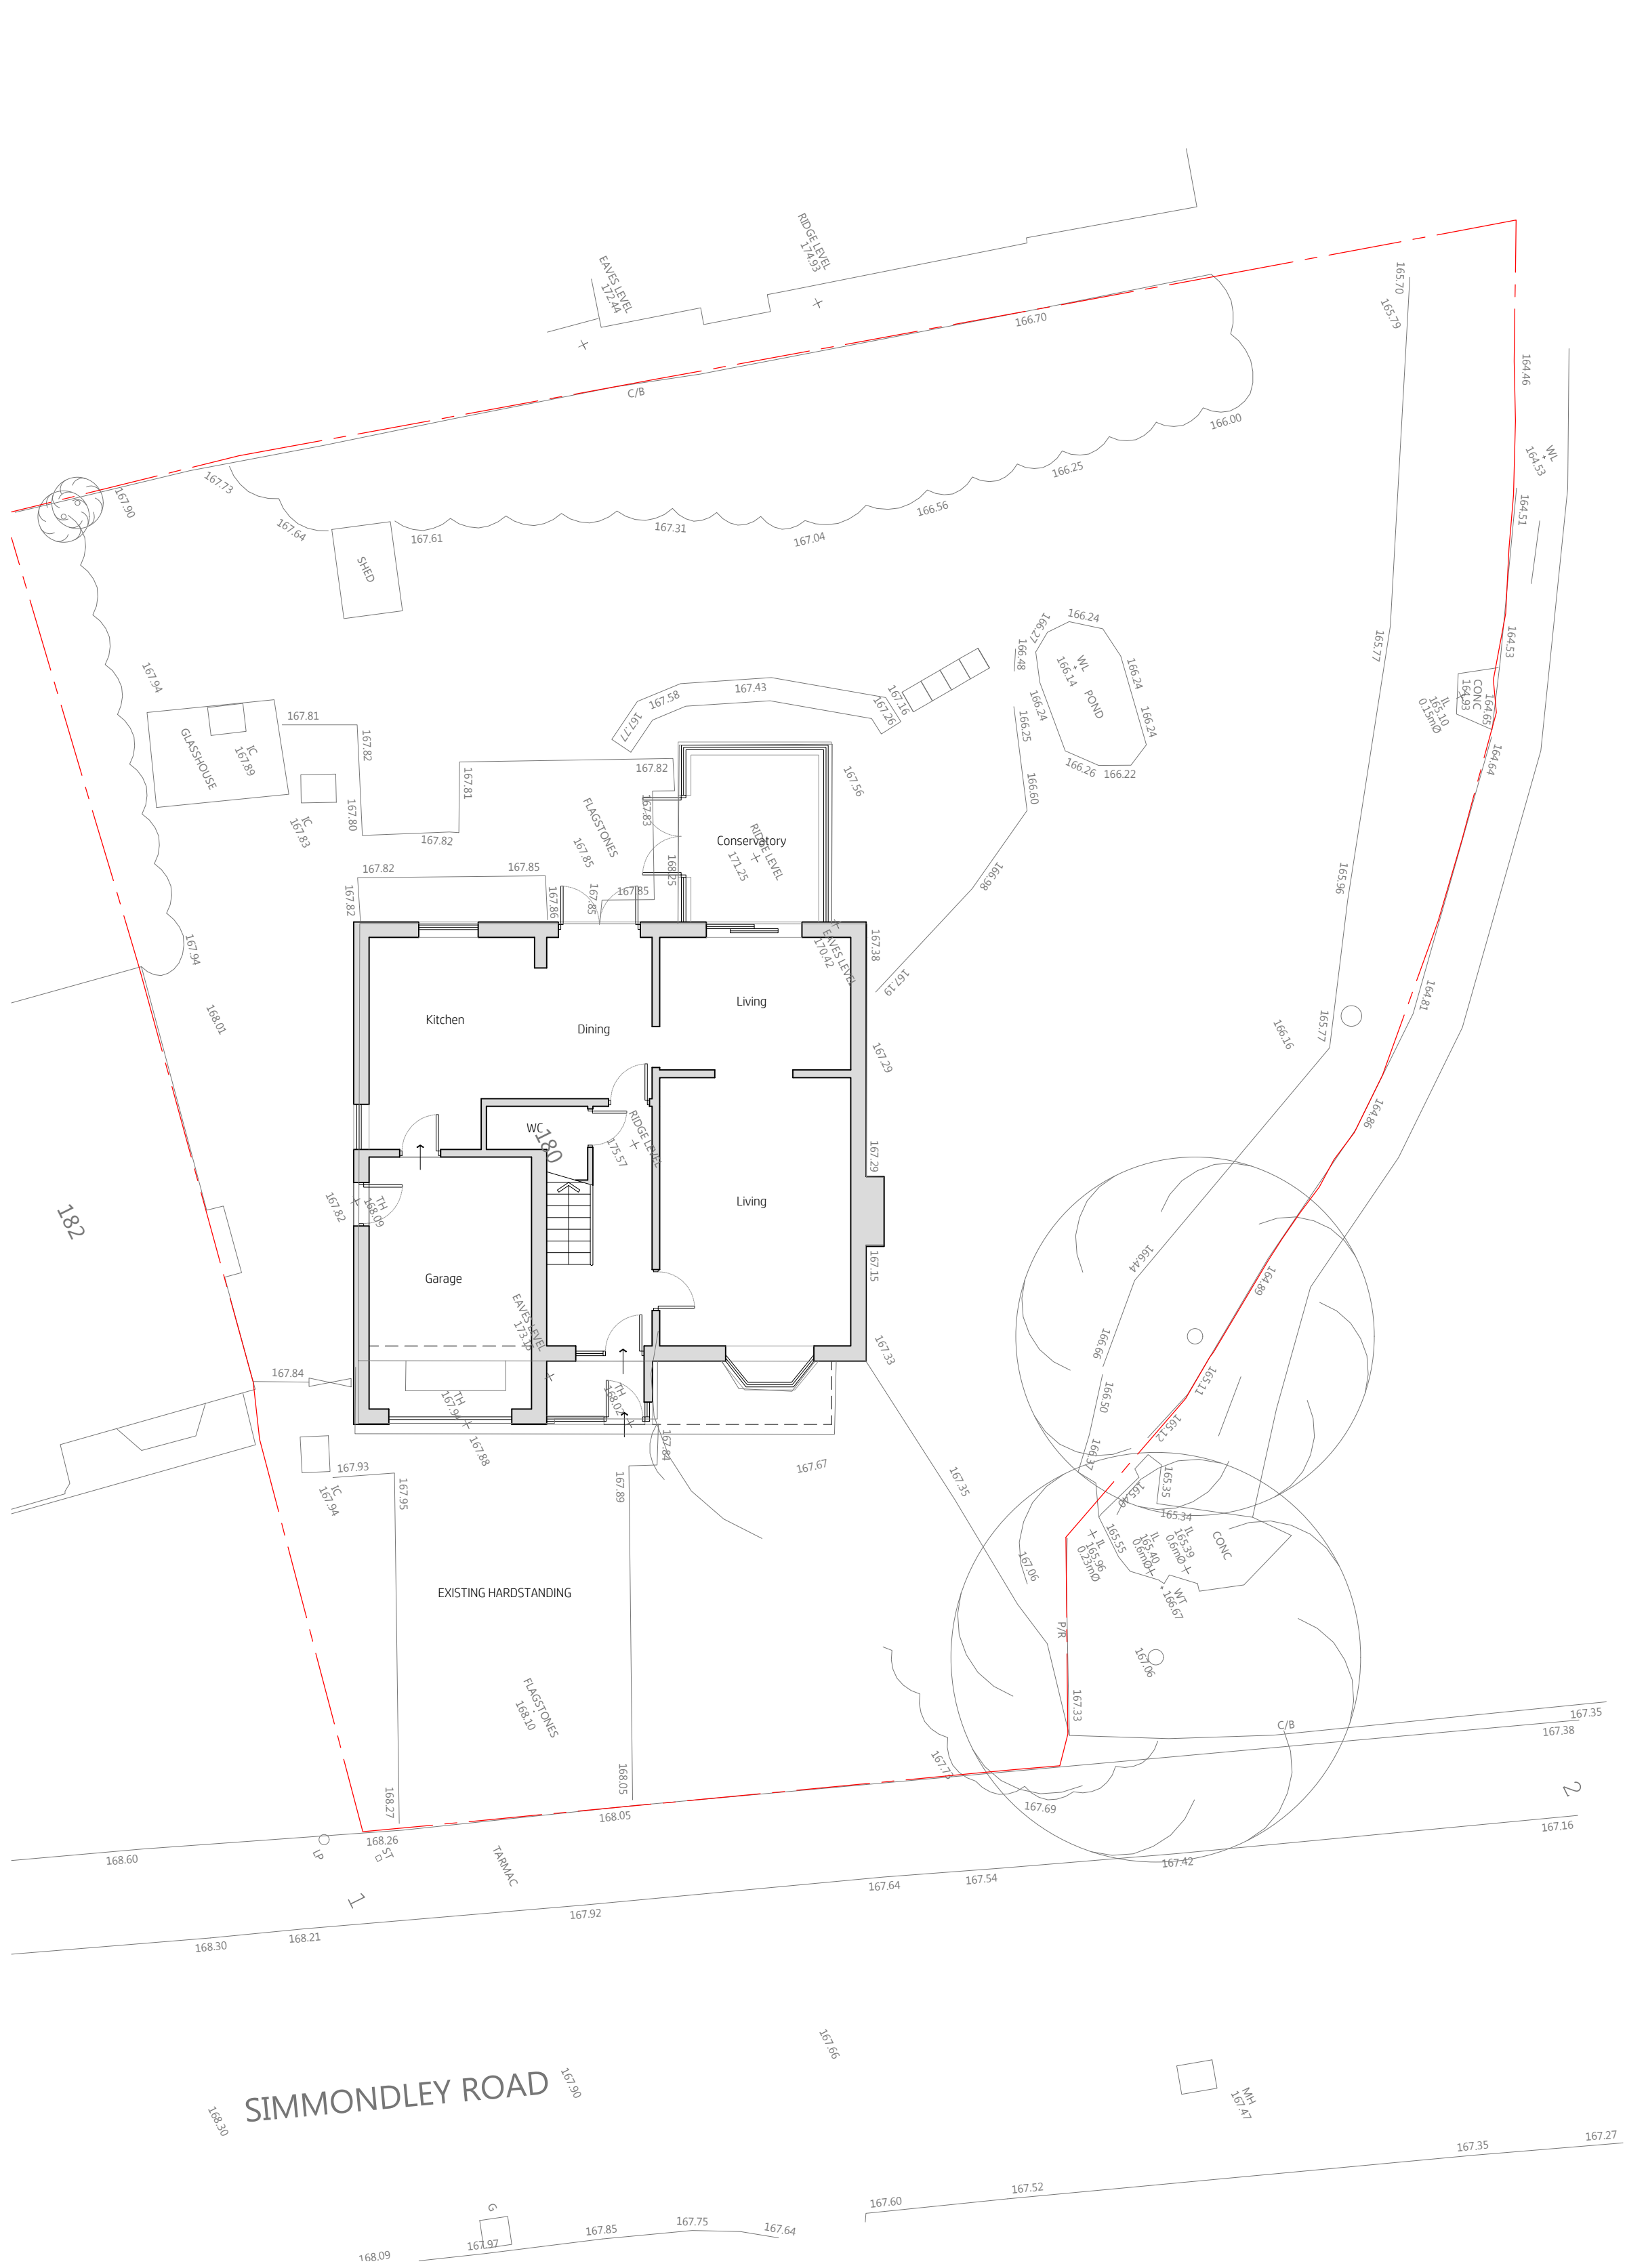
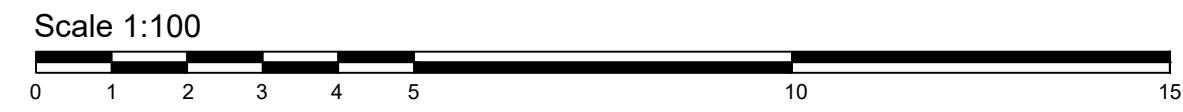


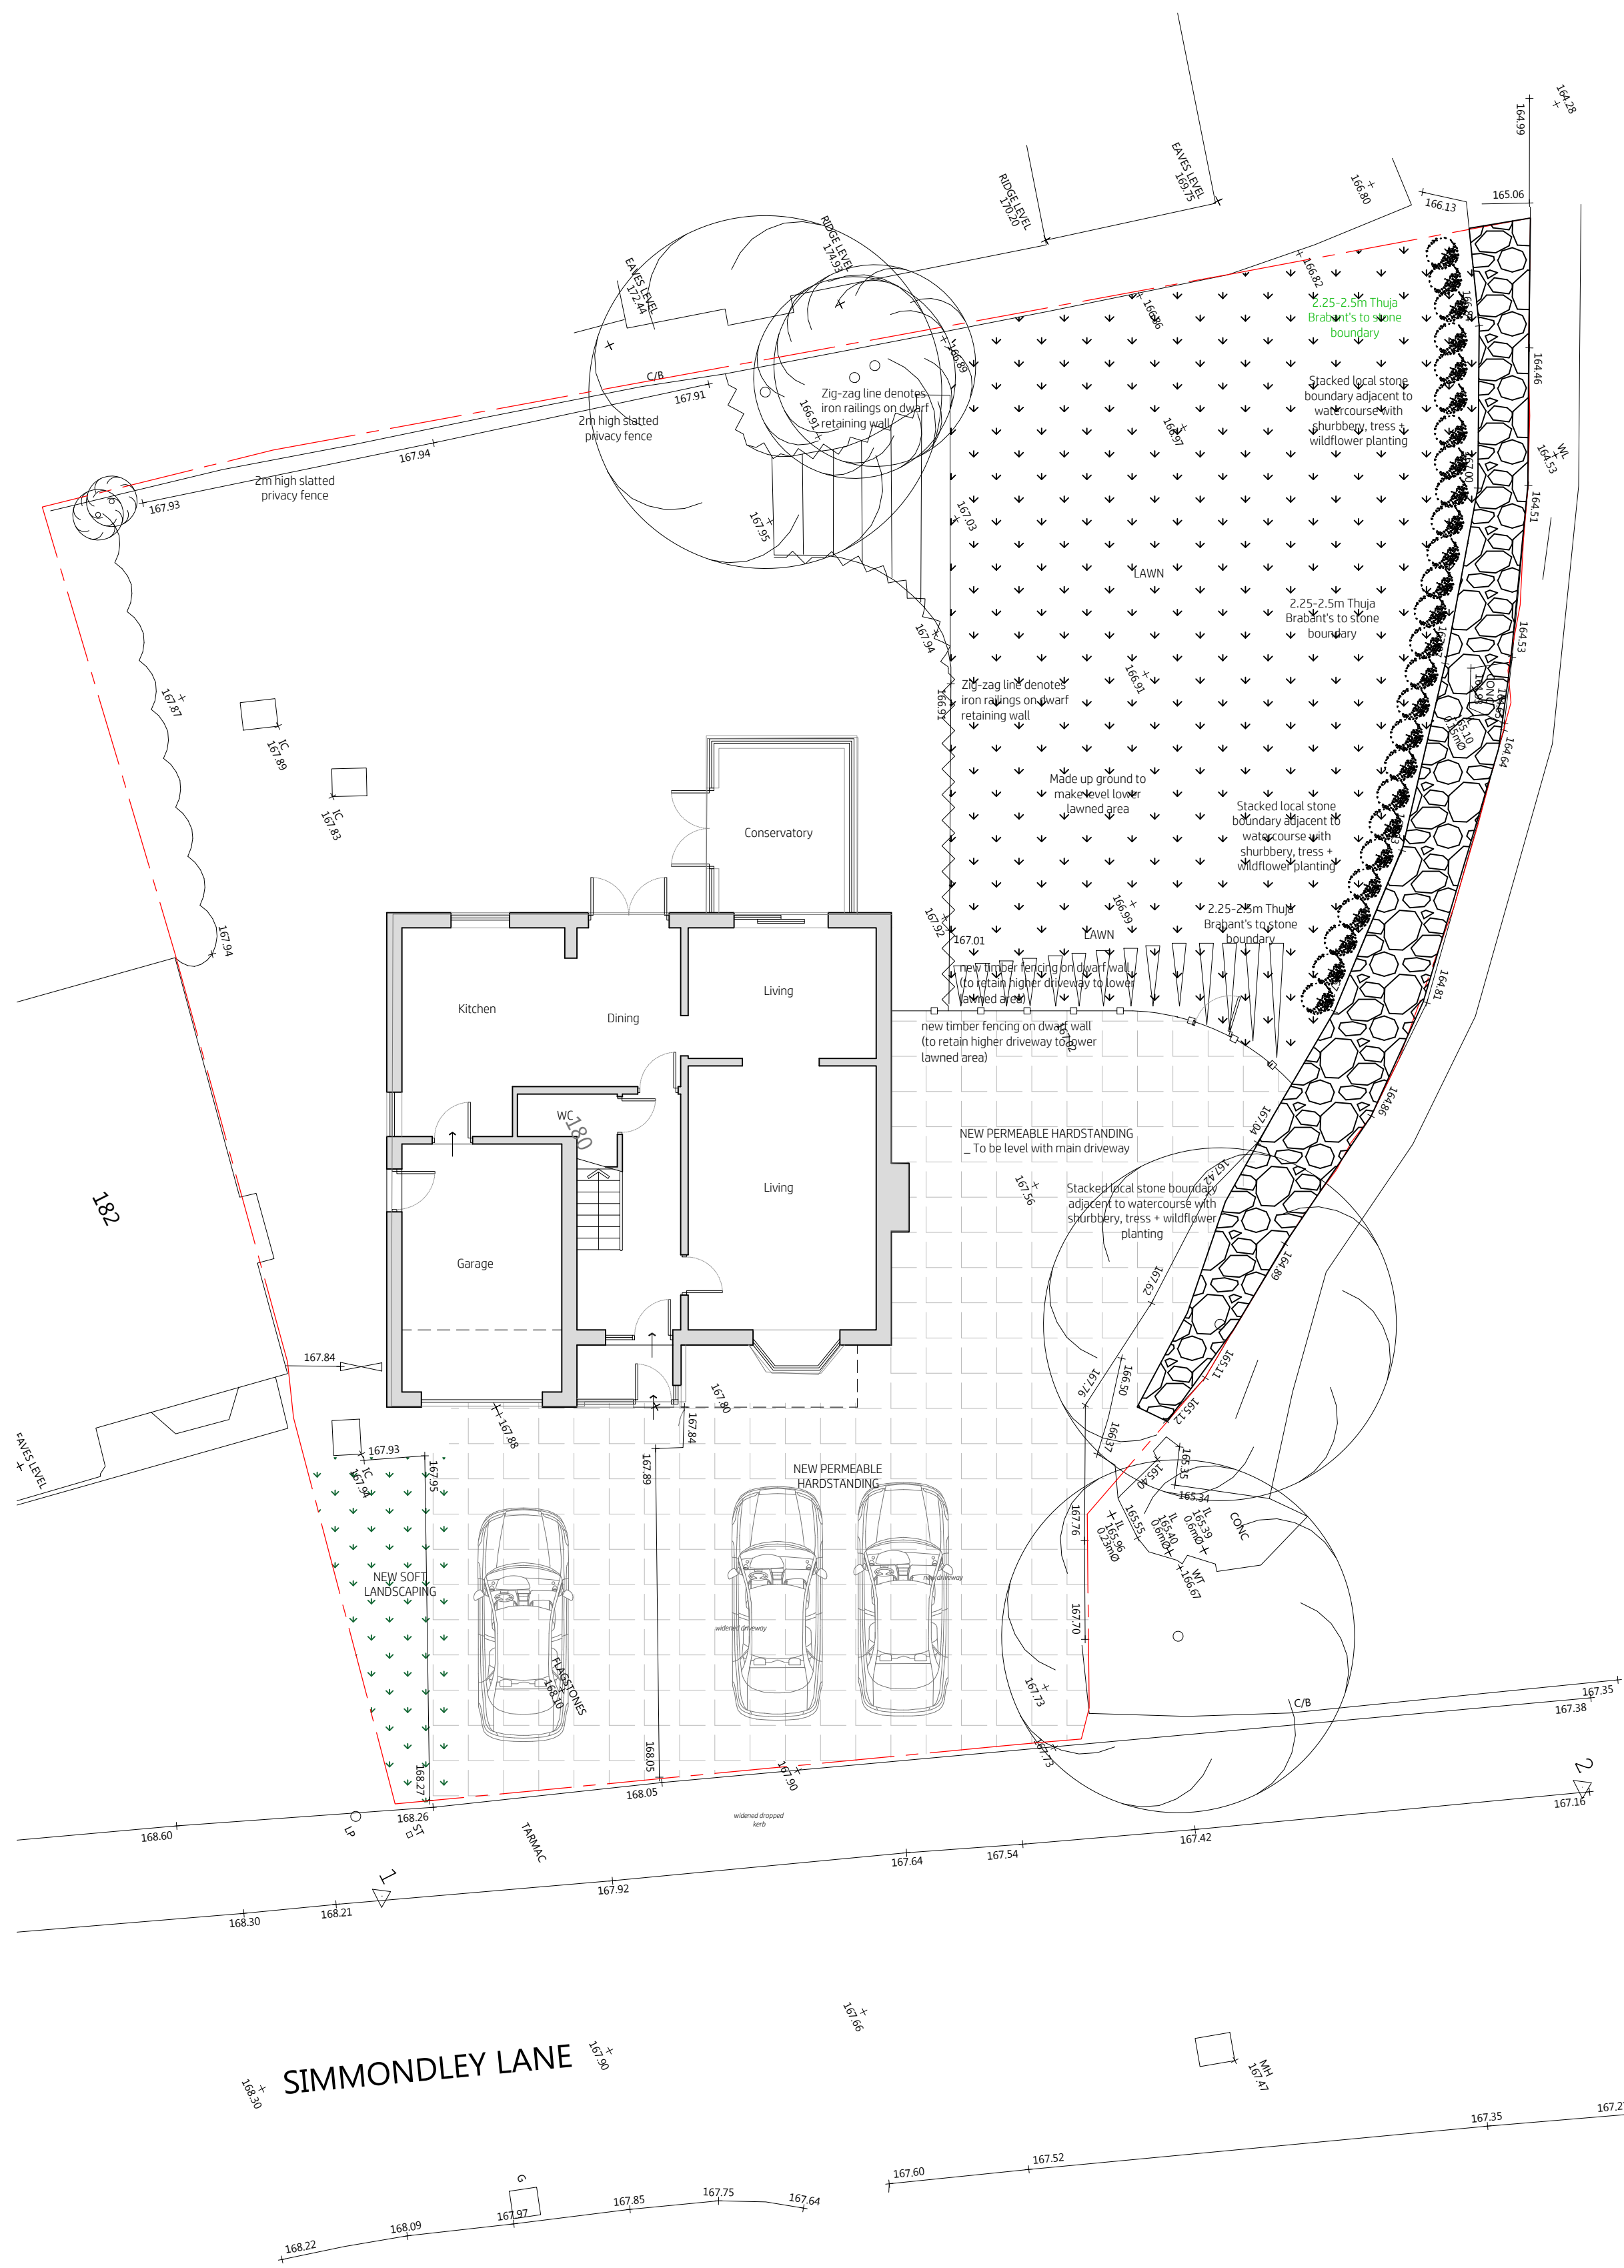


Existing Site Plan

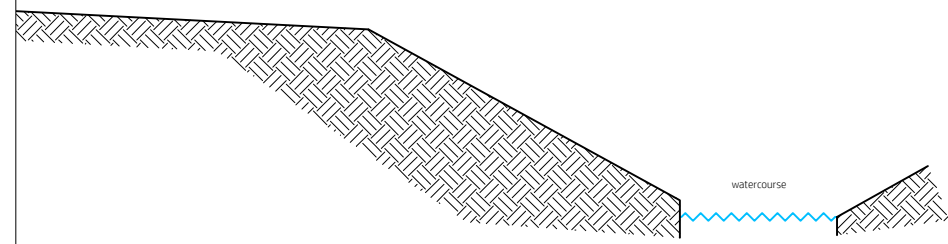

Proposed Site Plan

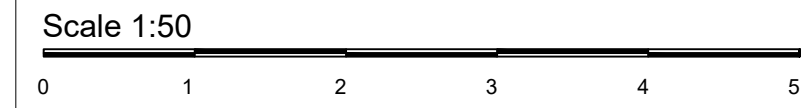

Existing Typical Section

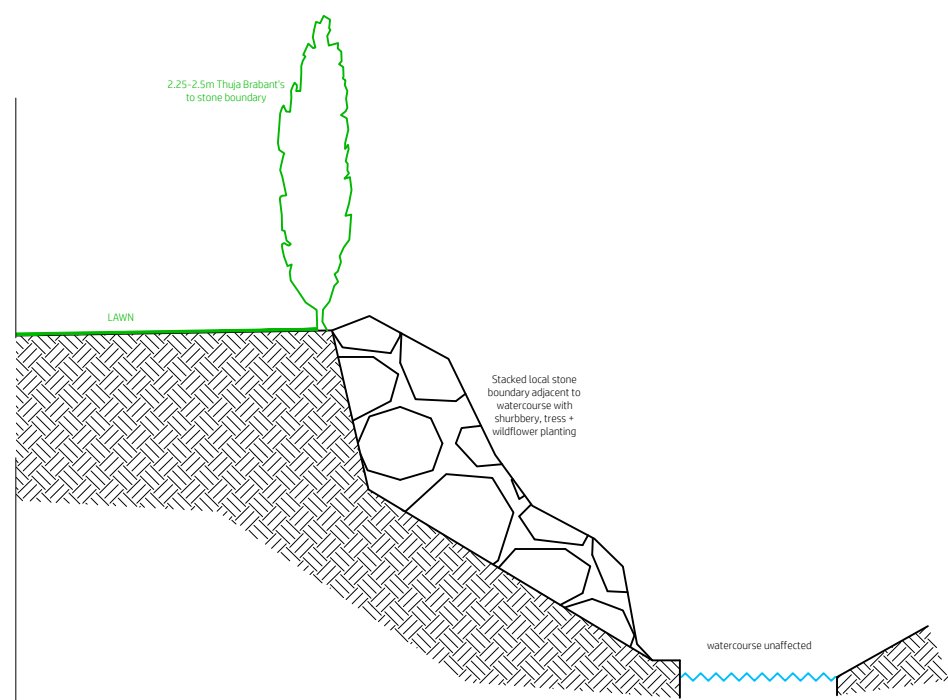

Proposed Typical Section

project		
180 Simmondley Lane Glossop SK13 6LY		
scale		
1:100@A1	drawn by	klh
1:200@A3	drawing number	KH445-200
revision	description	date
A	updated to latest comments incl. garage + reflect as built	26.09.2023
B	landscape notes added	16.10.2023
C	noted new driveway level and retaining wall drop down to lawn	09.11.2023
D	typical sections added	17.11.2023
E	updated to suit validation comments	05.12.2023
		17.12.2023

Site Plans

kieranhibbsarchitecture
27 Pioneer Road
Macclesfield
SK11 7ZB

kieranhibbs@gmail.com
Mobile: 07584049322

kieranhibbsarchitecture