


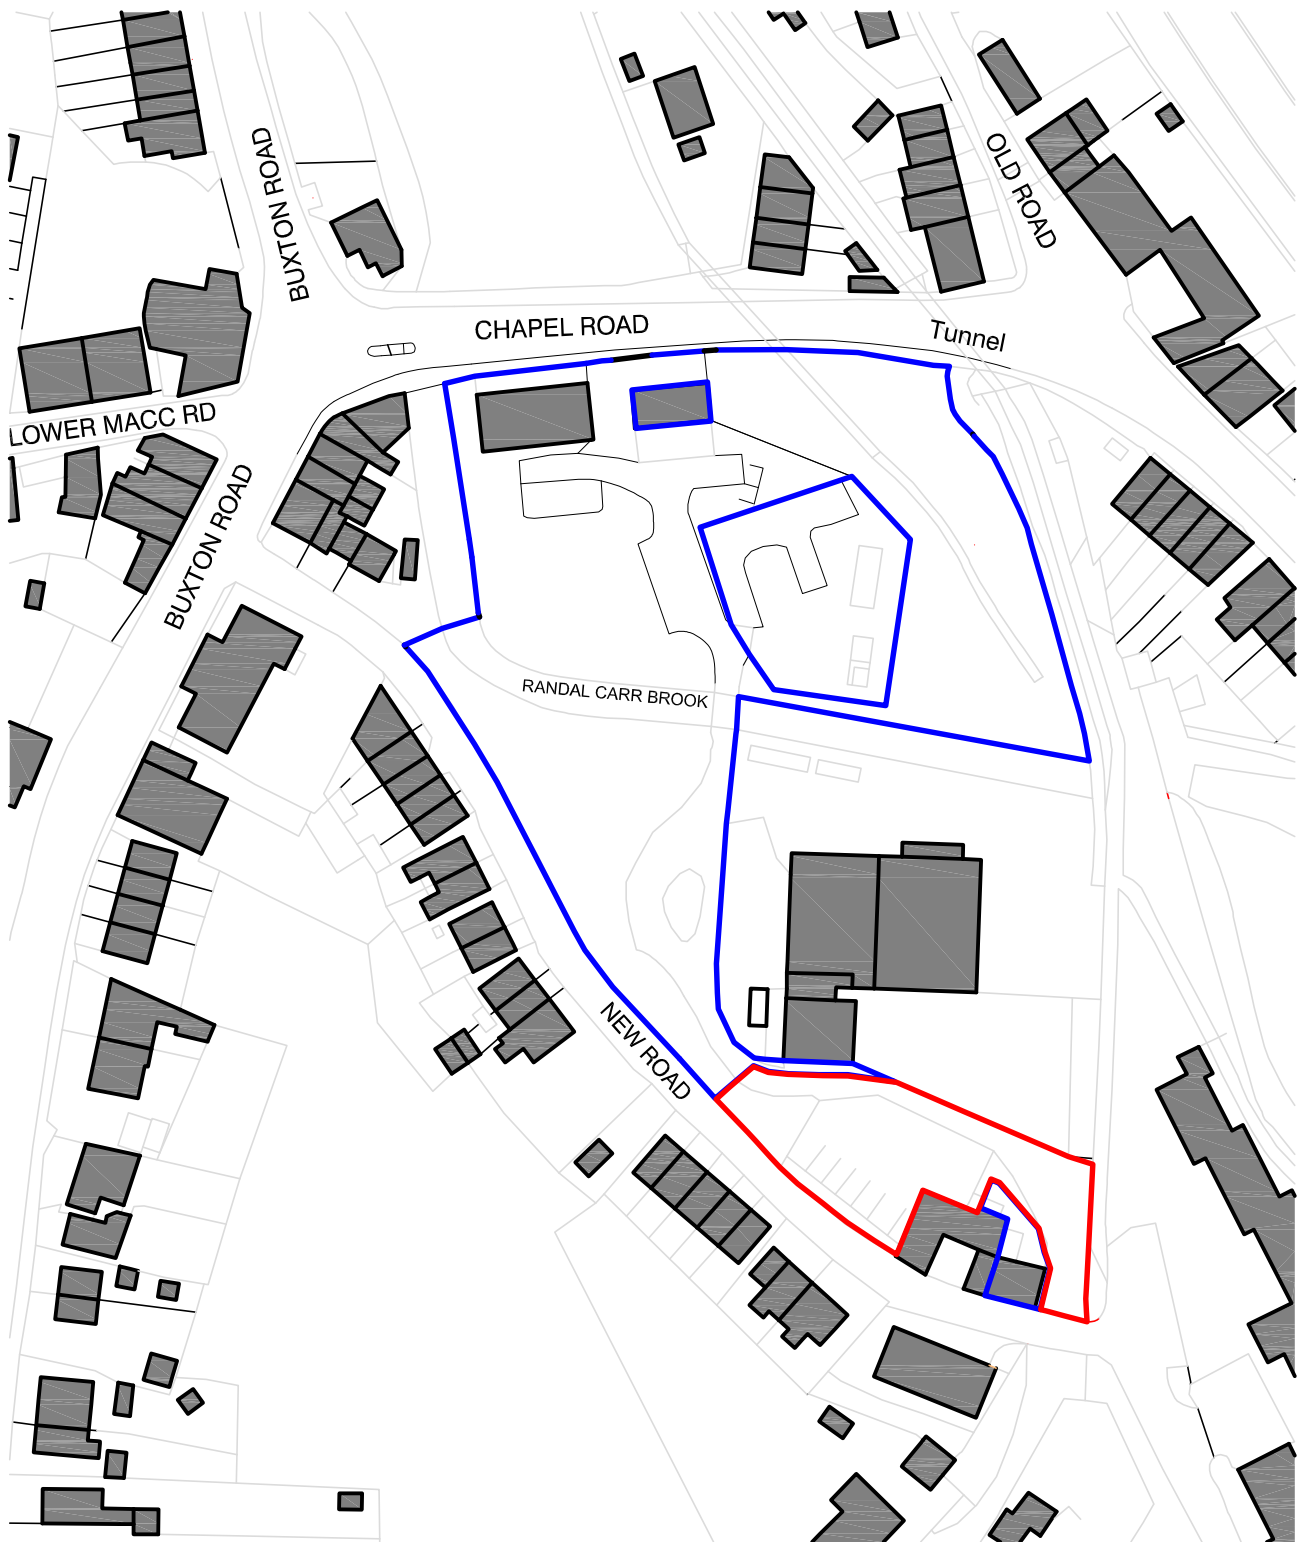

REV A March 2024 Redline amended

North



HIGH PEAK ARCHITECTS LTD

2nd Floor, Wharf House, Wharf Road, Whaley Bridge, High Peak, Derbys SK23 7AD
Tel: 01663 719717 Website: highpeakarch.com Email: hpa@highpeakarch.com

Residential Development
New Road, Whaley Bridge

Site Location Plan

1892.PL01

Scale: 1:1250

Date: September 2023

Rev: A