


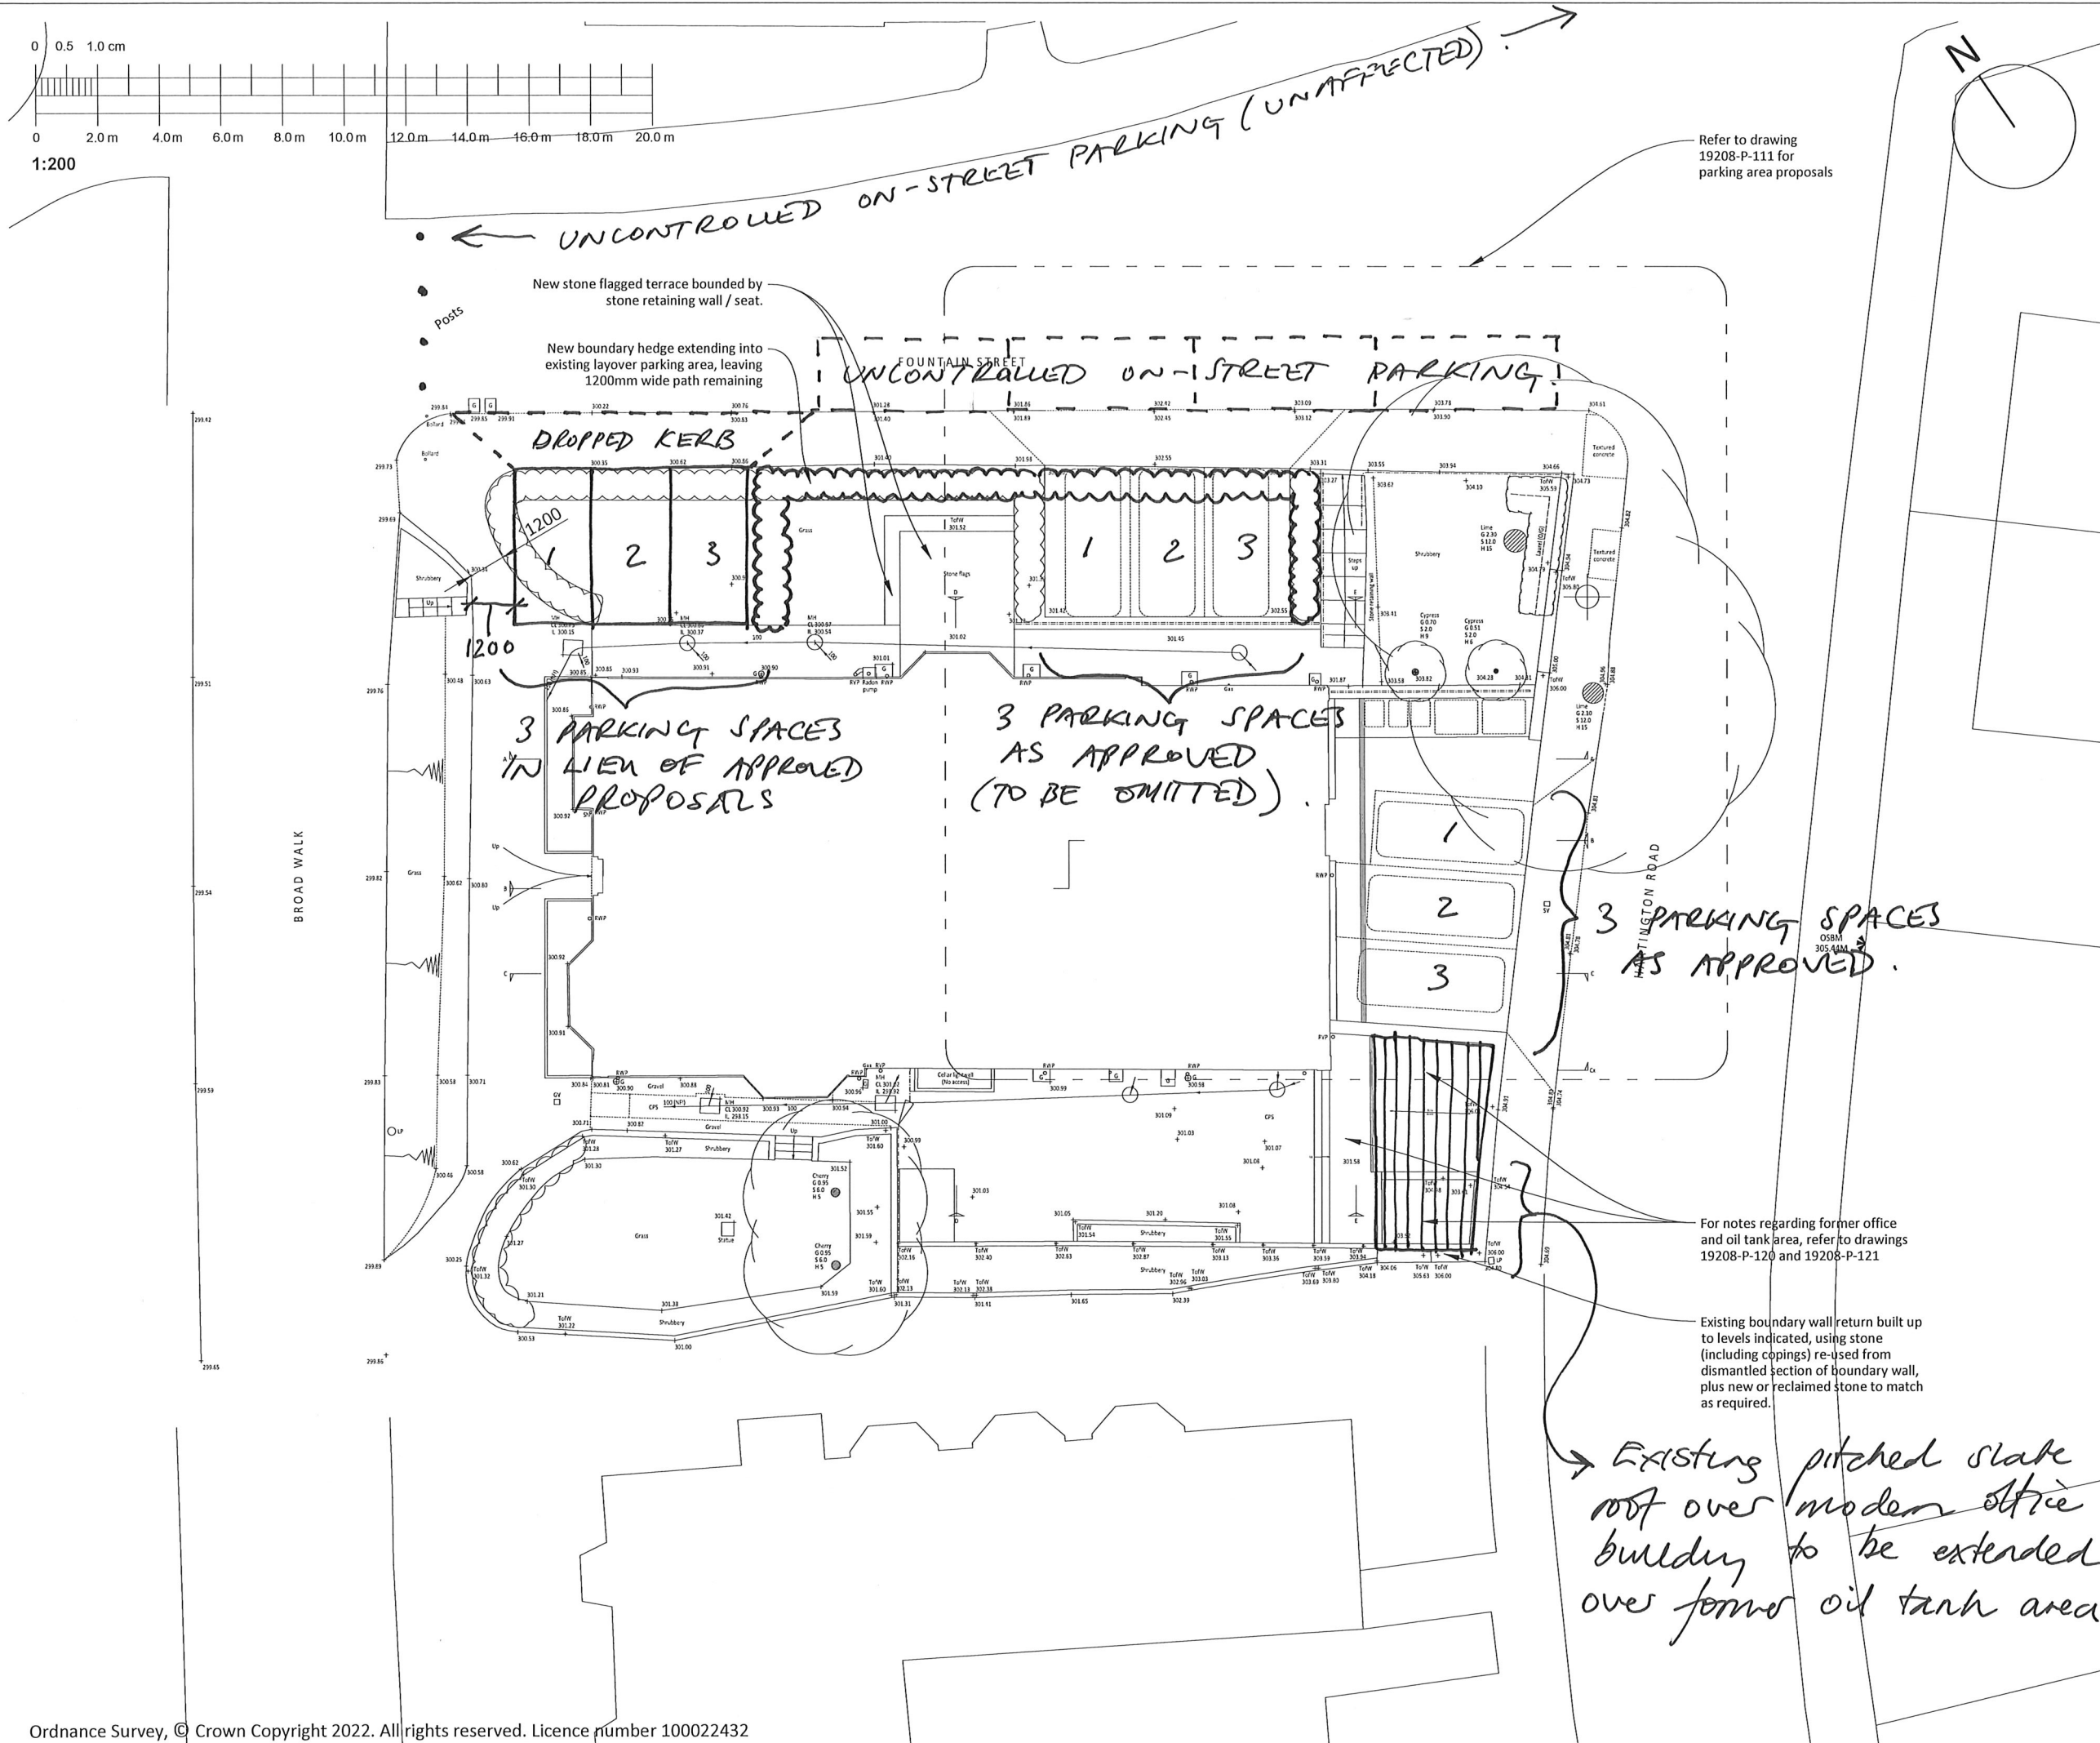

BENCH
ARCHITECTS

23 TERRACE ROAD
BUXTON
DERBYSHIRE
SK17 6DU
TEL: 01298-23991
info@bencharchitects.co.uk

ARCHITECTURE
HISTORIC BUILDING REPAIR
THE AUTHENTIC INTERIOR

PROJECT:
Derby House
12 Broad Walk
Buxton
Derbyshire SK17 6JS

CLIENT:
SVBS Construction Ltd

SUBJECT:
PROPOSED DRAWING
SITE PLAN

PRELIMINARY

DRAWING NO:
19208-P-110 ~~Rev A~~ /SK02

DATE: 27.06.2024
~~September 2022~~

Revisions:
~~A: Parking deck updated~~
~~22.02.2023~~

SCALE:
1:200 @ A3

©This drawing and the building works depicted are the copyright of the Architect and may not be reproduced without written permission.