

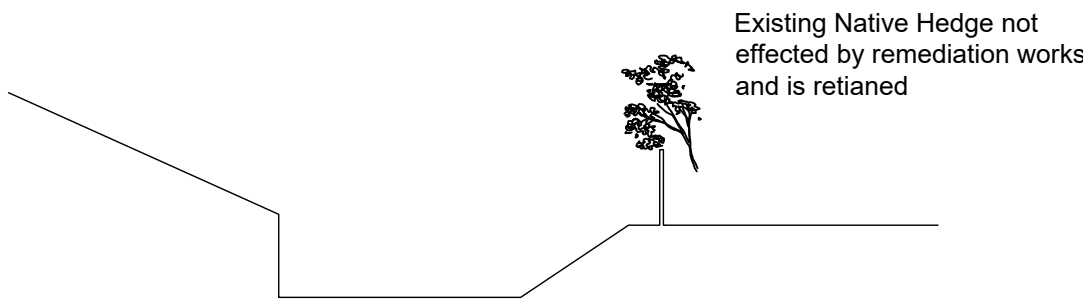
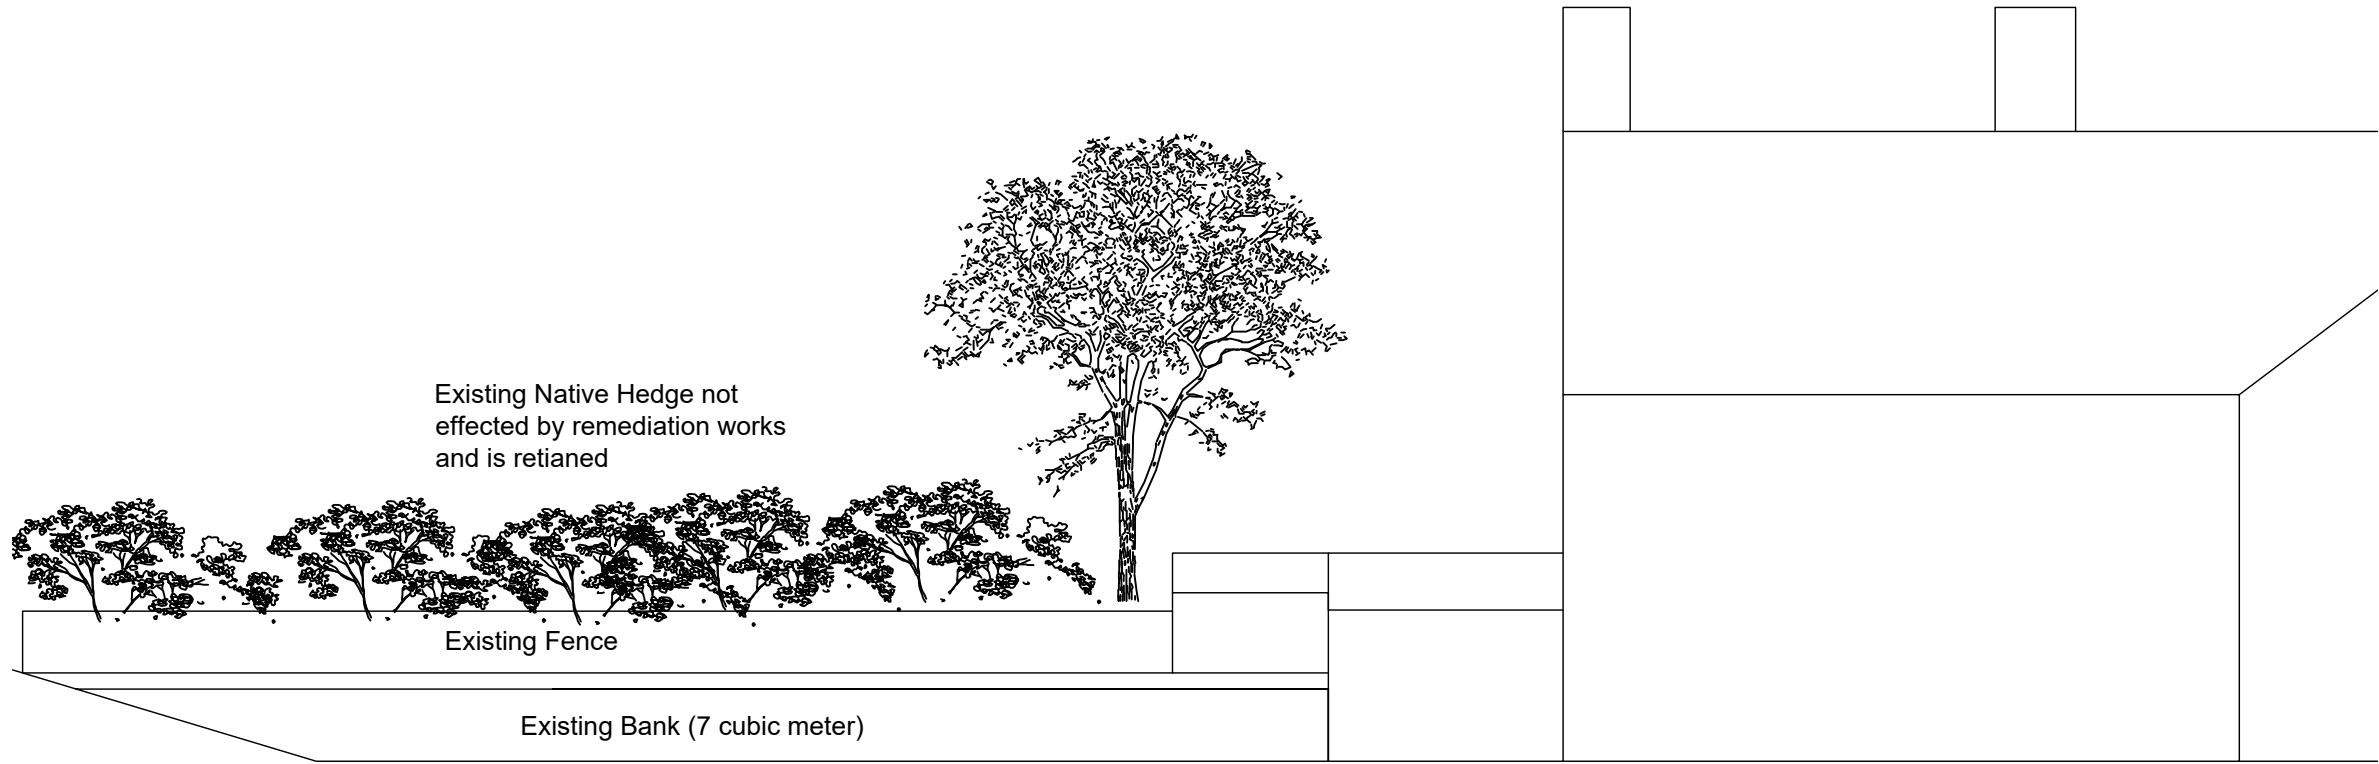
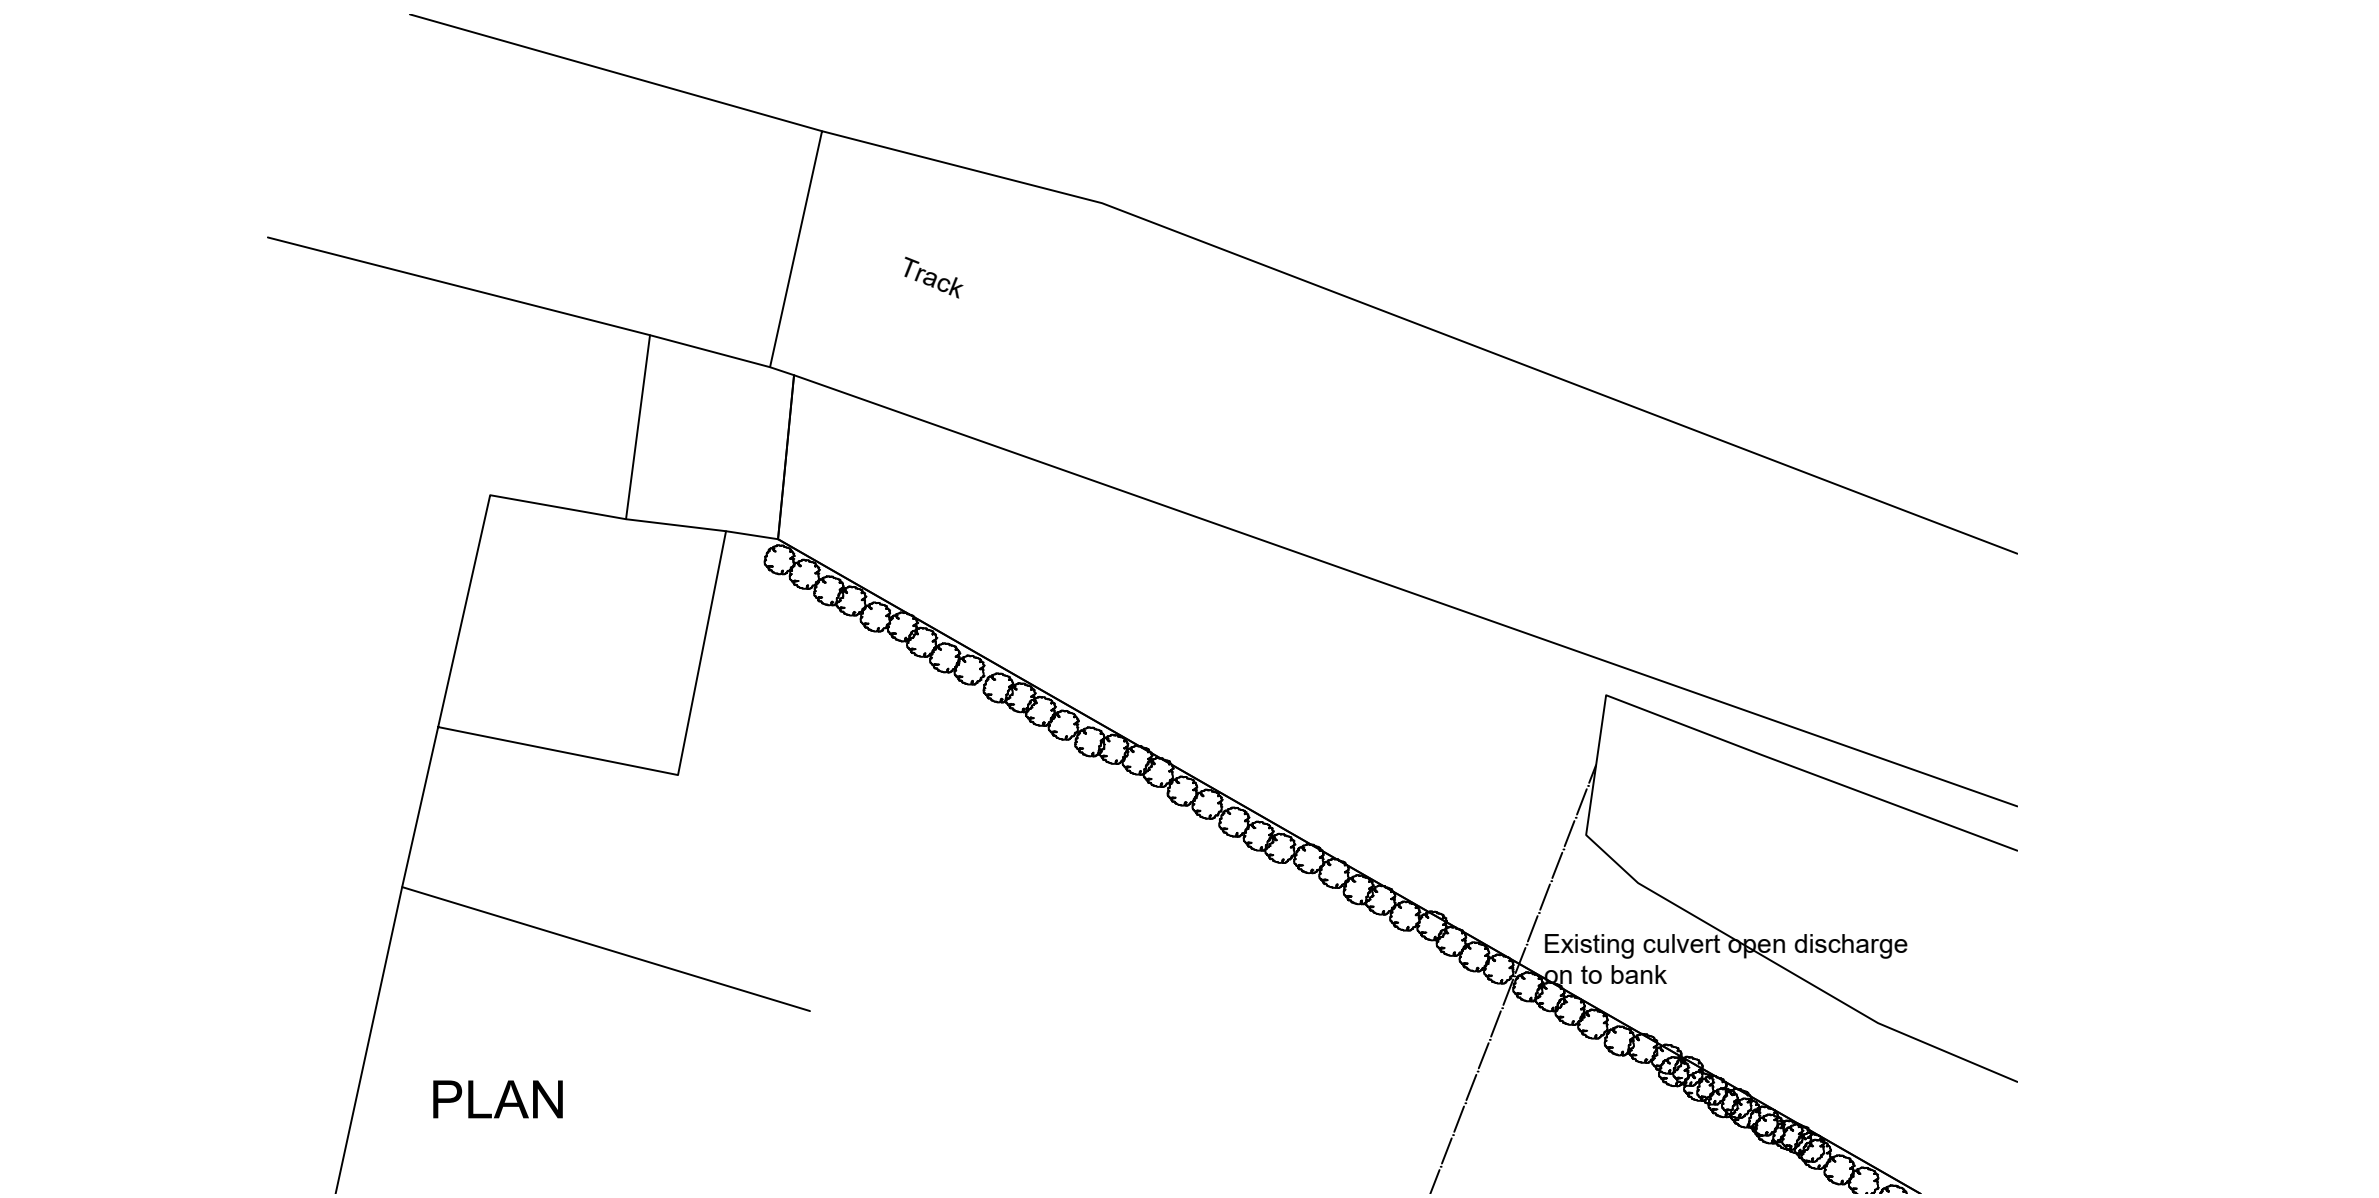
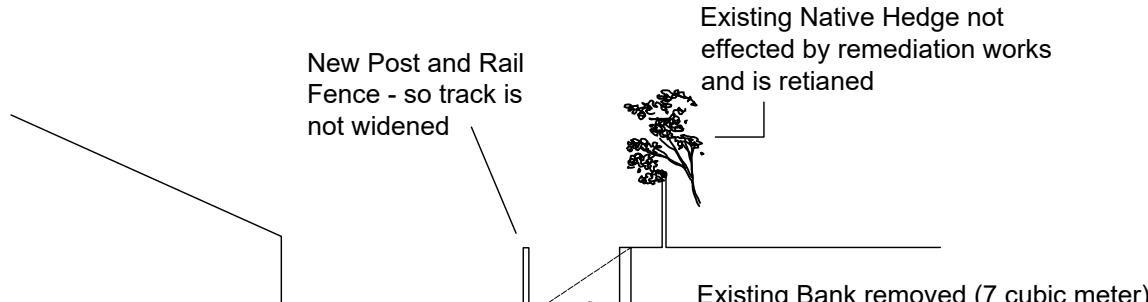



AS PREVIOUS

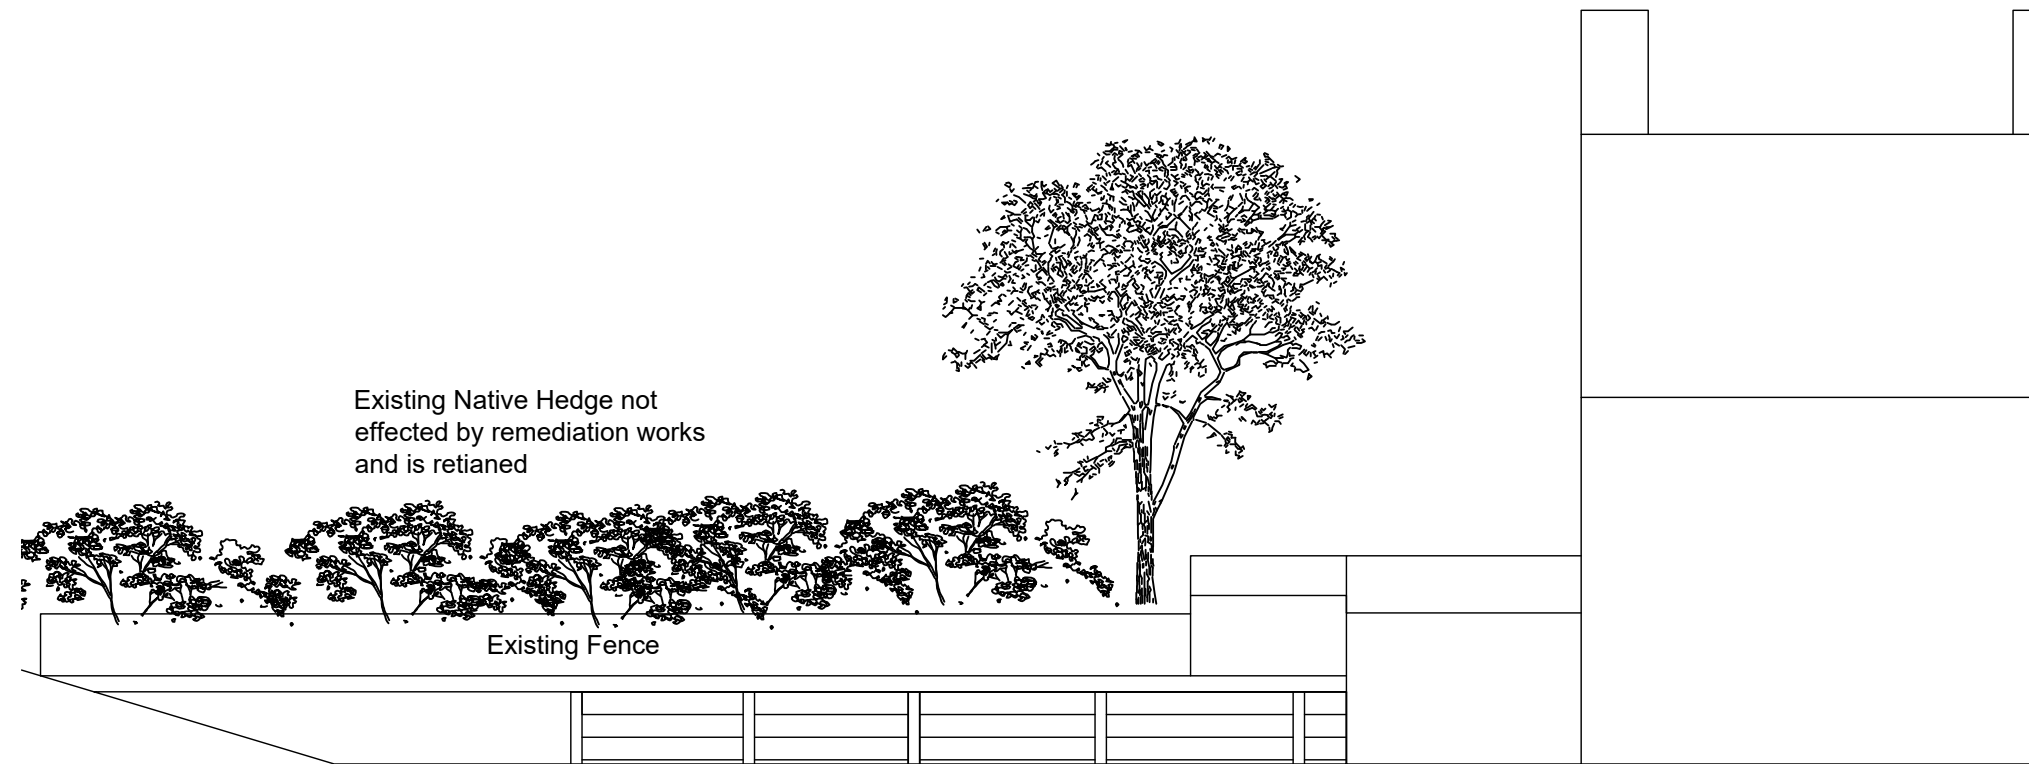

AS BUILT

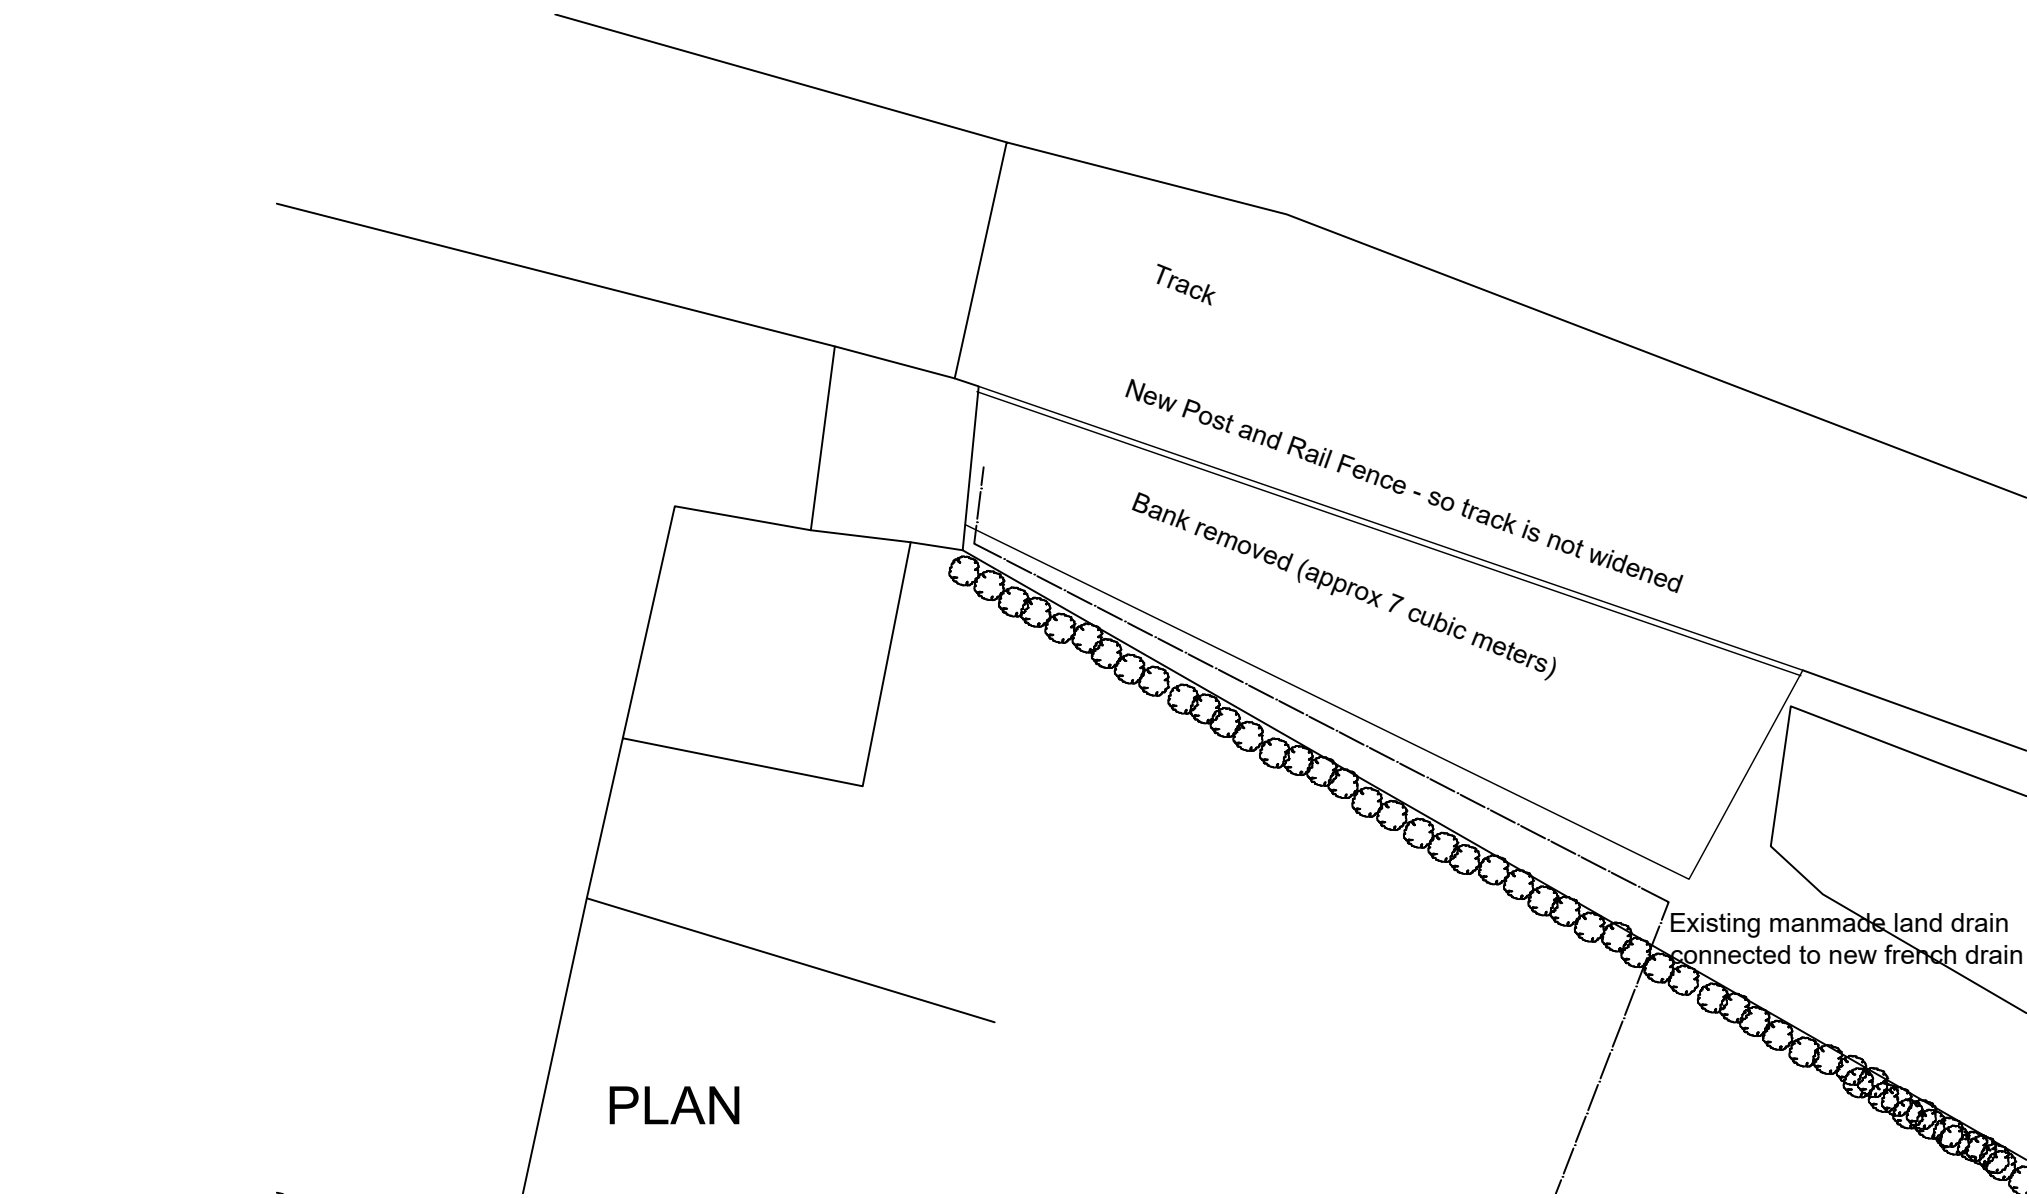

ALL DIMENSIONS TO BE CHECKED ON SITE
IF IN DOUBT - ASK AAL
NO WORK TO COMMENCE ON SITE PRIOR TO
PLANNING CONSENT BEING OBTAINED AND
BUILDING REGULATIONS APPROVED
COPYRIGHT
NOT TO BE REPRODUCED WITHOUT THE
WRITTEN AUTHORITY OF AAL

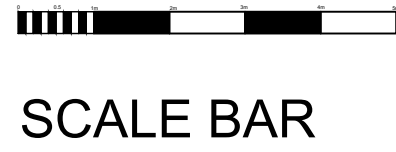

A Notation added re post and rail fence 30/3/26
HIGH PEAK
17 BACK LANE
CHARLESWORTH

RETROSPECTIVE APPLICATION FOR
MR & MRS D THOMPSON

PLANS & ELEVATIONS

AS PREVIOUS & AS BUILT

2606 01 a 1:100 @ A1 MAR 2026



Alderley Architecture Limited
Ridge Farm
79 The Ridge
Marple
Stockport
SK6 7ER
Tel : 07785 230069
E Mail : andy@alderleyarchitecture.co.uk