




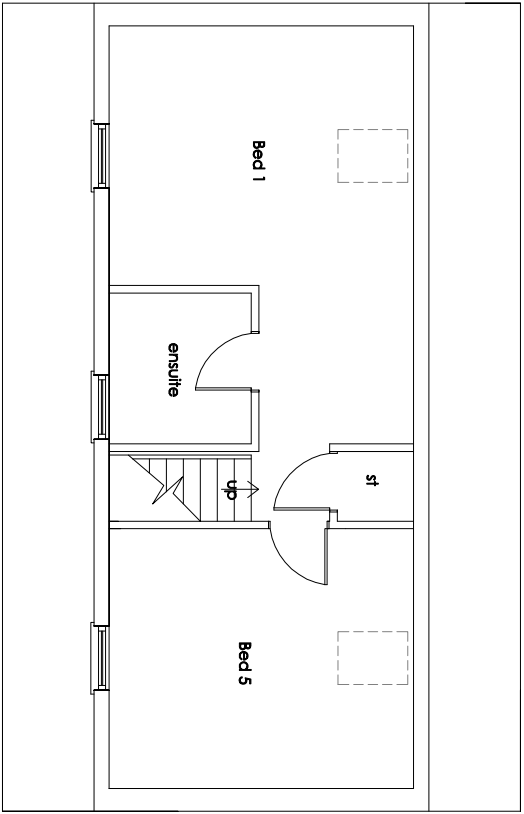


Original Second Floor Plan

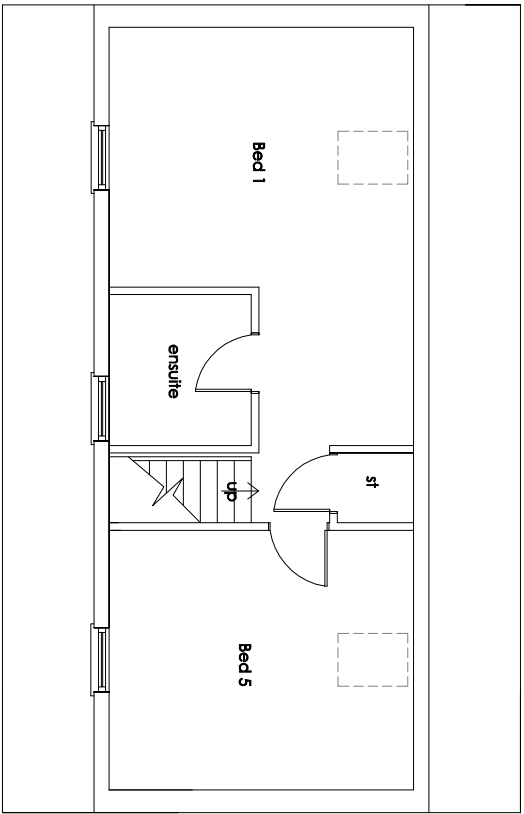


As-built Second Floor Plan

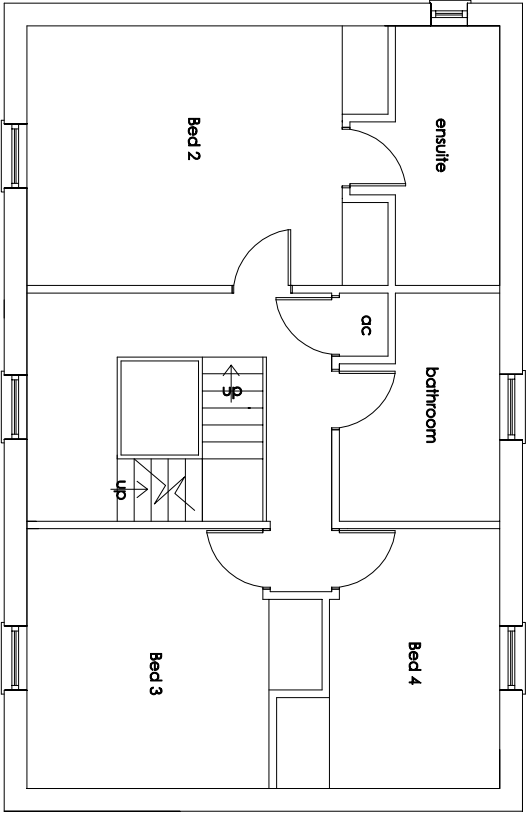


Original First Floor Plan

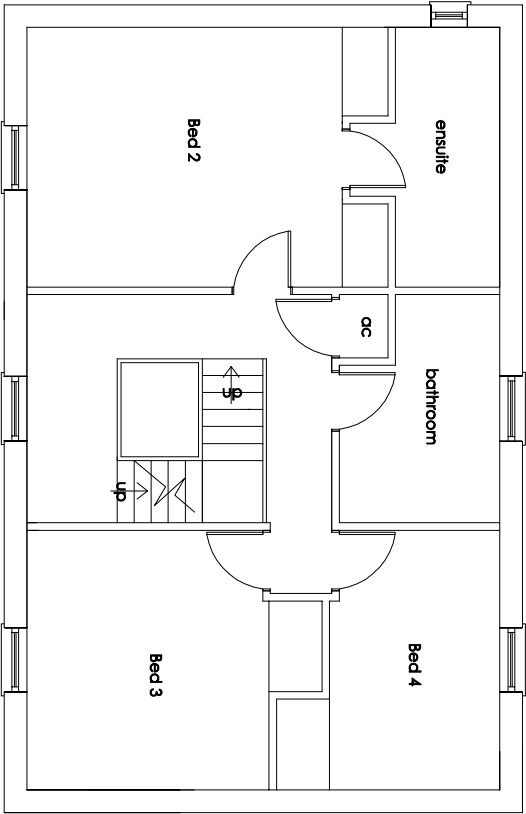

As-built First Floor Plan

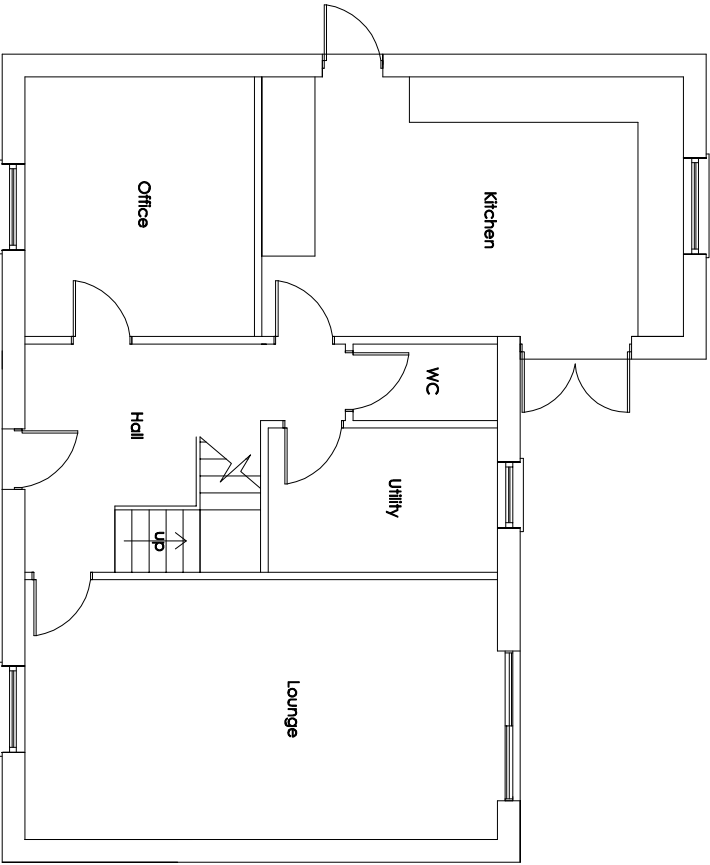

Original Ground Floor Plan

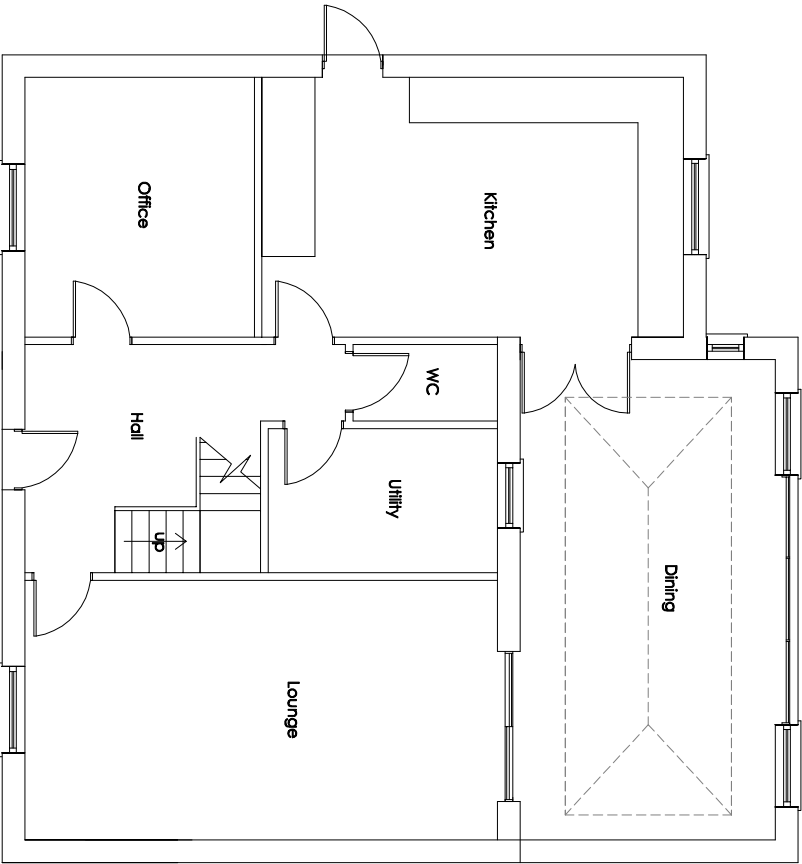

As-built Ground Floor Plan

REVISIONS			
NO.	DESCRIPTION	DATE	BY
1	FW	1:100@A3	AREA
2	DATE	NOV 26	SQA
3	PROJECT	Retrospective application for a single storey rear garden room extension at 35 Hogshaw Drive, Buxton	DATE
4	CLIENT	Mr. C. Smith	BY
5	TITLE	Existing and Proposed Plans	DATE
Wylie Architecture Residential Architecture Design and Planning 01783 552620 www.wyliearchitecture.co.uk			
6	DRAWING NUMBER	03.01	REV
7			-