




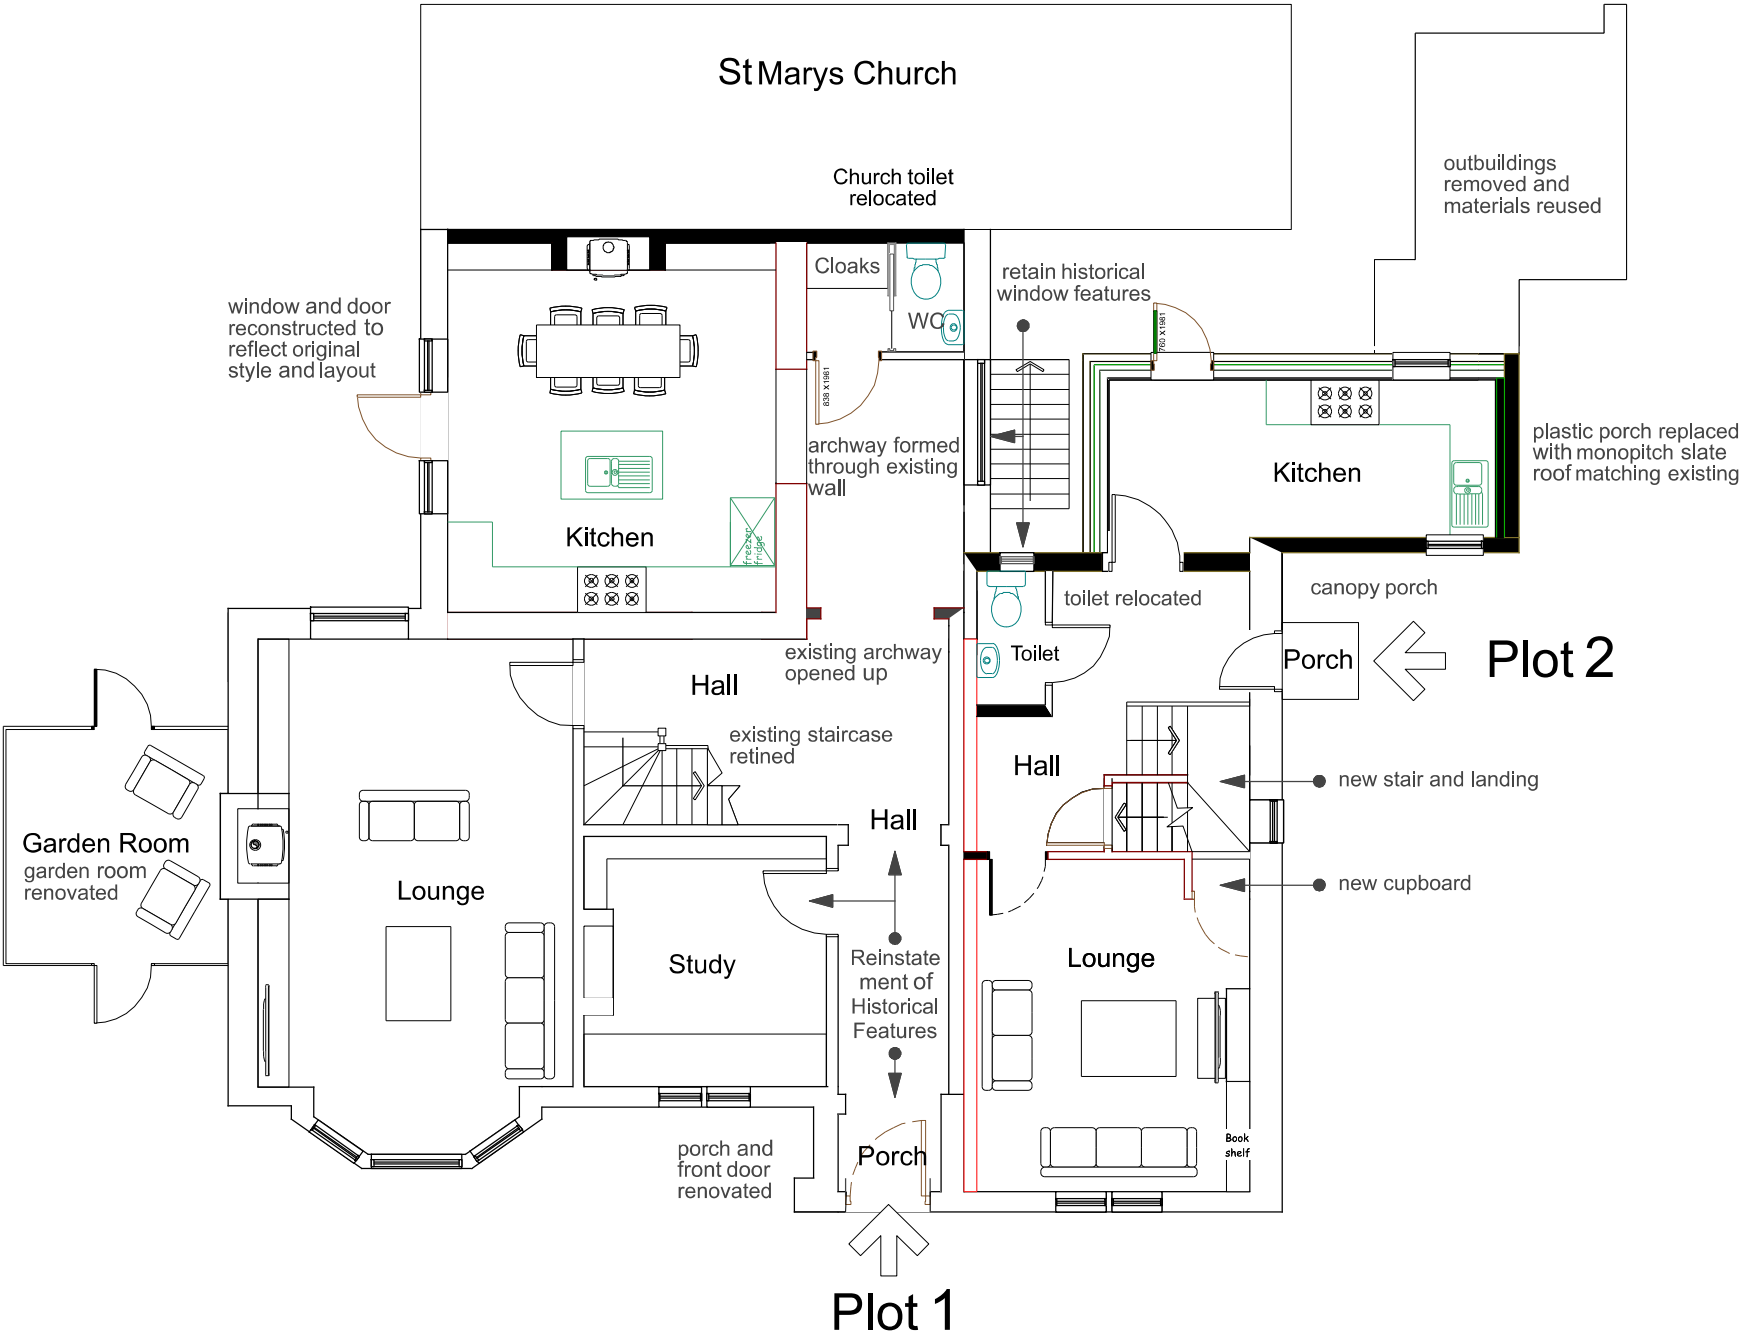


GROUND FLOOR

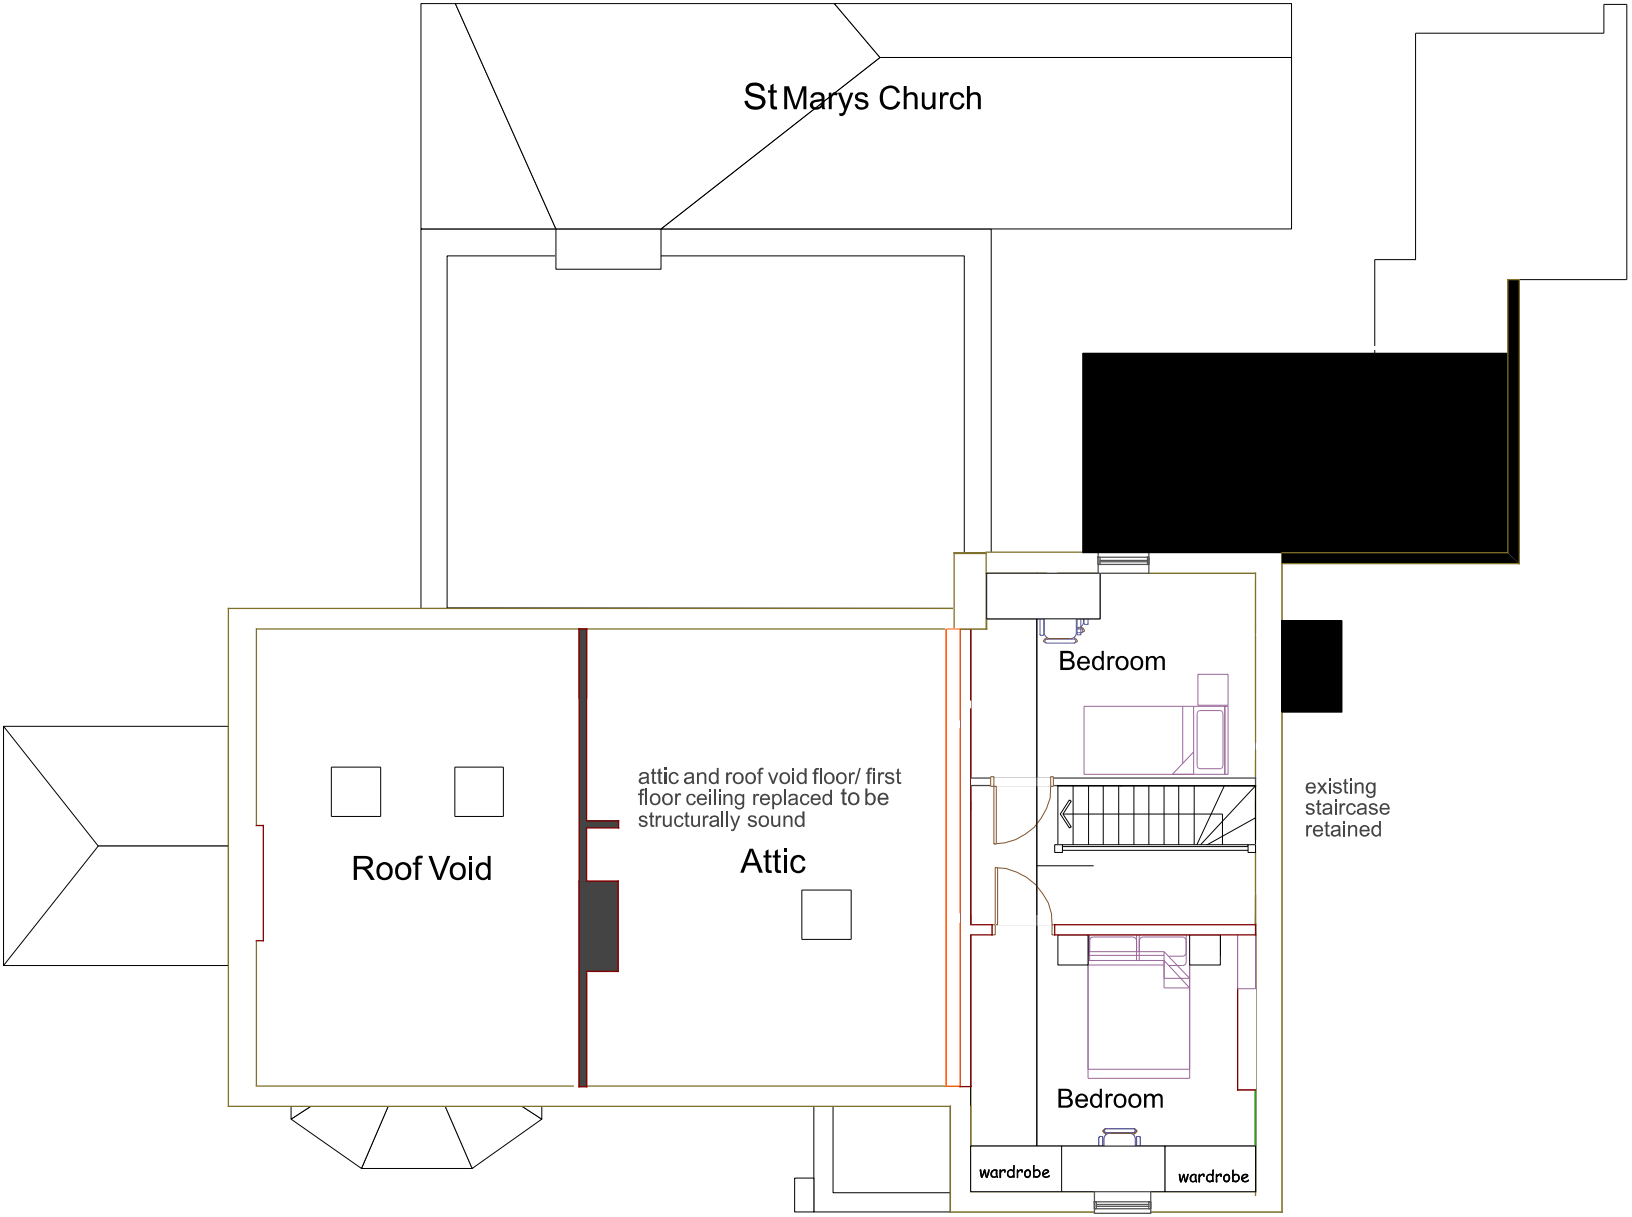

SECOND FLOOR

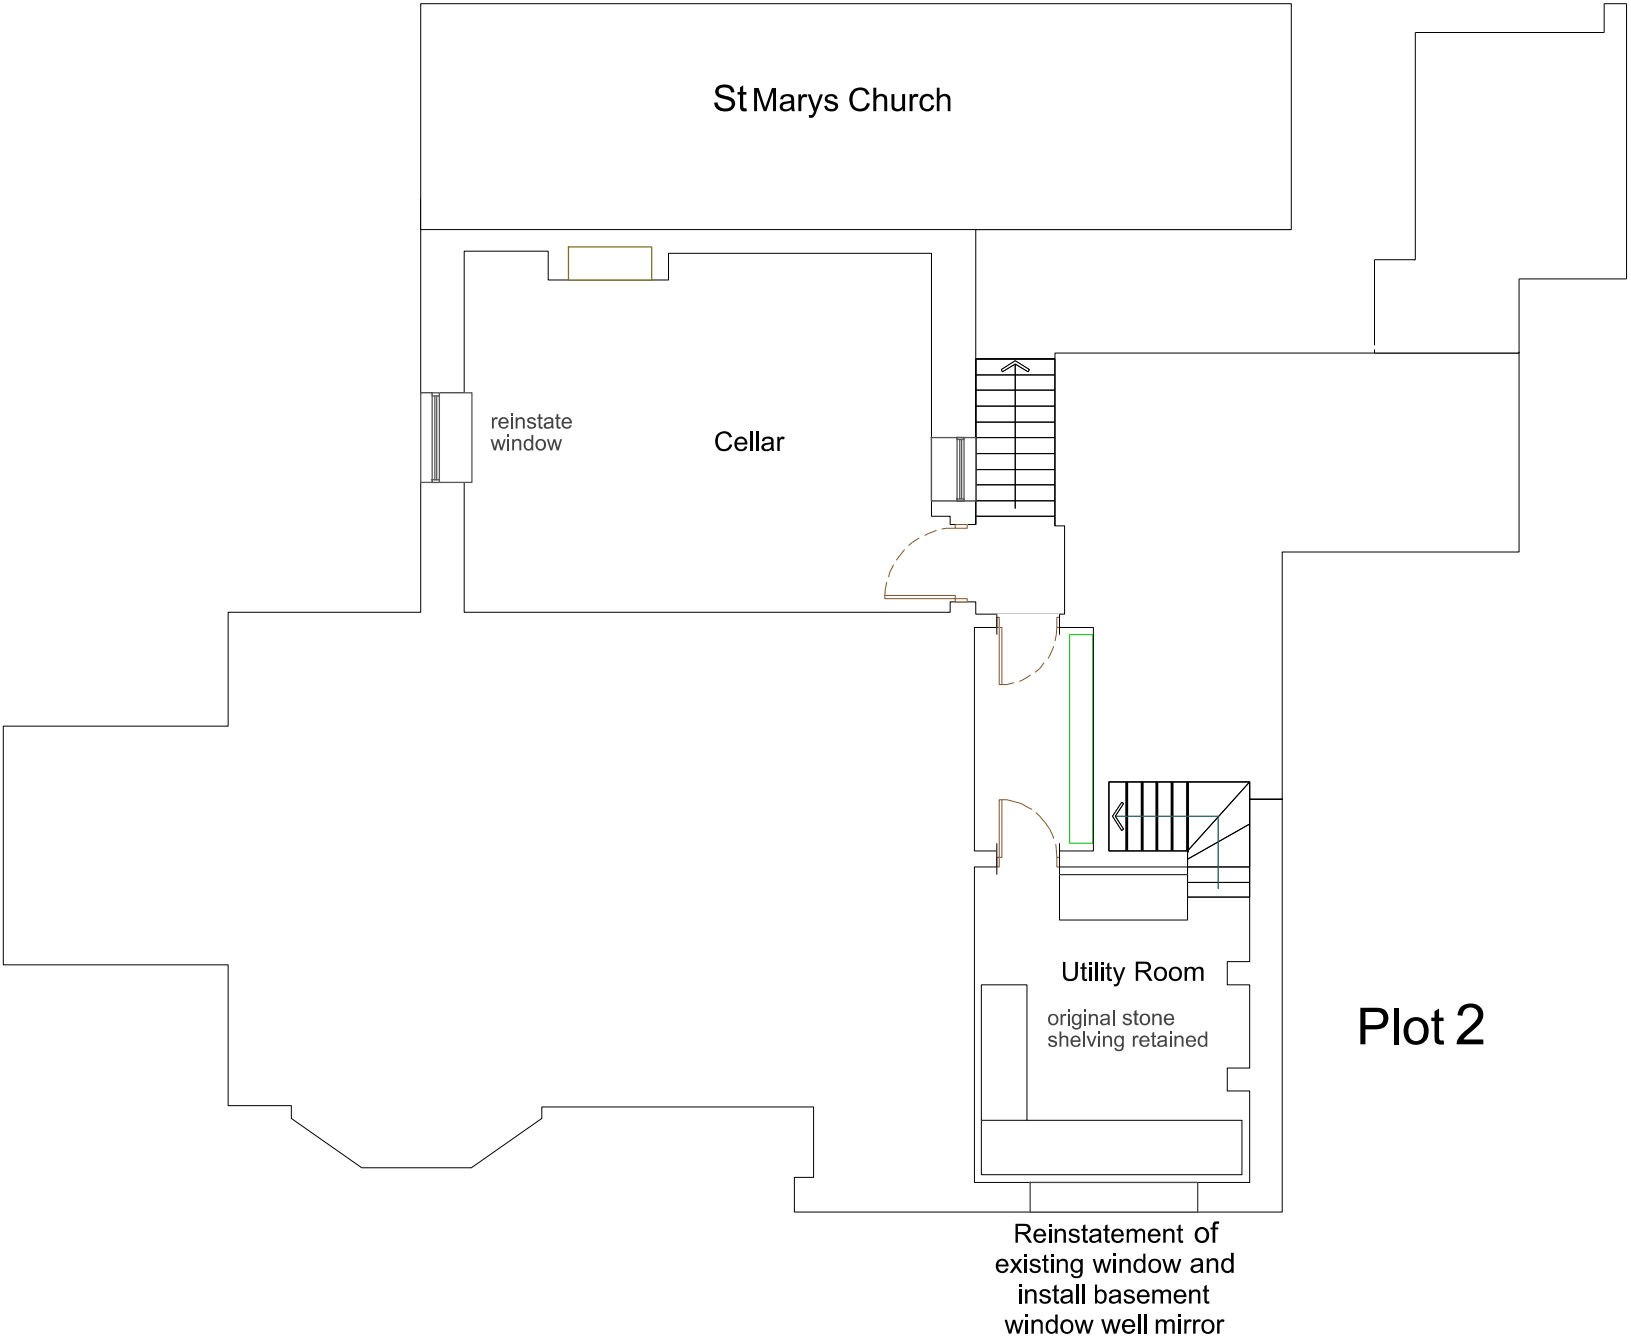

BASEMENT

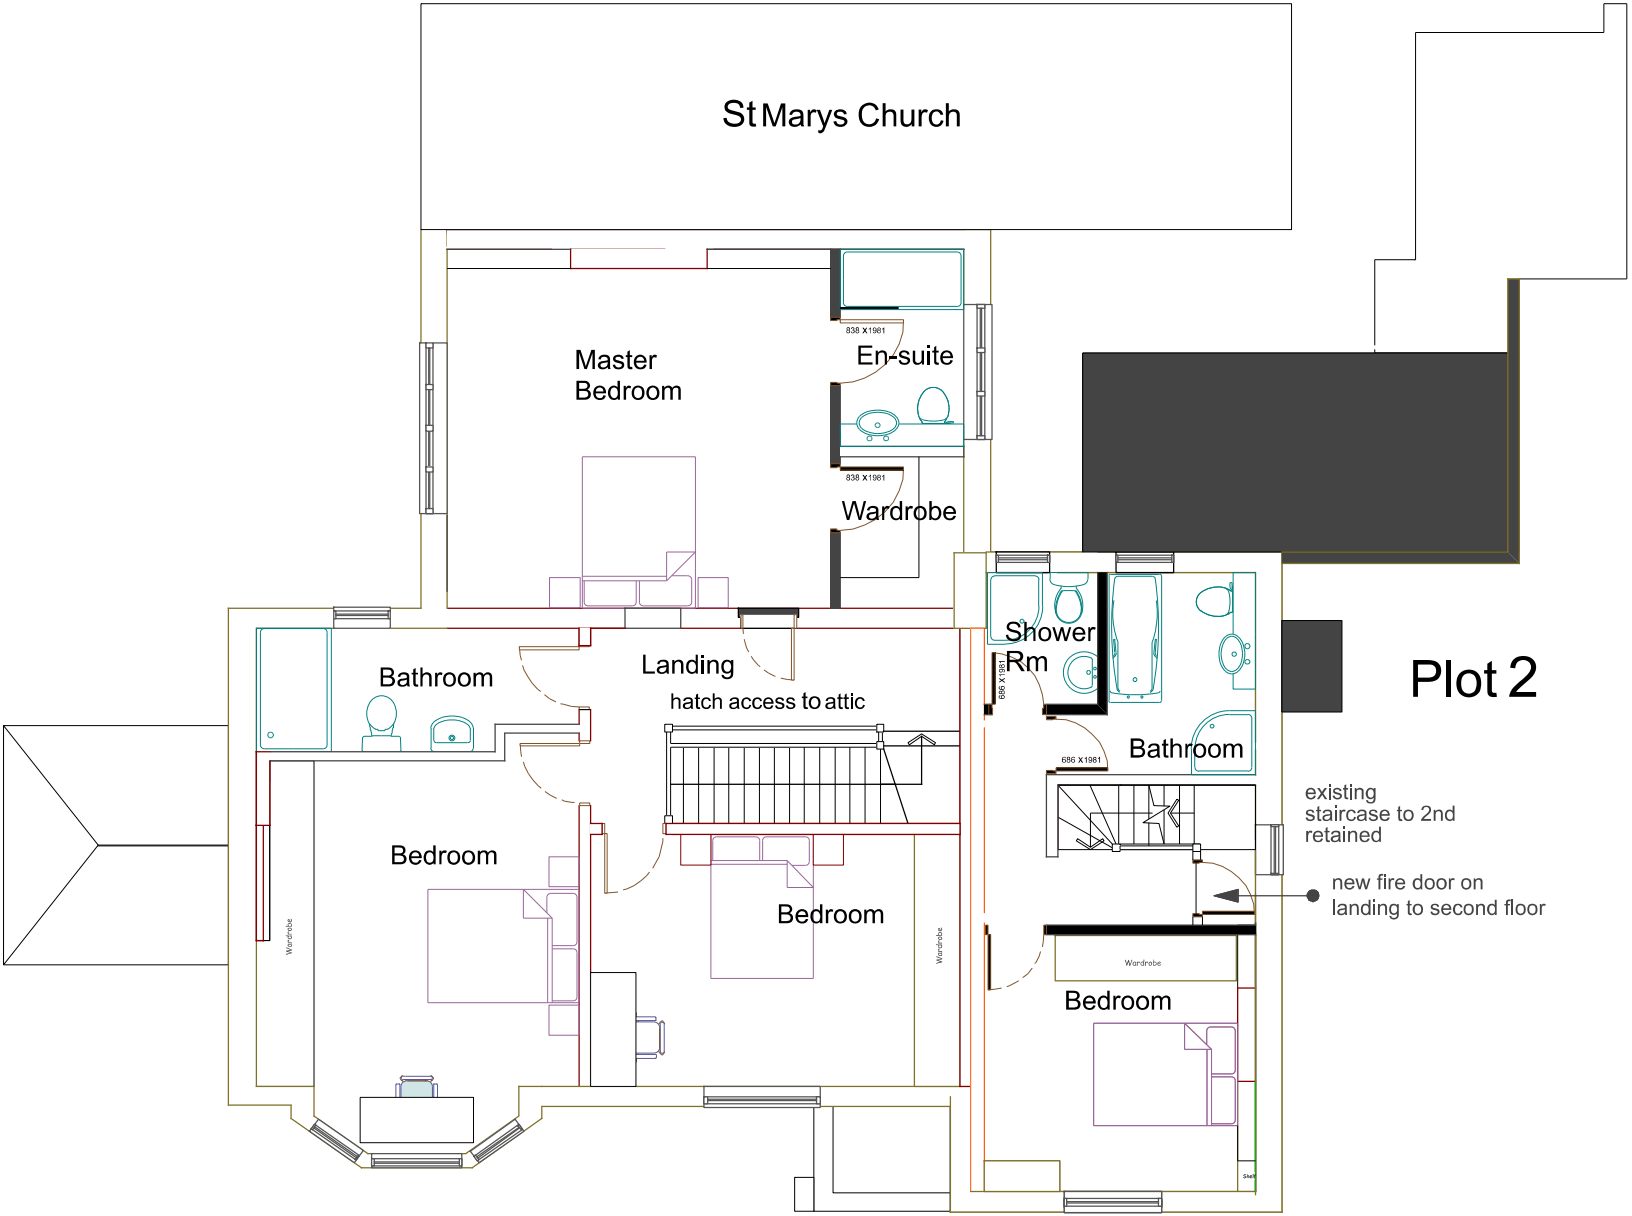

FIRST FLOOR

Original drawings prepared by others and supplied by the Client. ARCD Architects Ltd have amended these drawings only to reflect works stated by the Client to have been constructed. The design, drawing content, and construction works have not been inspected, supervised, measured, or verified by this practice. No responsibility or liability is accepted for the design, drawing content, accuracy of the information shown, or regulatory compliance. Verify all dimensions and site conditions prior to reliance.

01	15-08-26	Scale bar added
rev	date	description
Project	ST MARYS	
Title	FLOOR PLANS AS BUILT	
Project No	Drawing No	Status
-	L (-2) 011	BR
Scale	Date	Rev
1:100@A2	JUL 2026	01