




All drawings should be read in conjunction with the entire **PL Series** drawings. Full details and specifications will be provided following approval of the planning application and through a formal Building Control submission prior to commencement of site works & construction.

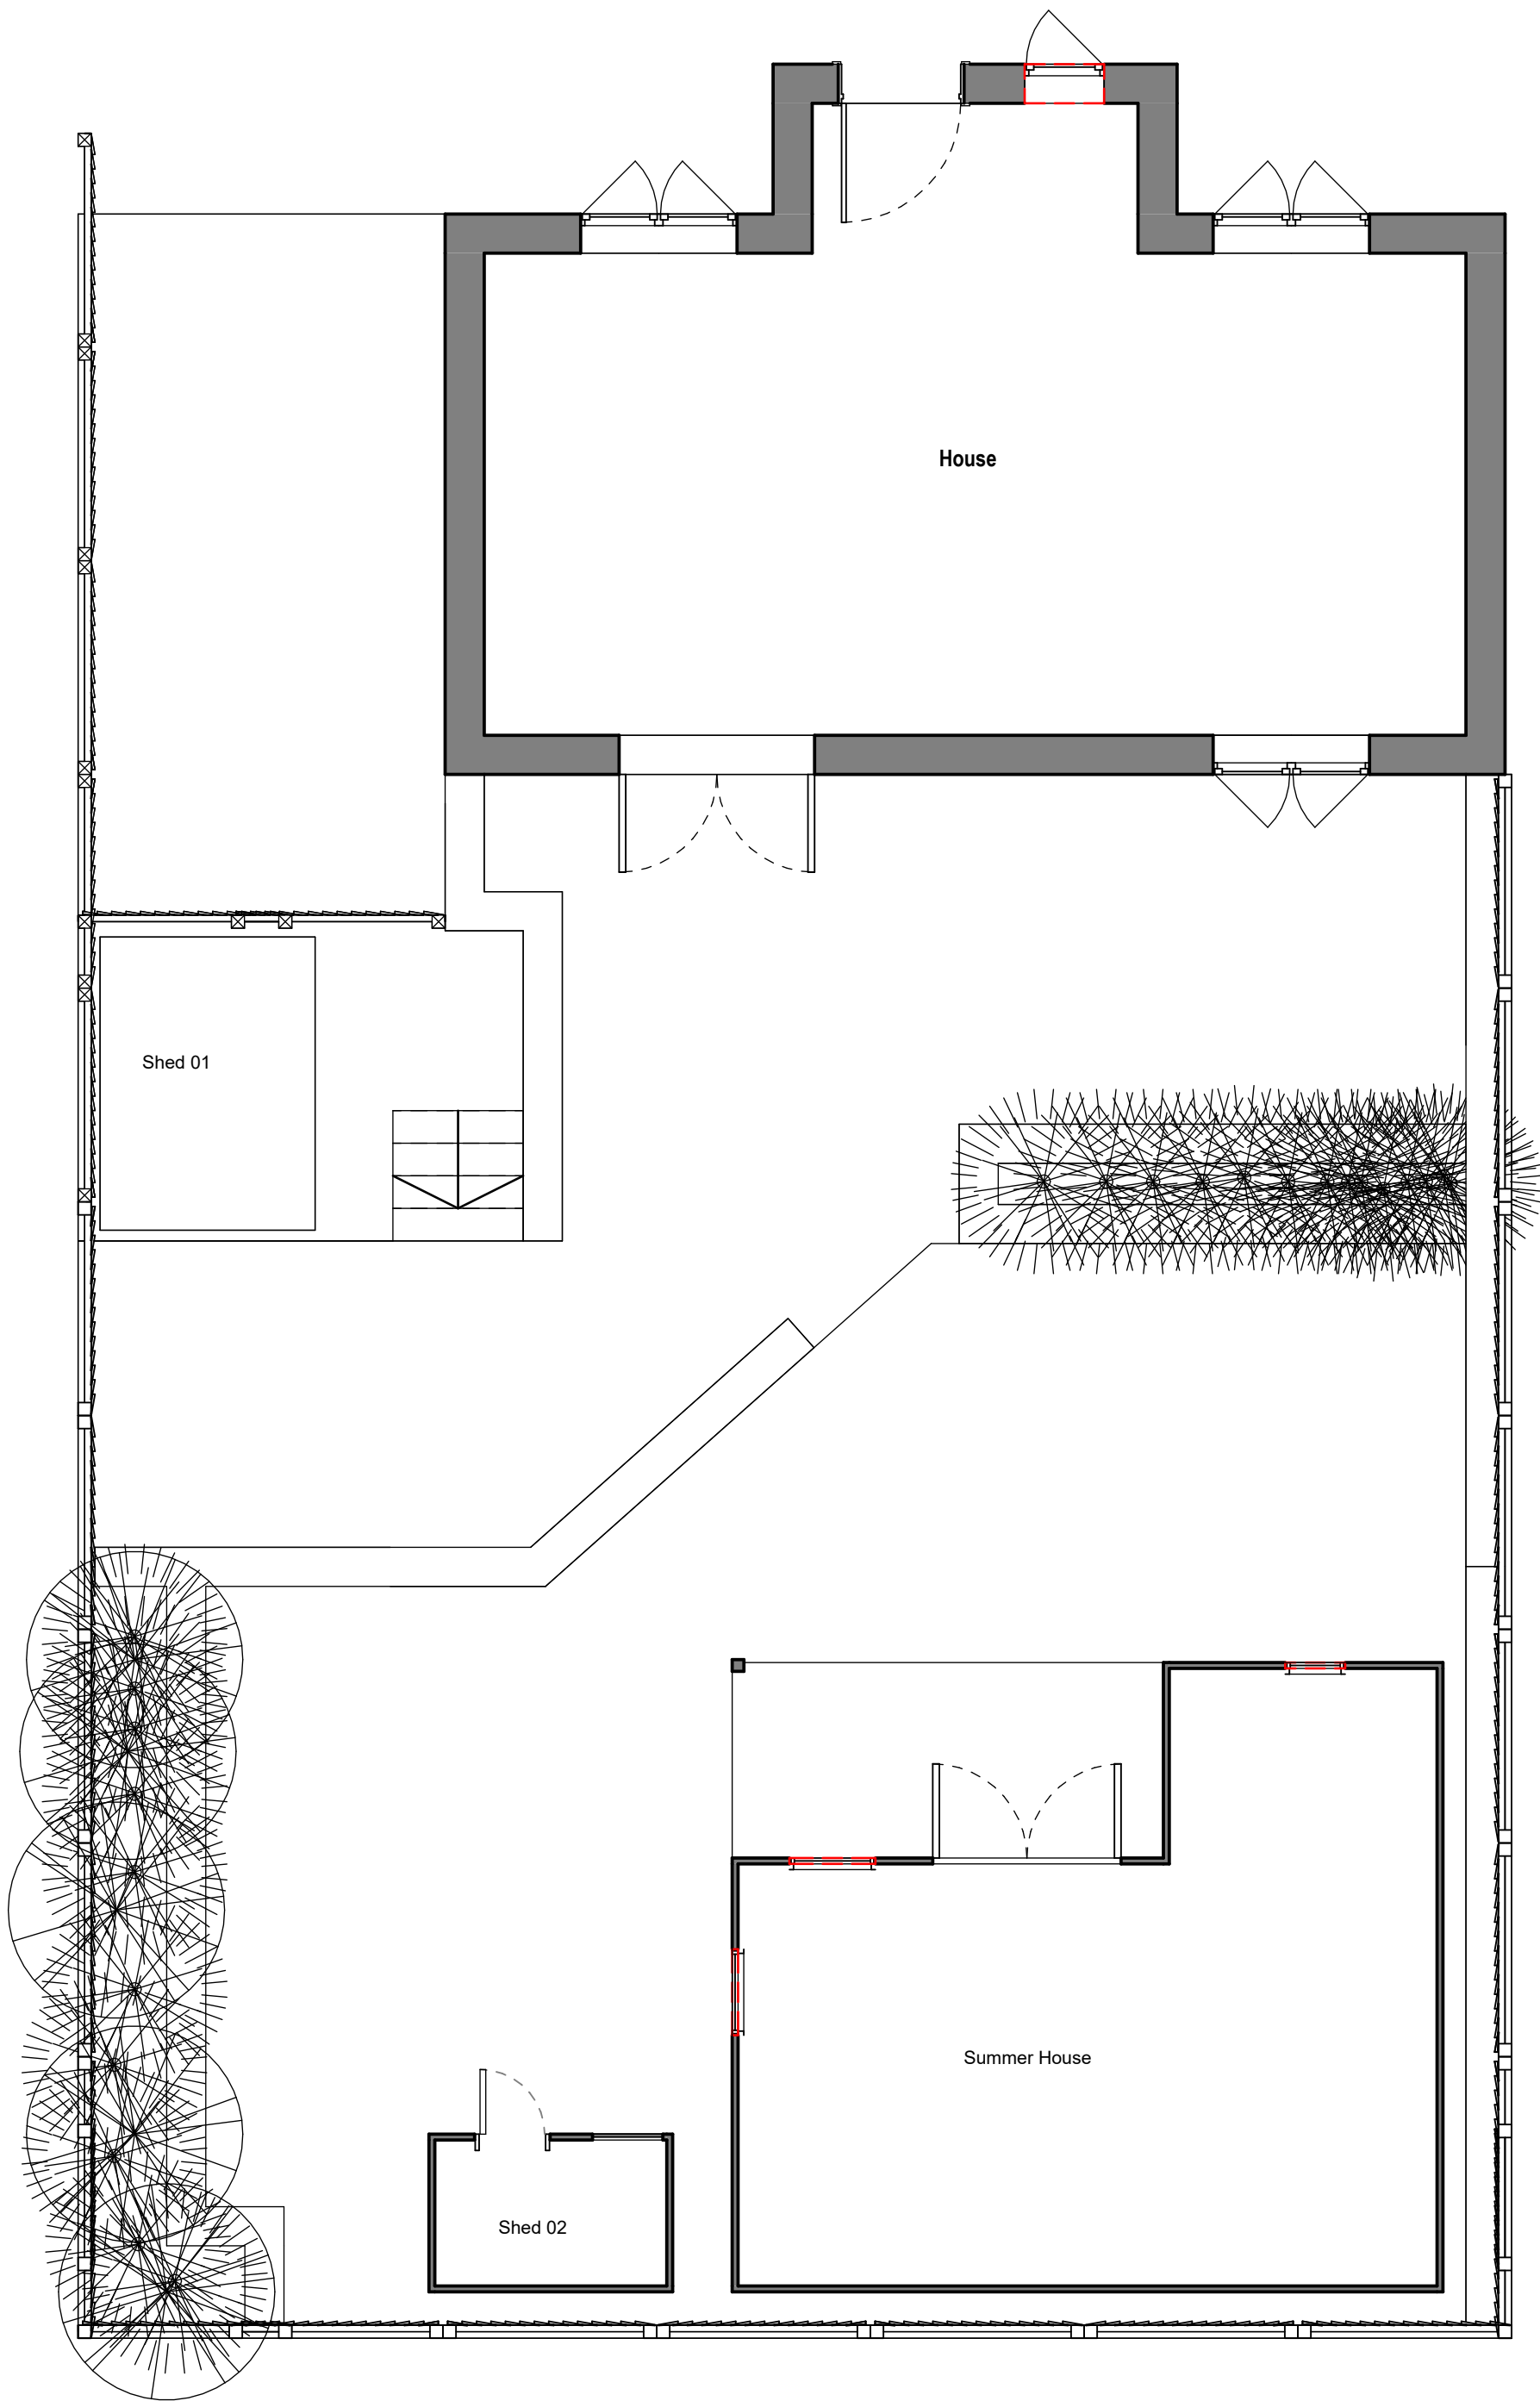

As Built Ground Floor
1 : 50

P0	Initial Issue	12.09.26	SR
Rev	Description	Date	By



info@peakbuildingdesign.com

Project 032 12 Rye Lane, Buxton			
Client Paul Welch			
Drawing As Built Ground Floor			
DRAWING NUMBER PL003			
Revision	P0	Date Created	11.09.26
Drawn By	SR	Scale	1 : 50 @ A1

PLANNING