




All drawings should be read in conjunction with the entire **PL Series** drawings. Full details and specifications will be provided following approval of the planning application and through a formal Building Control submission prior to commencement of site works & construction.



North - East Elevation
1 : 100



South - West Elevation
1 : 100

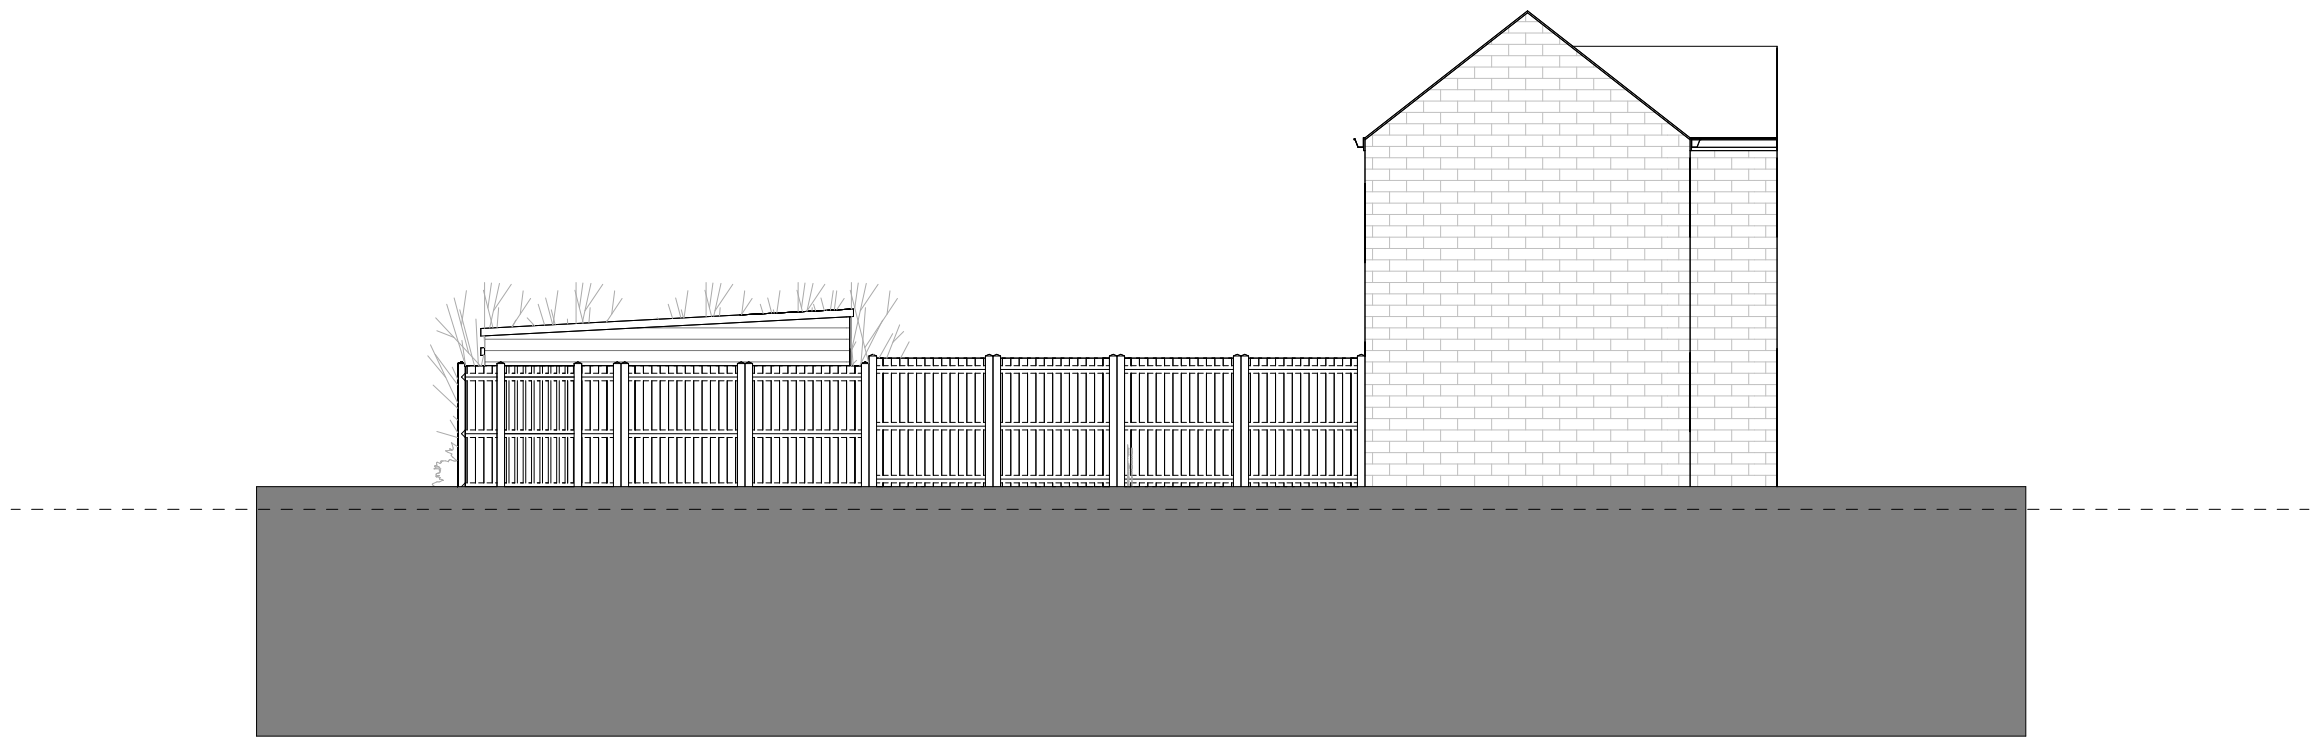

South - East Elevation
1 : 100



North - West Elevation
1 : 100

P1	Initial Issue	12.09.26	SR
Rev	Description	Date	By



info@peakbuildingdesign.com

Project 032 12 Rye Lane, Buxton			
Client Paul Welch			
Drawing As Built Elevations			
DRAWING NUMBER PL004			
Revision	P1	Date Created	04/03/25
Drawn By	SR	Scale	As indicated @ A1

PLANNING