


Refresh amendments taken from
drawing number 3412pag1C.dgn
(Tesco Store Planning Dept. 19.09.07)

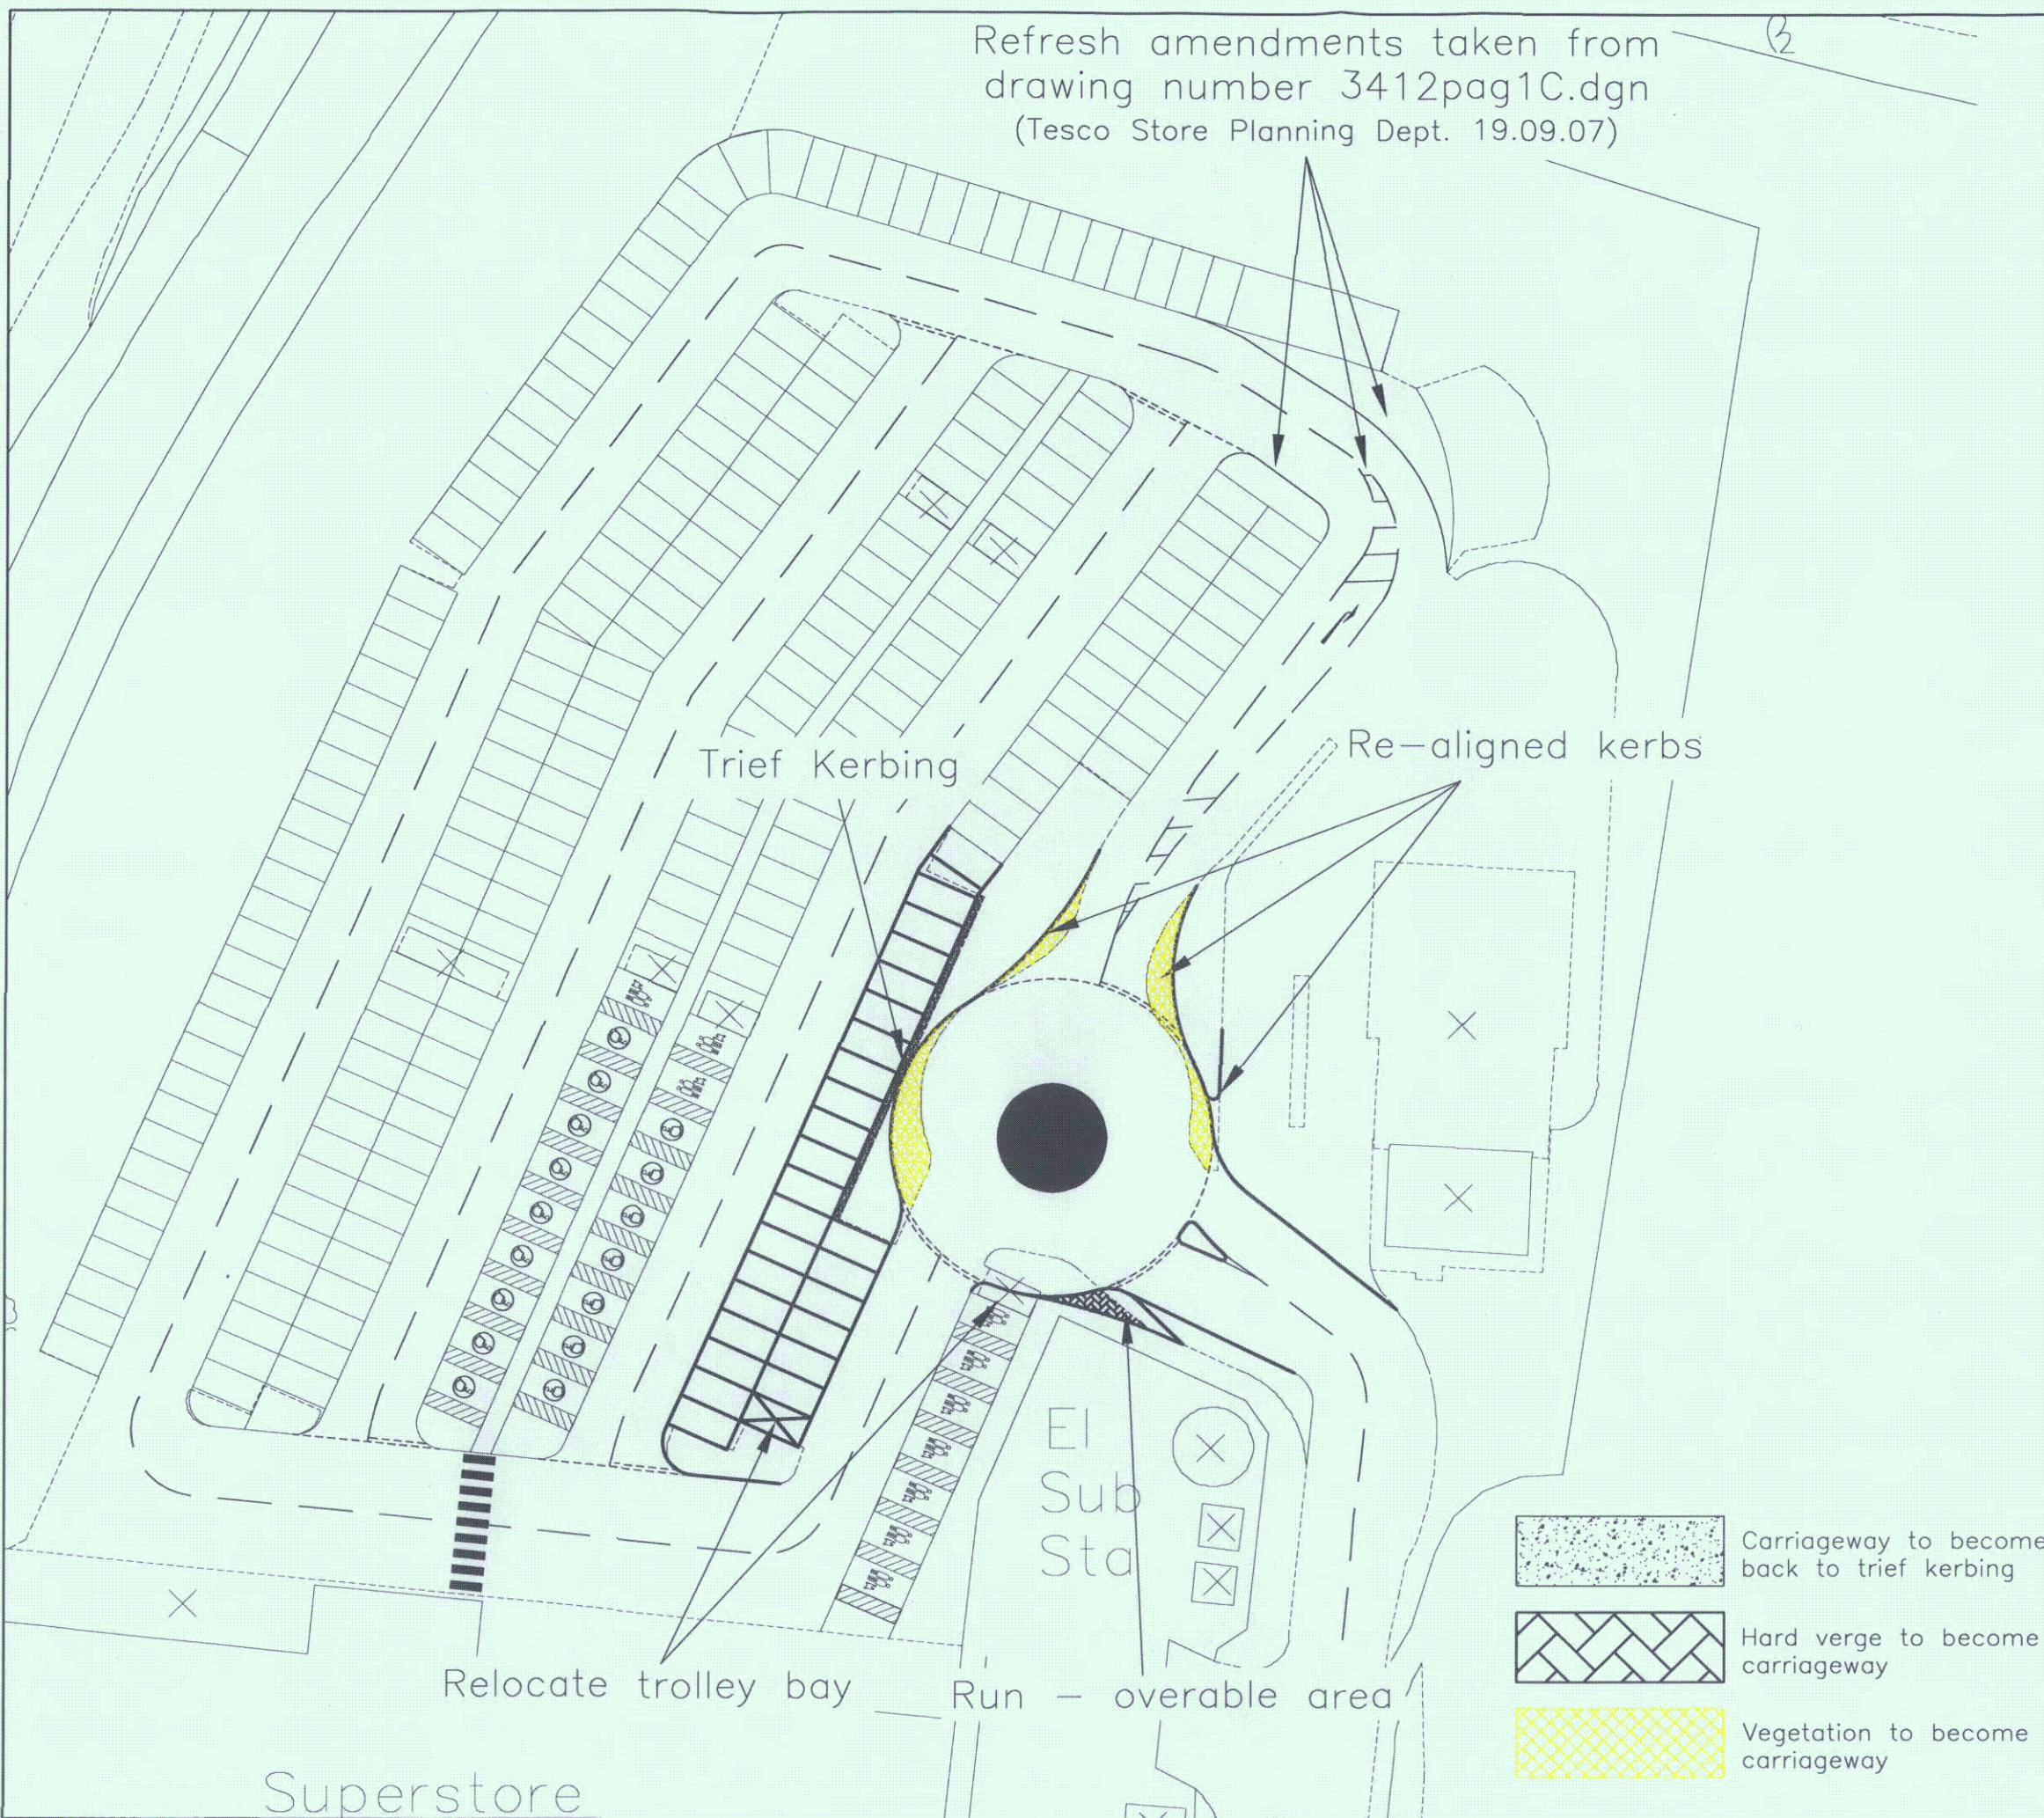

Based upon the Ordnance Survey's (1:1250) Map of 2003 with permission of the controller of Her Majesty's Stationery Office, Crown copyright reserved
Boreham Consulting Engineers Ltd, Regent House, Hubert Road, Brentwood, Essex, CM14 4JE.
Licence No: AL 100010602.

HPK/2007 / 0945

EXISTING STORE - Essential Standard Information

	EXISTING F??	PROPOSED F??	INCREASE
Net Sales Area			
Gross Building Area External (Not to include Atrium)			
Total Storage Area's			
Dot Com Van's Docked/ Undocked/Total (with req. storage)			
Standard Parking	222	221	-1
P & T Parking	9	9	0
Disabled Parking	16	16	0
Total Parking	247	246	-1
Parking Ratio			
Trolley Bays	7	7	0
Store Land Take			
PFS Number of Islands			
Car wash/Jet Wash?			
PFS Land Take			
Total Land Take			
Other Information if applicable			
Car parking spaces by level (Detail below as applicable)			
e.g. Basement (Residential)			
e.g. Grade (Store)			
e.g. Deck (Store)			
Other Uses on site (Please state offices/employment/community/leisure etc.)			
Gross Area of other uses			
Total Parking for other units			

REV	DATE	AMENDMENTS	DRAWN	CHK	APP
B	17.10.07	Refresh amendments, tied into BCE prop	NB	BB	BB
A	10.09.07	Relocate roundabout	NB	BB	BB

Boreham Consulting Engineers Ltd.
Regent House
Hubert Road
Brentwood
Essex CM14 4JE

Boreham
CONSULTING ENGINEERS LTD

Telephone: (01277) 238100
Facsimile: (01277) 238150
Email: enquiries@boreham.com

BSI
REGISTERED
FS23721

INVESTOR IN PEOPLE

Client
TESCO

Project
Access and Egress

HIGH FLAK BOROUGH COUNCIL
GLASSOP SITE
RECEIVED

Title
Whaley Bridge
Option 2

22 NOV 2007

FILE REF.
REPLY REQUIRED

Team	Drawn	Checked	Approved
C	NB	TP 31/07/07	

Scale
1:500 @ A3

Date
July 2007

Drawing No.
207175_04

Rev
B

Purpose of Issue ☐ Preliminary ☐ For Tender ☐ For Construction
☐ For Information ☐ For Approval ☐ As Built

File Name C-G1/207175/Dwg/207175_04B.dwg

Boreham Consulting Engineers Ltd accept no responsibility for any unauthorised amendments to this drawing. Only figured dimensions are to be worked to. COPYRIGHT © RESERVED