


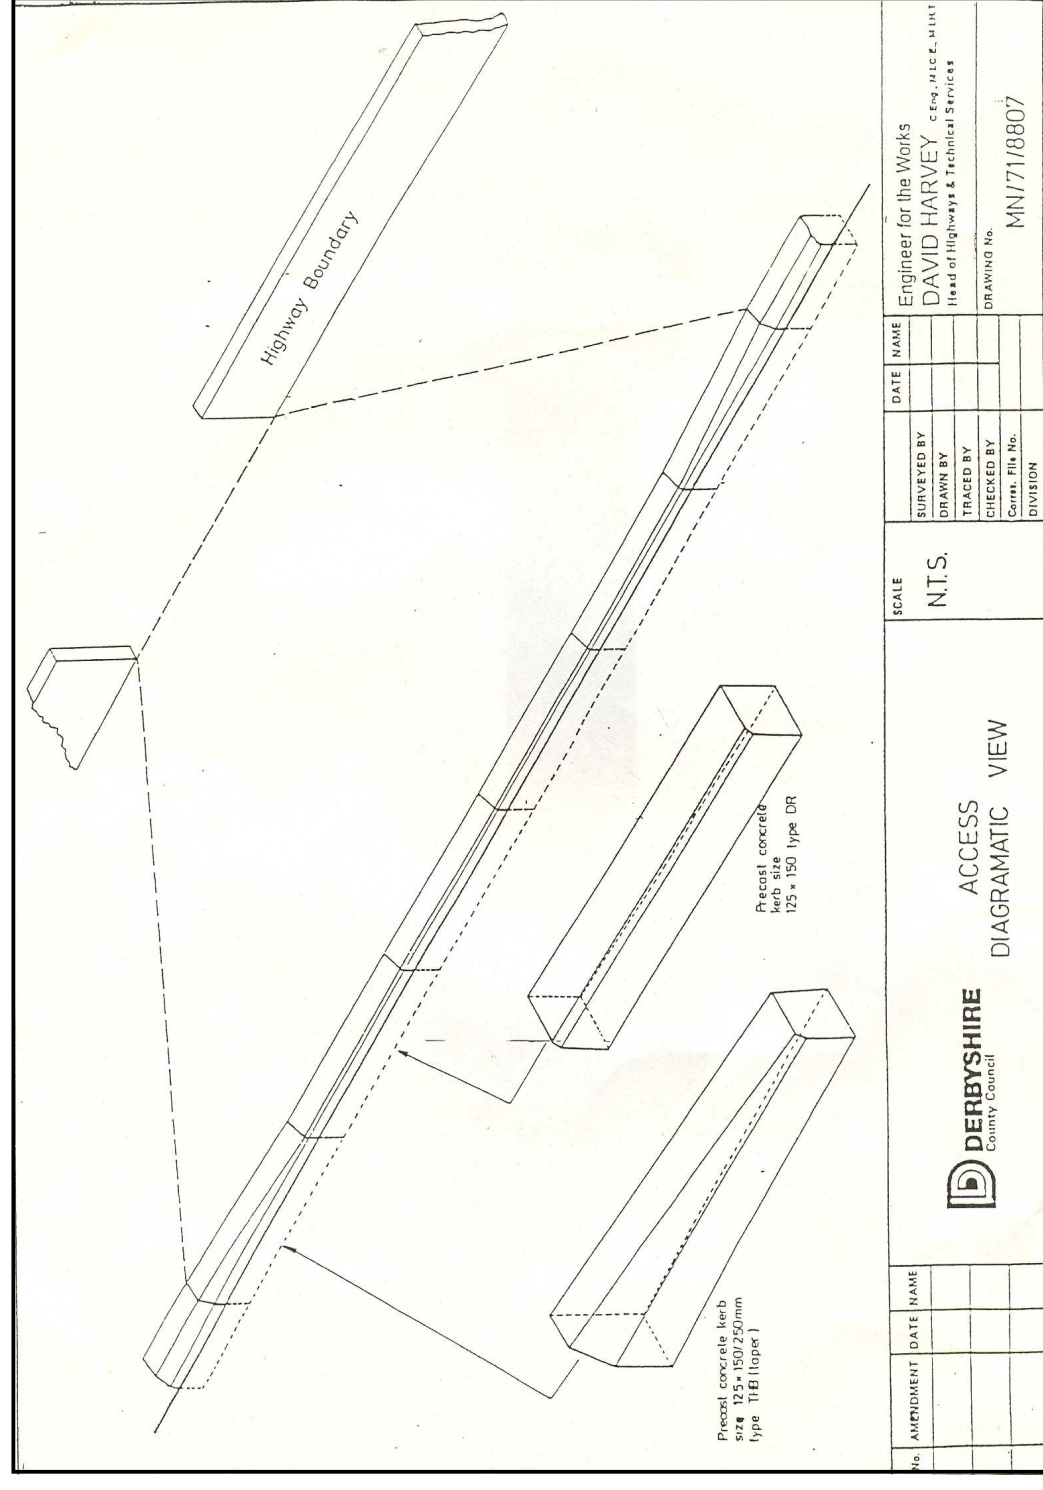


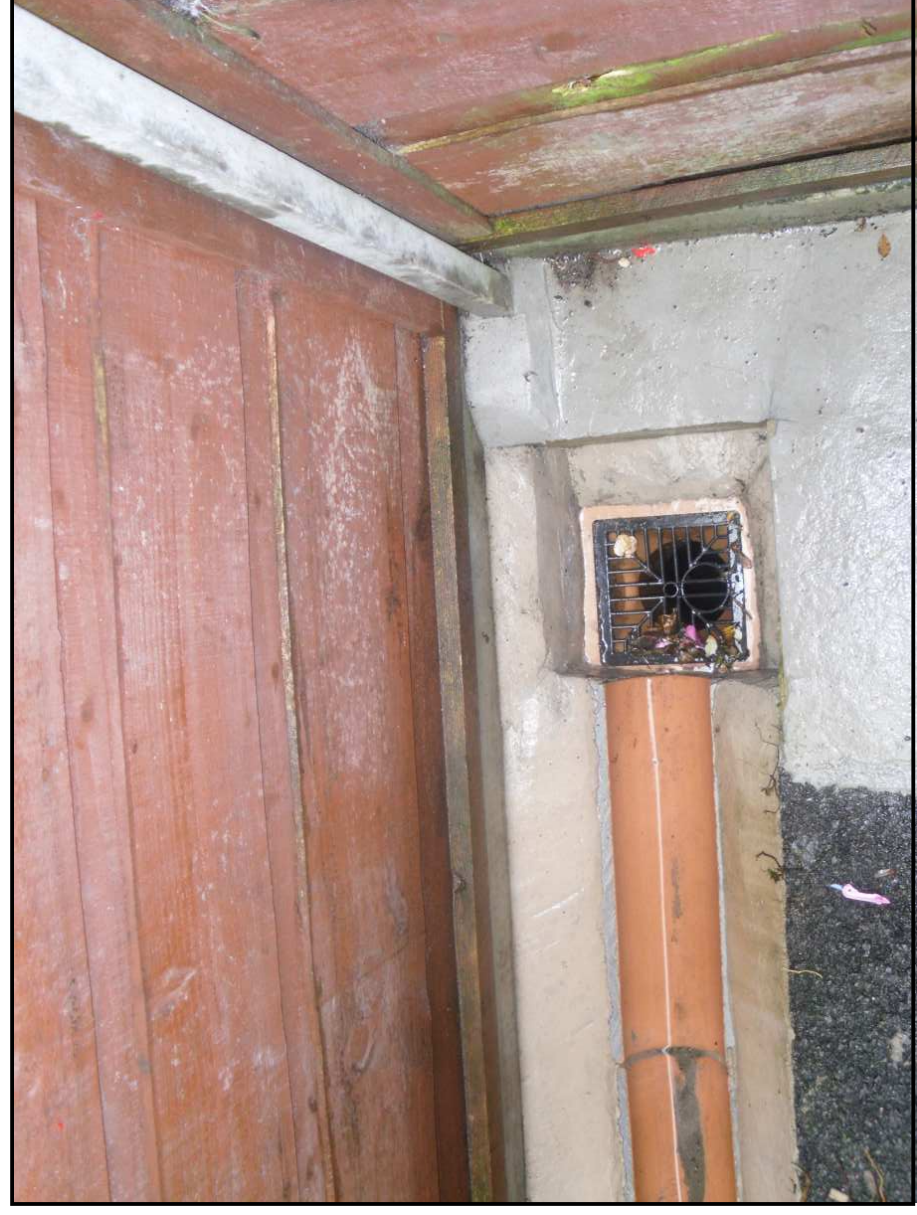


ENTRANCE AS CONSTRUCTED

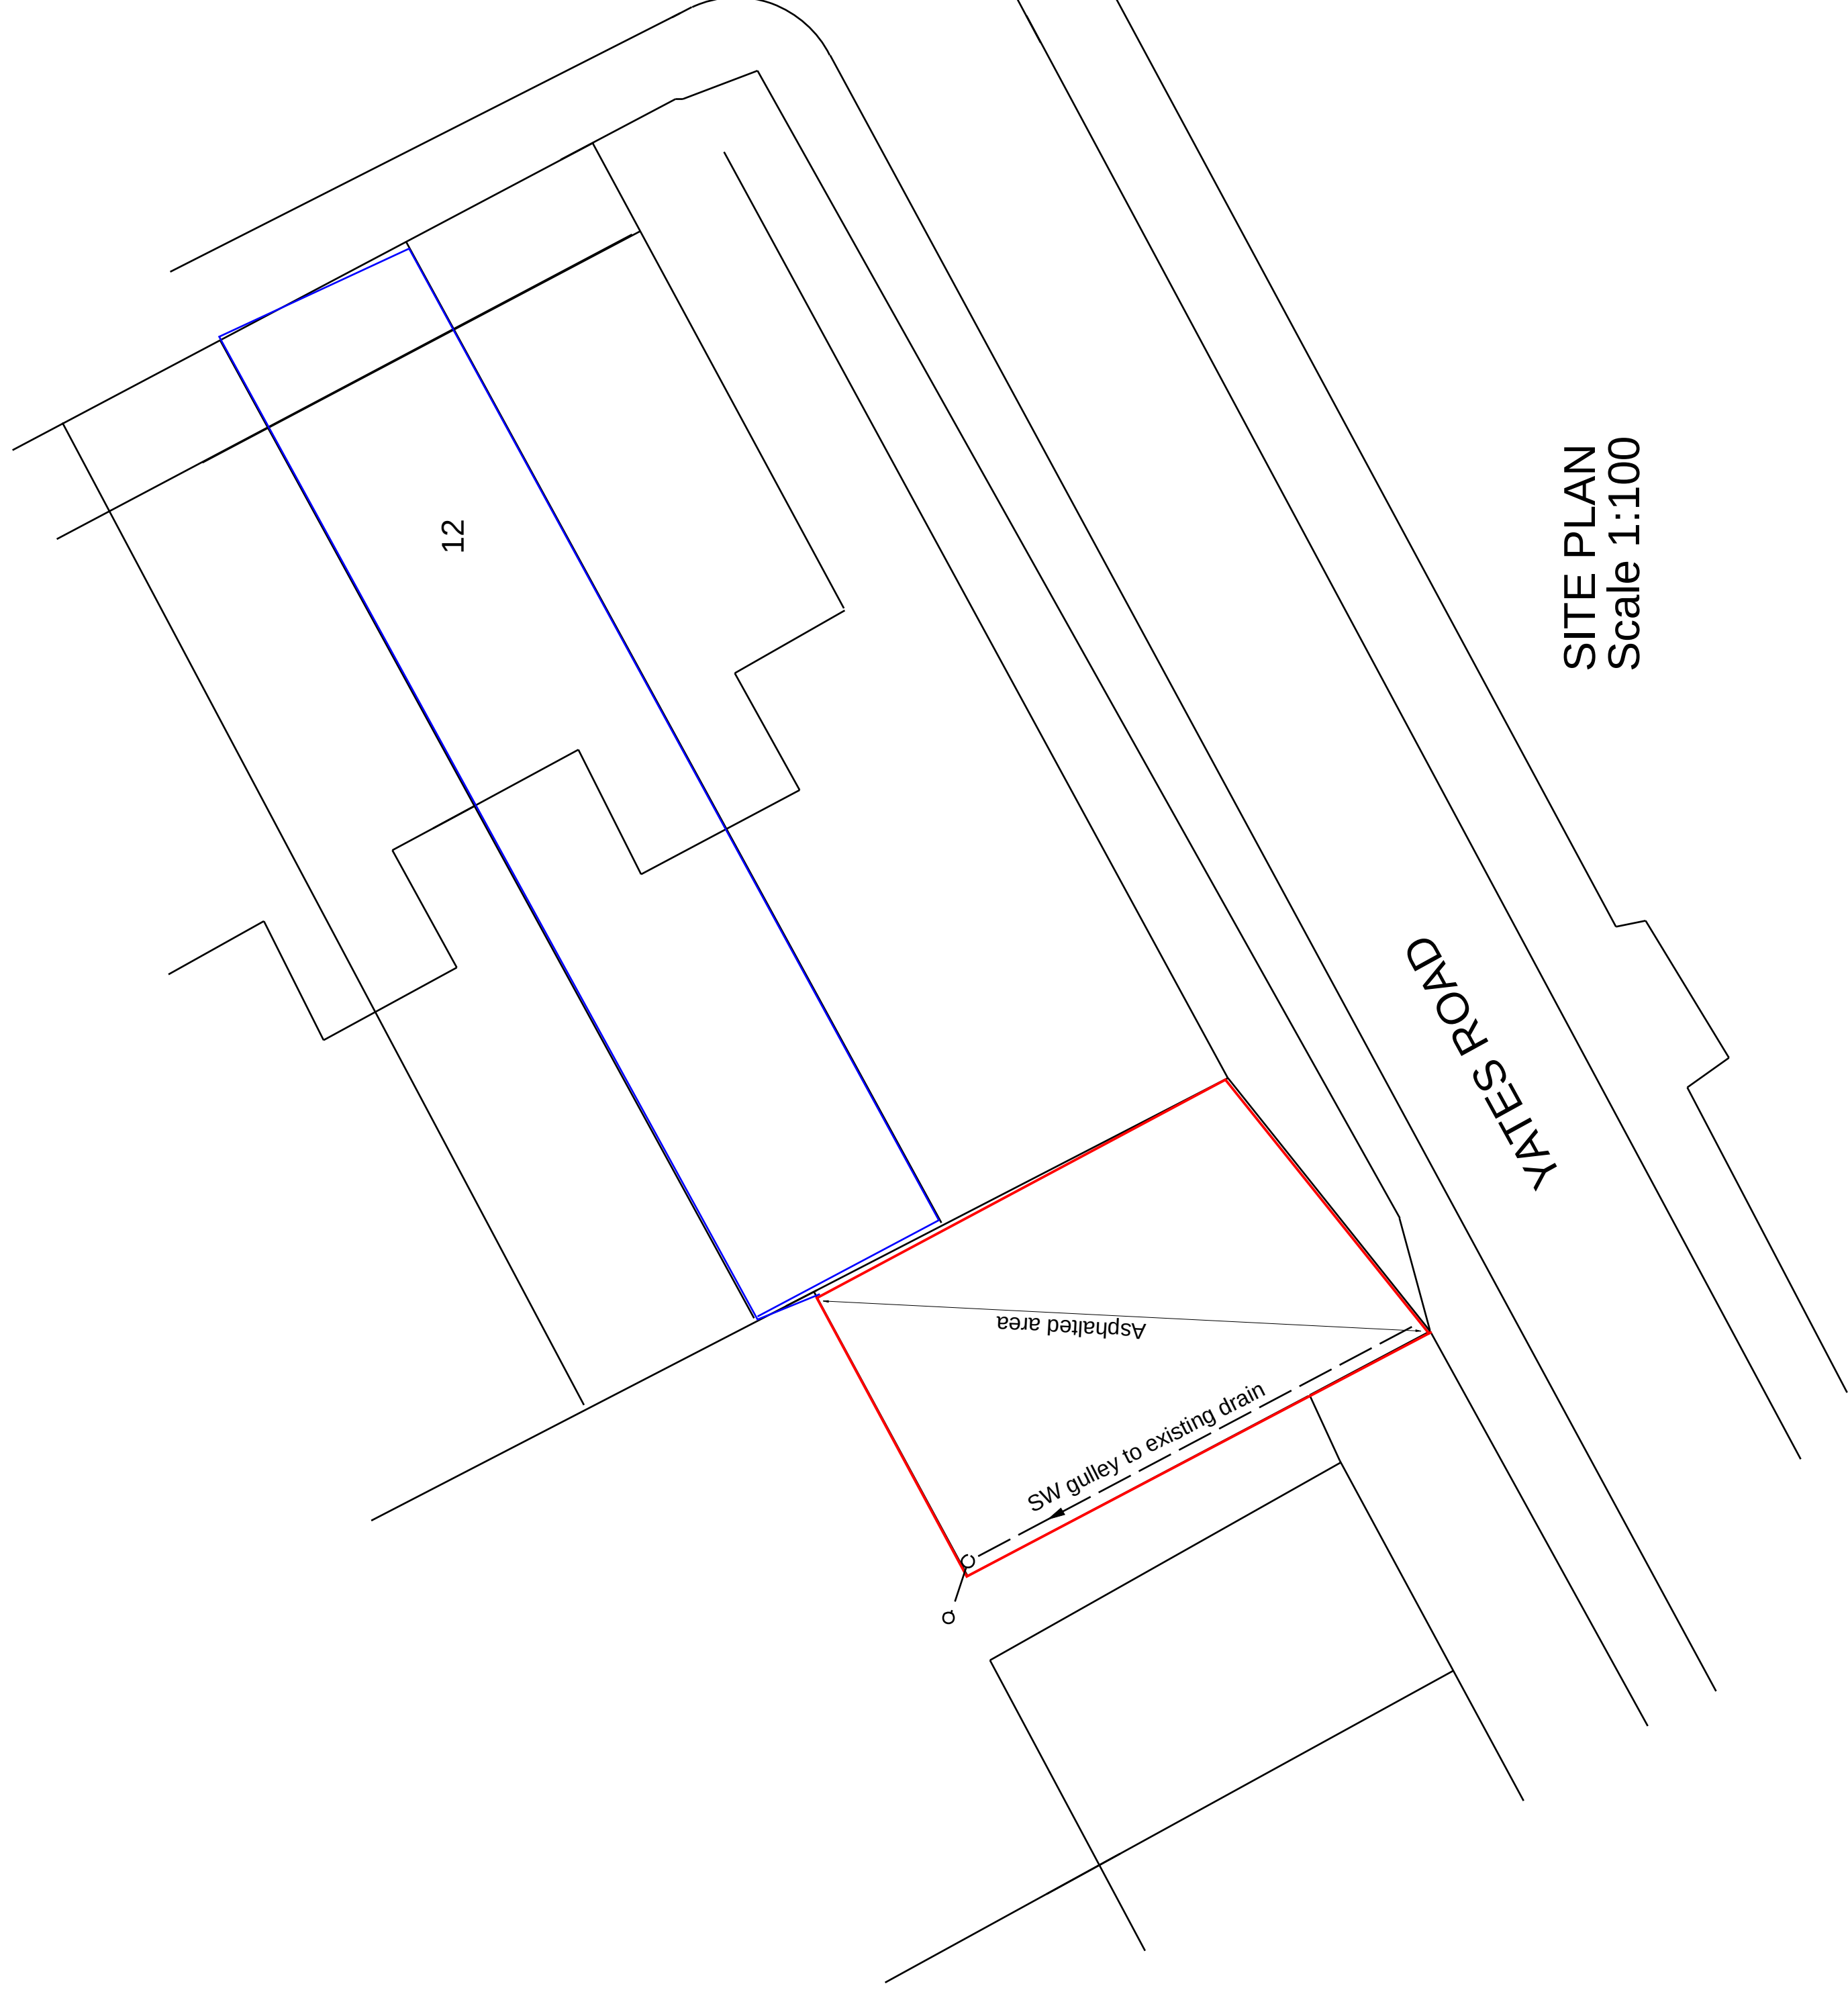

SW DRAIN

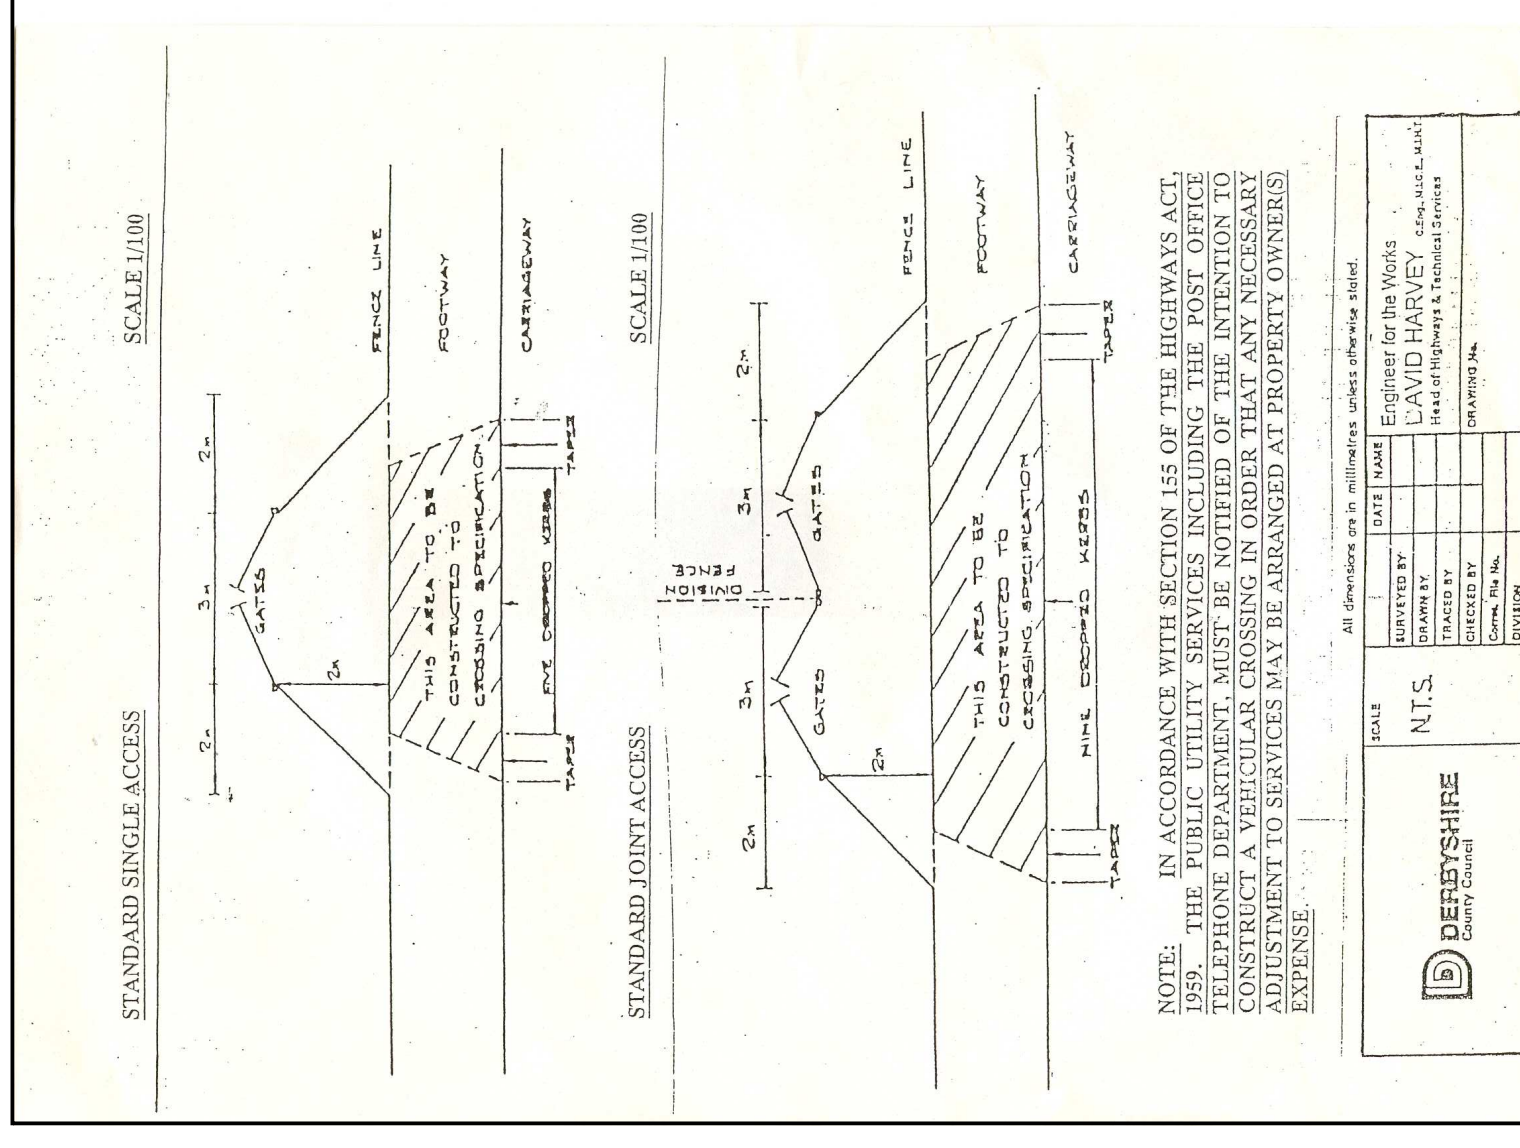

SITE PLAN
Scale 1:100

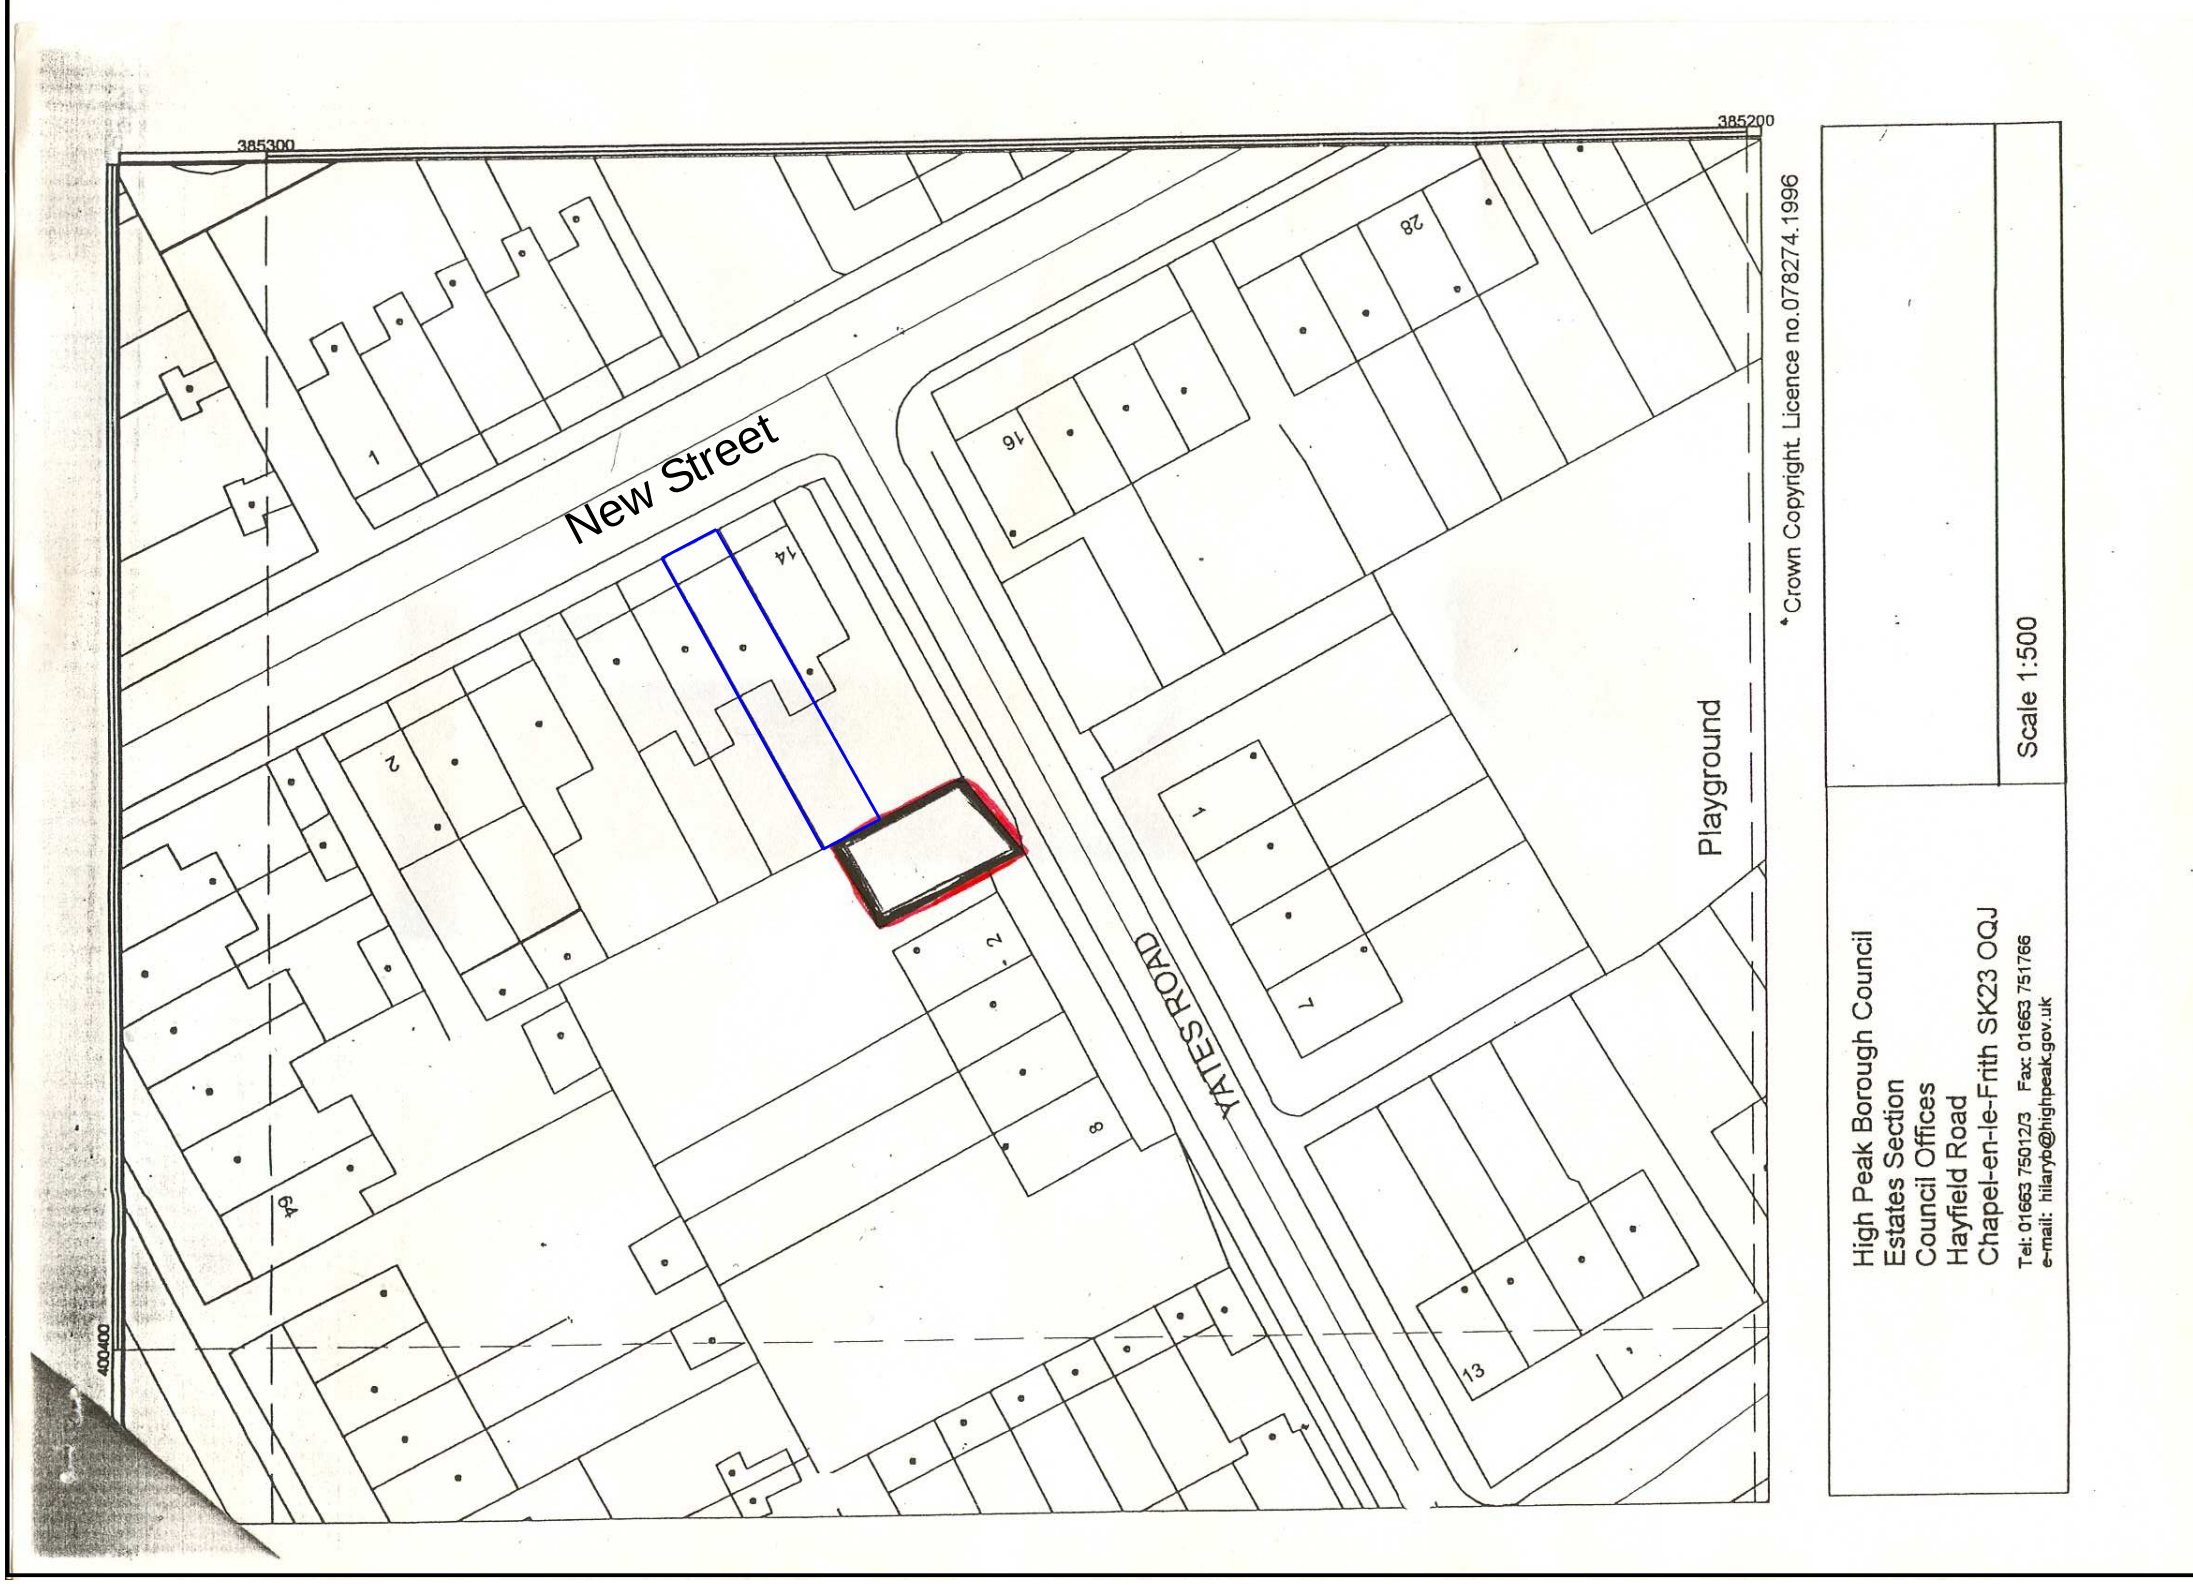

LOCATION PLAN
Scale 1:500

[illegible]