

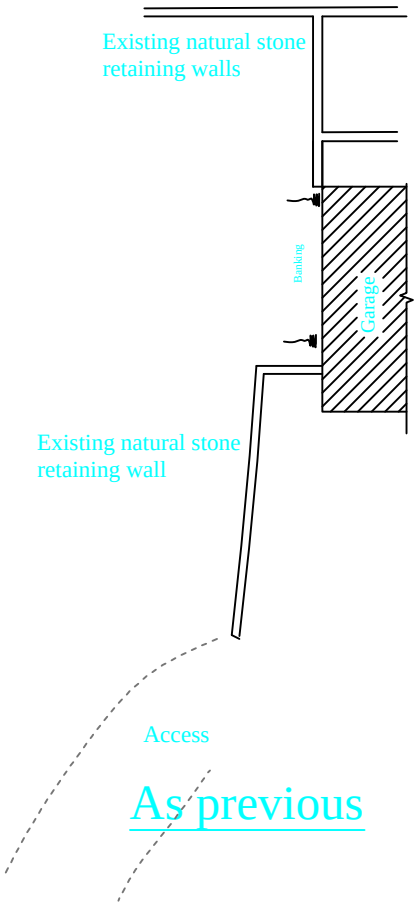


As previous

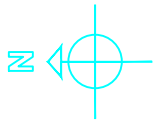

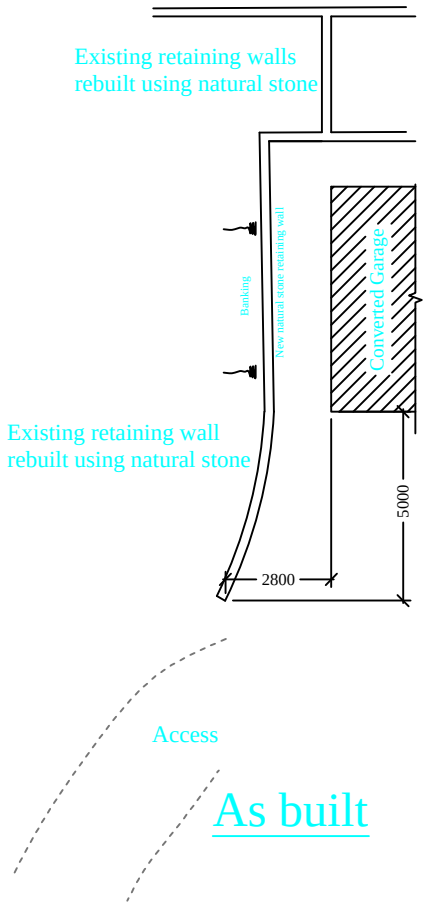

As built

DESIGN LTD

Building Design & Surveying Consultants
The Old Co-Op Building, Church Street,
Hayfield,, High Peak SK22 2JE
Tel:01663 742903 Fax:01663 746686
Mobile: 07984 007 087 Email: info@sjdesign.net
www.sjdesign.net

Client
Simon Potkins

Job Title
Proposed extension and alterations at
Highgate Hall
Hayfield
High Peak
SK22 2JL

Drawing Title
Block plan showing as existing and as proposed retaining wall adjacent to garage

Scale
1:200; @A4

Date
Dec 2010

Drawn by
SJ

Drawing No.
504

Rev.