

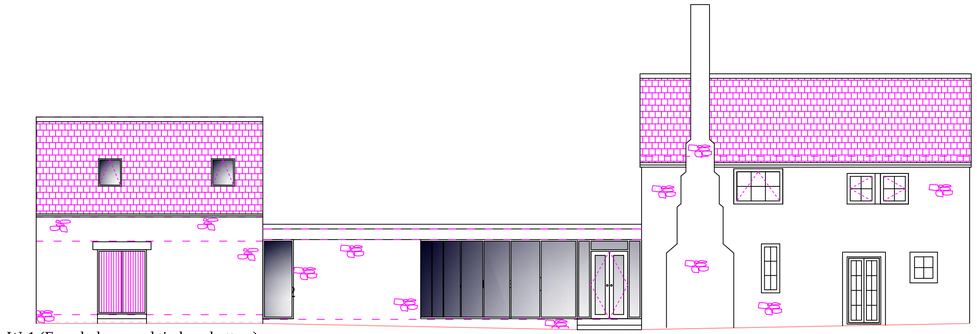



West as built

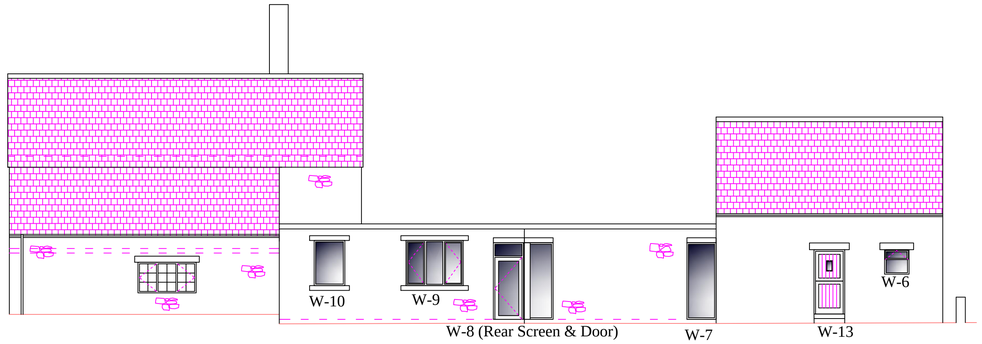


East as built

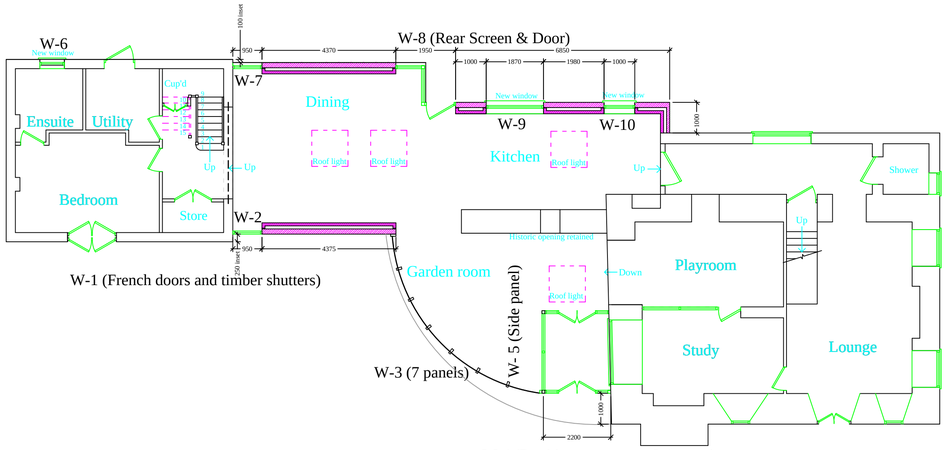


Ground as built

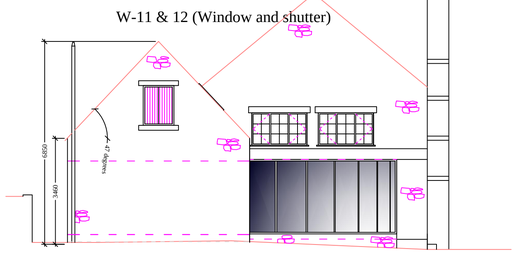





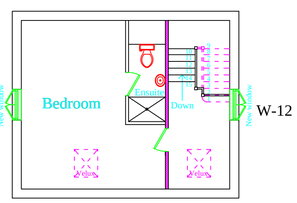


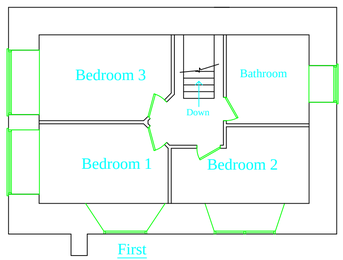


Sections Through Doors and Windows 1:10

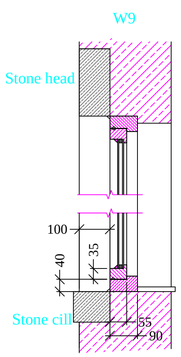

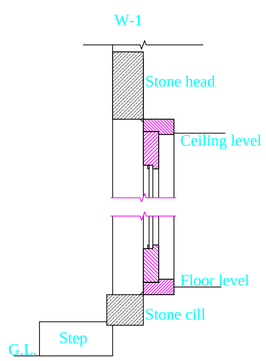

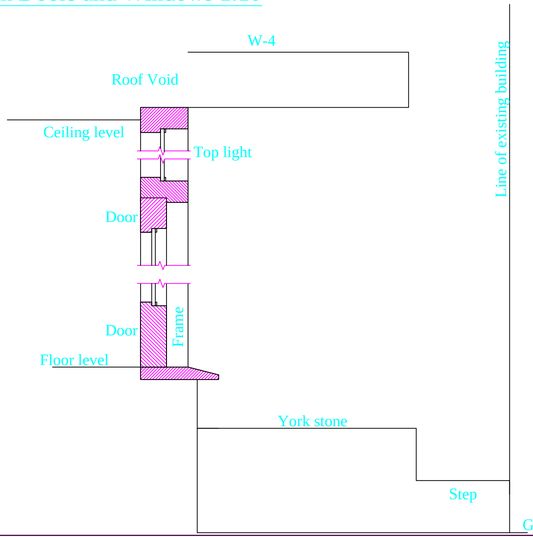

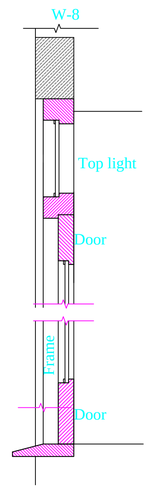

Window Schedule

Notes:
1. Painted softwood frames Vac-Vac impregnated
2. Colour: Lamp Room Gray (88) as per colour sample brochure enclosed or similar.

As built record

This drawing is the Copyright of SJ Design Limited.
All dimensions must be checked on site and not scaled from this drawing.
All materials and workmanship are to be in accordance with prevailing British Standards, Codes of Practice, Building Regulations, manufacturers and federation recommendations and all to the complete satisfaction of SJ Design Limited.

A	1.12.10	Roof pitch altered, window details changed

SJ DESIGN LTD
Building Design & Surveying Consultants
The Old Co-Op Building, Church Street, Hayfield,, High Peak SK22 2JE
Tel:01663 742903 Fax:01663 746686
Mobile: 07984 007 087 Email: info@sjdesign.net
www.sjdesign.net

Client
Simon Potkins

Job Title
Proposed extension and alterations at
Highgate Hall
Hayfield
High Peak
SK22 2JL

Drawing Title
As built plans

Scale
1:100; @A1

Date
September 2010

Drawn by
SJ

Drawing No.
700

Rev.
A