HPK/2010/0656

08 DEC 2010

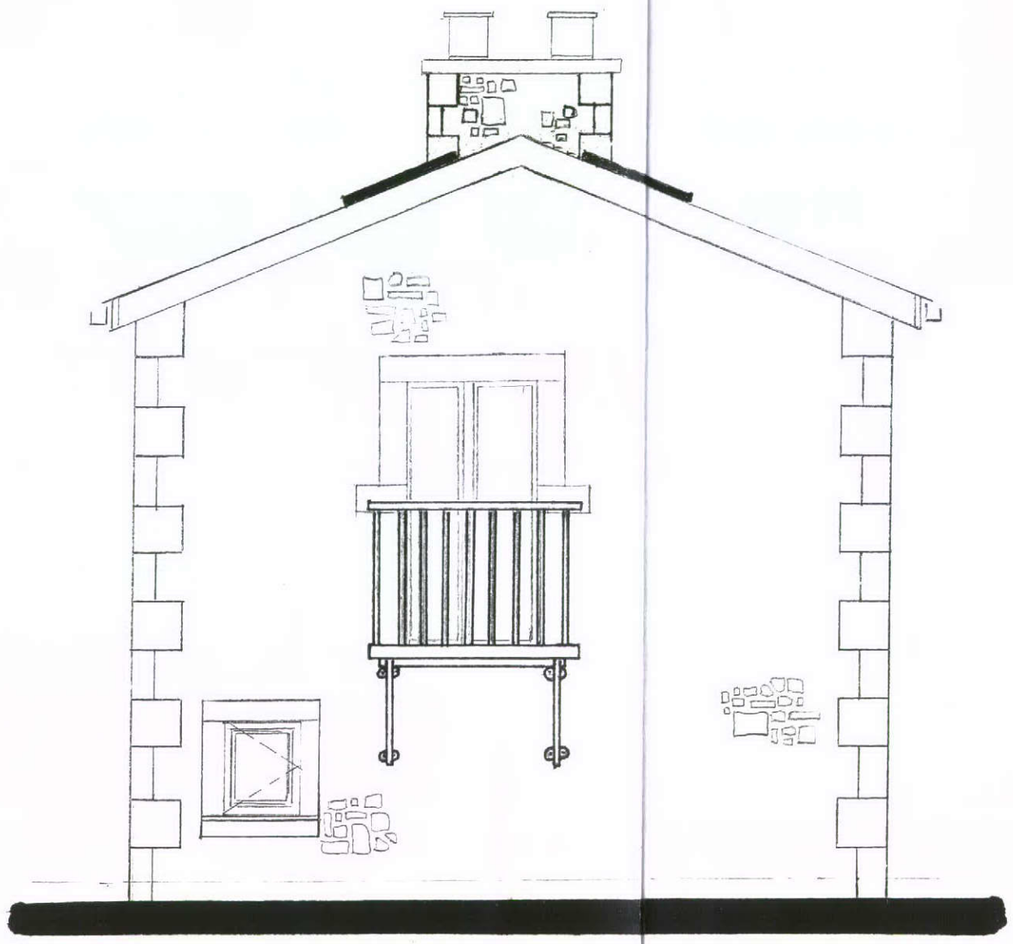

AS BUILT END ELEVATION

MATERIALS
1) STONE SURROUNDS TO JAMBS, HEAD AND SILLS TO MATCH EXISTING
2) BRACKET SUPPORTS, CAST IRON RECLAIMED VICTORIAN.
3) HAND RAIL, WELDED SQUARE STEEL CONSTRUCTION
4) DOUBLE DOORS, OPENING IN, UPVC GOLDEN OAK, FULLY GLAZED TOUGHENED 'E' GLASS.

SCALE :- 1 : 50	LOCATION 1, MEVRIL ROAD, WHALEY BRIDGE, HIGH PEAK, DERBYSHIRE.
SHEET 3 OF 3	
DRAWN BY CH-W	
DATE :- 2-12-10	