HPK/2010/0656

RECEIVED
09 DEC 2010

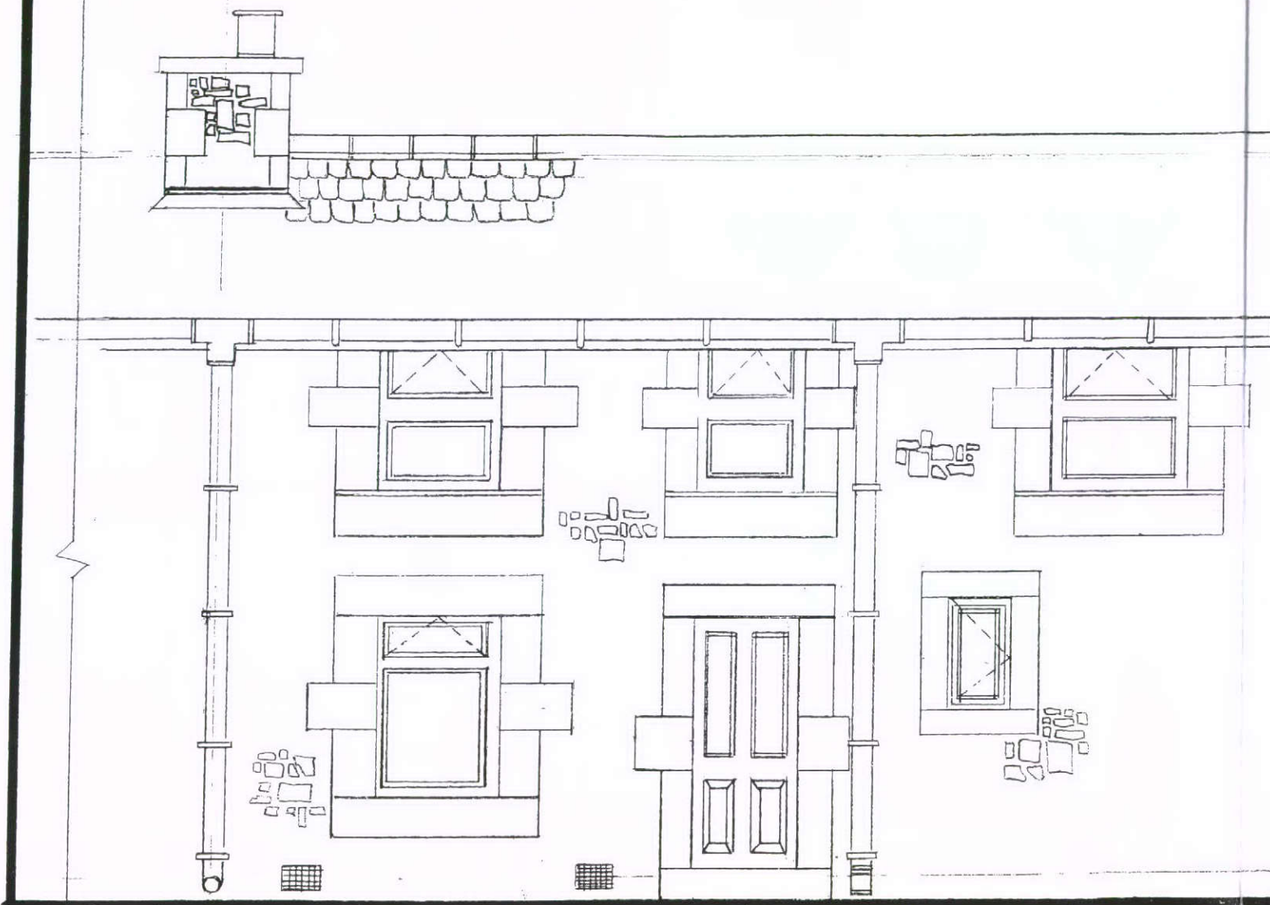

AS BUILT FRONT ELEVATION

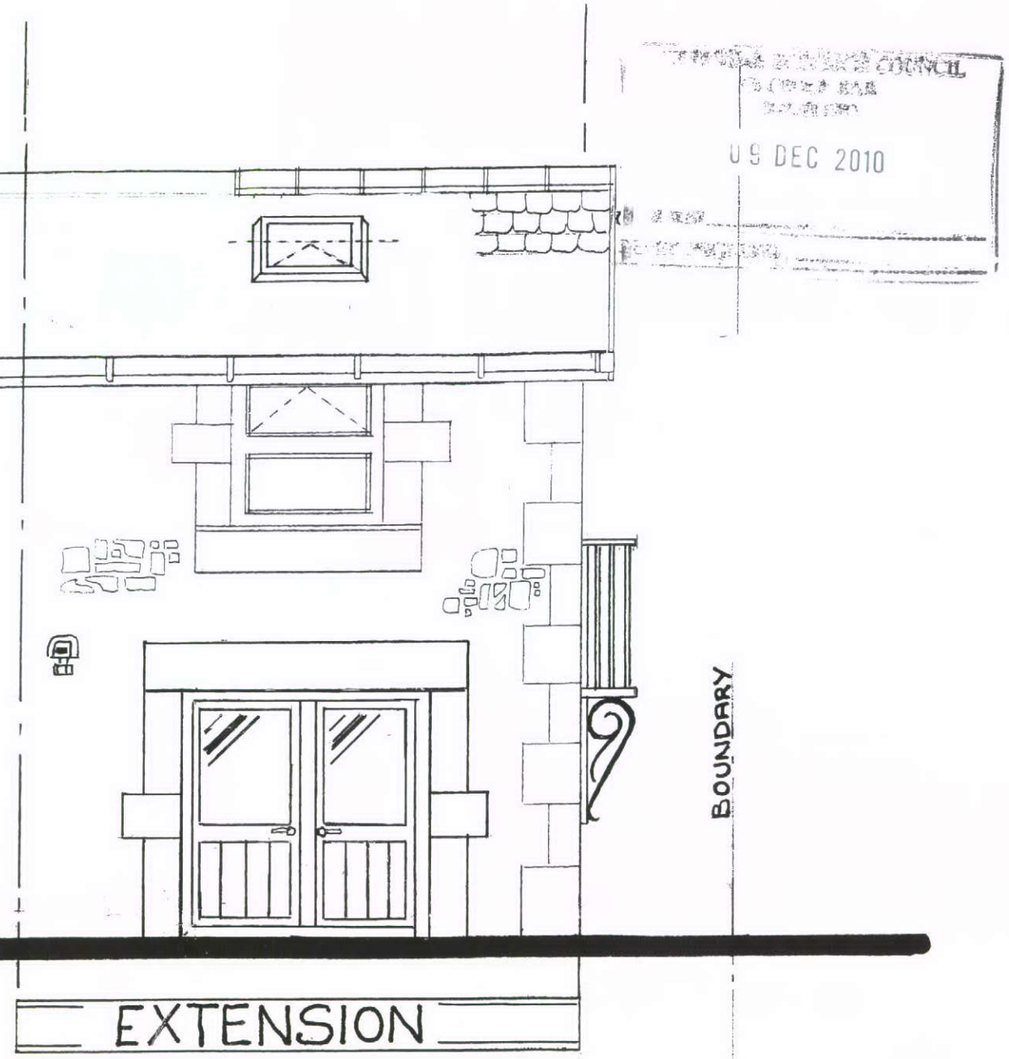

EXTENSION

MATERIALS
1) WALLS – NATURAL GRITSTONE RANDOMLY LAID - FEATURE STONE QUOINS.
2) ROOF - SECONDHAND WELSH BLUE SLATES TO MATCH EXISTING.
3) WINDOWS - U.P.V.C. (COLOUR GOLDEN OAK), STONE SURROUNDS TO JAMBS, HEAD AND SILLS TO MATCH EXISTING.
4) EAVES AND BARGEBOARD – U.P.V.C (COLOUR GOLDEN OAK)
5) RWP AND RAINWATER GOODS - BLACK PLASTIC
6) GARAGE DOORS - U.P.V.C. (COLOUR GOLDEN OAK) HALF GLAZED.
7) 150w PIR FLOOD LIGHT TO LEFT OF GARAGE DOORS.
8) VELUX WINDOW TO FRONT PITCH OF ROOF.

SCALE :- 1 : 50	LOCATION 1, MEVRIL ROAD, WHALEY BRIDGE, HIGH PEAK, DERBYSHIRE
SHEET 1 OF 3	
DRAWN BY CH-W	
DATE :- 2-12-10	