HPK/2010/0656

RECEIVED
03 DEC 2010

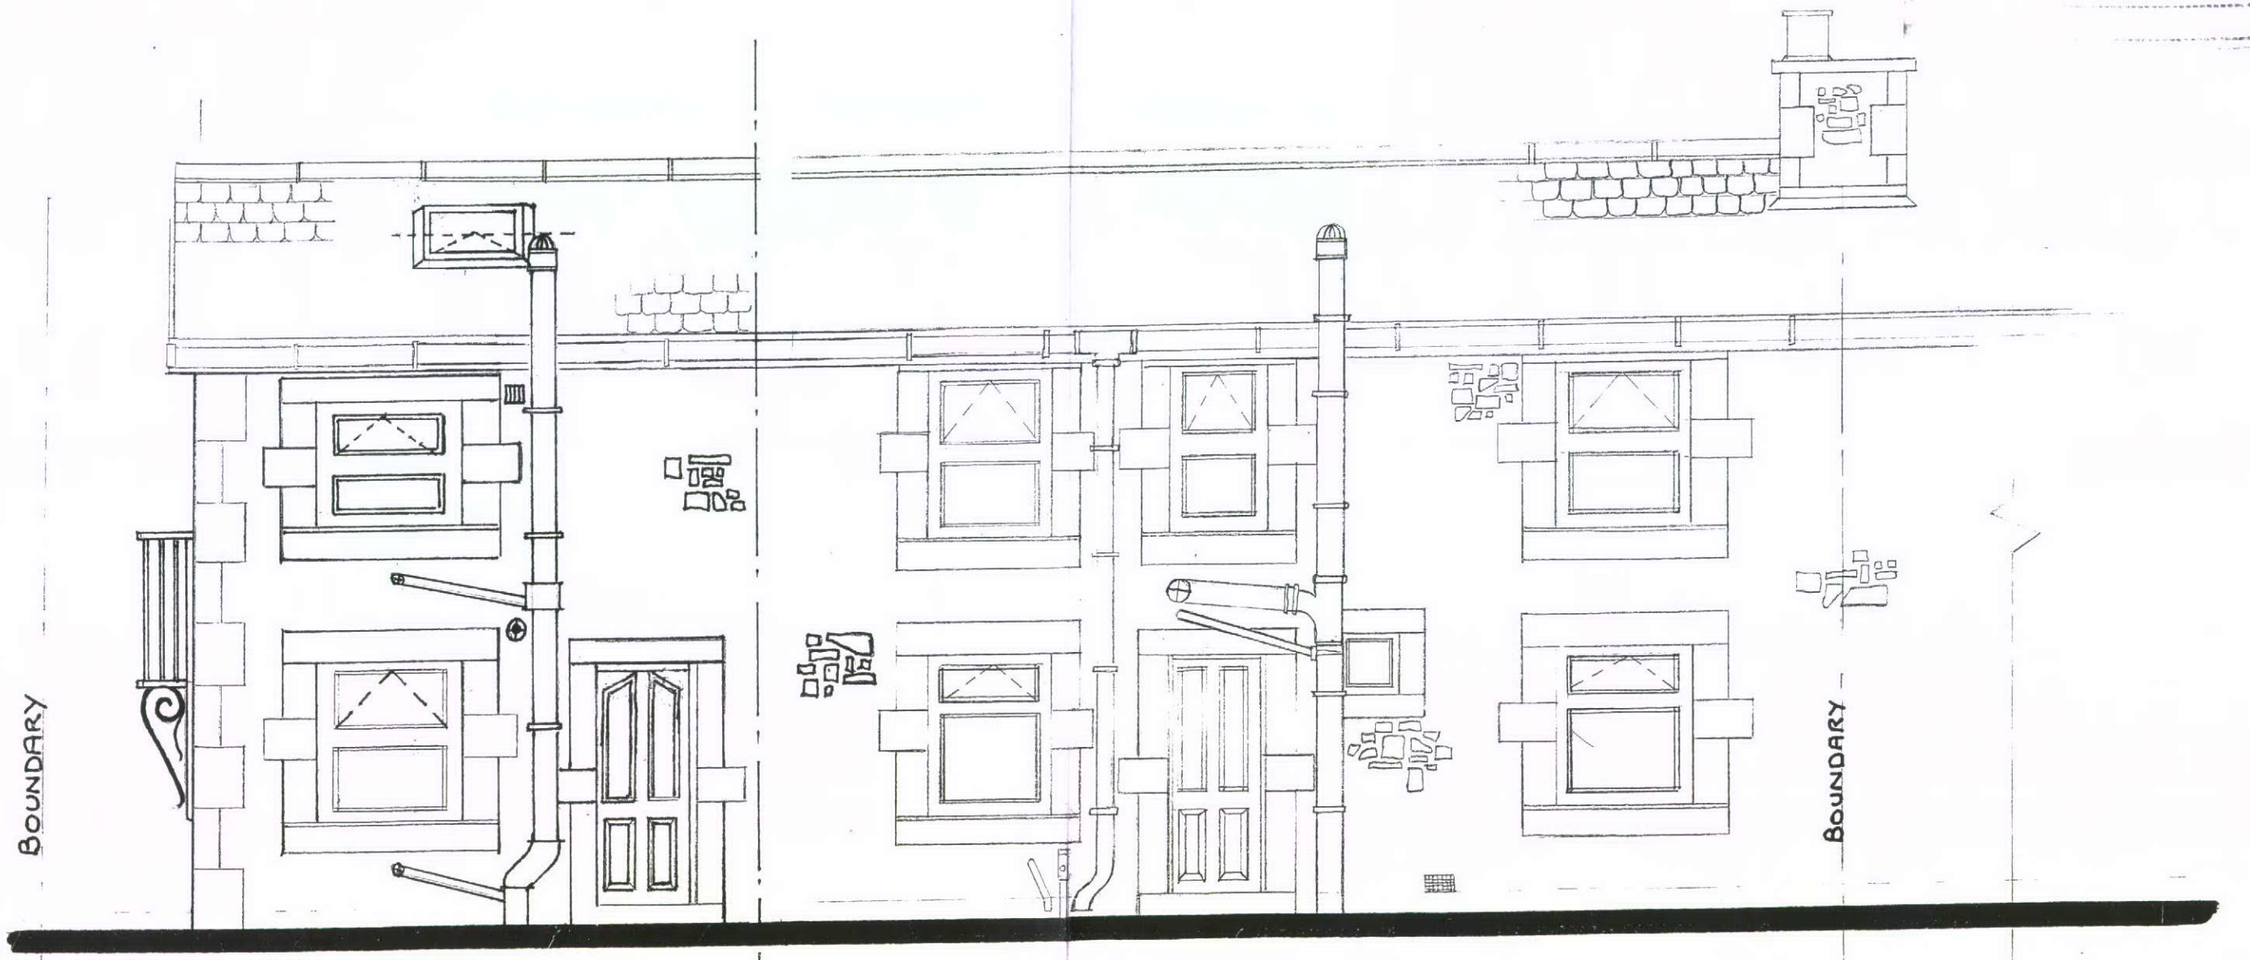

EXTENSION

AS BUILT. REAR ELEVATION

MATERIALS	
1)	WALLS – NATURAL GRITSTONE RANDOMLY LAID – FEATURE STONE QUOINS.
2)	ROOF – SECONDHAND WELSH BLUE SLATES TO MATCH EXISTING.
3)	WINDOWS - U.P.V.C. (COLOUR GOLDEN OAK). STONE SURROUNDS TO JAMBS, HEAD, AND SILLS TO MATCH EXISTING.
4)	EAVES AND BARGEBOARD – U.P.V.C. (COLOUR GOLDEN OAK)
5)	VELUX WINDOW TO REAR PITCH OF ROOF
6)	RWP AND RAINWATER GOODS – BLACK PLASTIC

SCALE :– 1:50	LOCATION 1, MEVRIL ROAD, WHALEY BRIDGE, HIGH PEAK, DERBYSHIRE.
SHEET 2 OF 3	
DRAWN BY CH-W	
DATE :– 2-12-10	