HPK/2010/0623

OS Sitemap®

21 DEC 2010

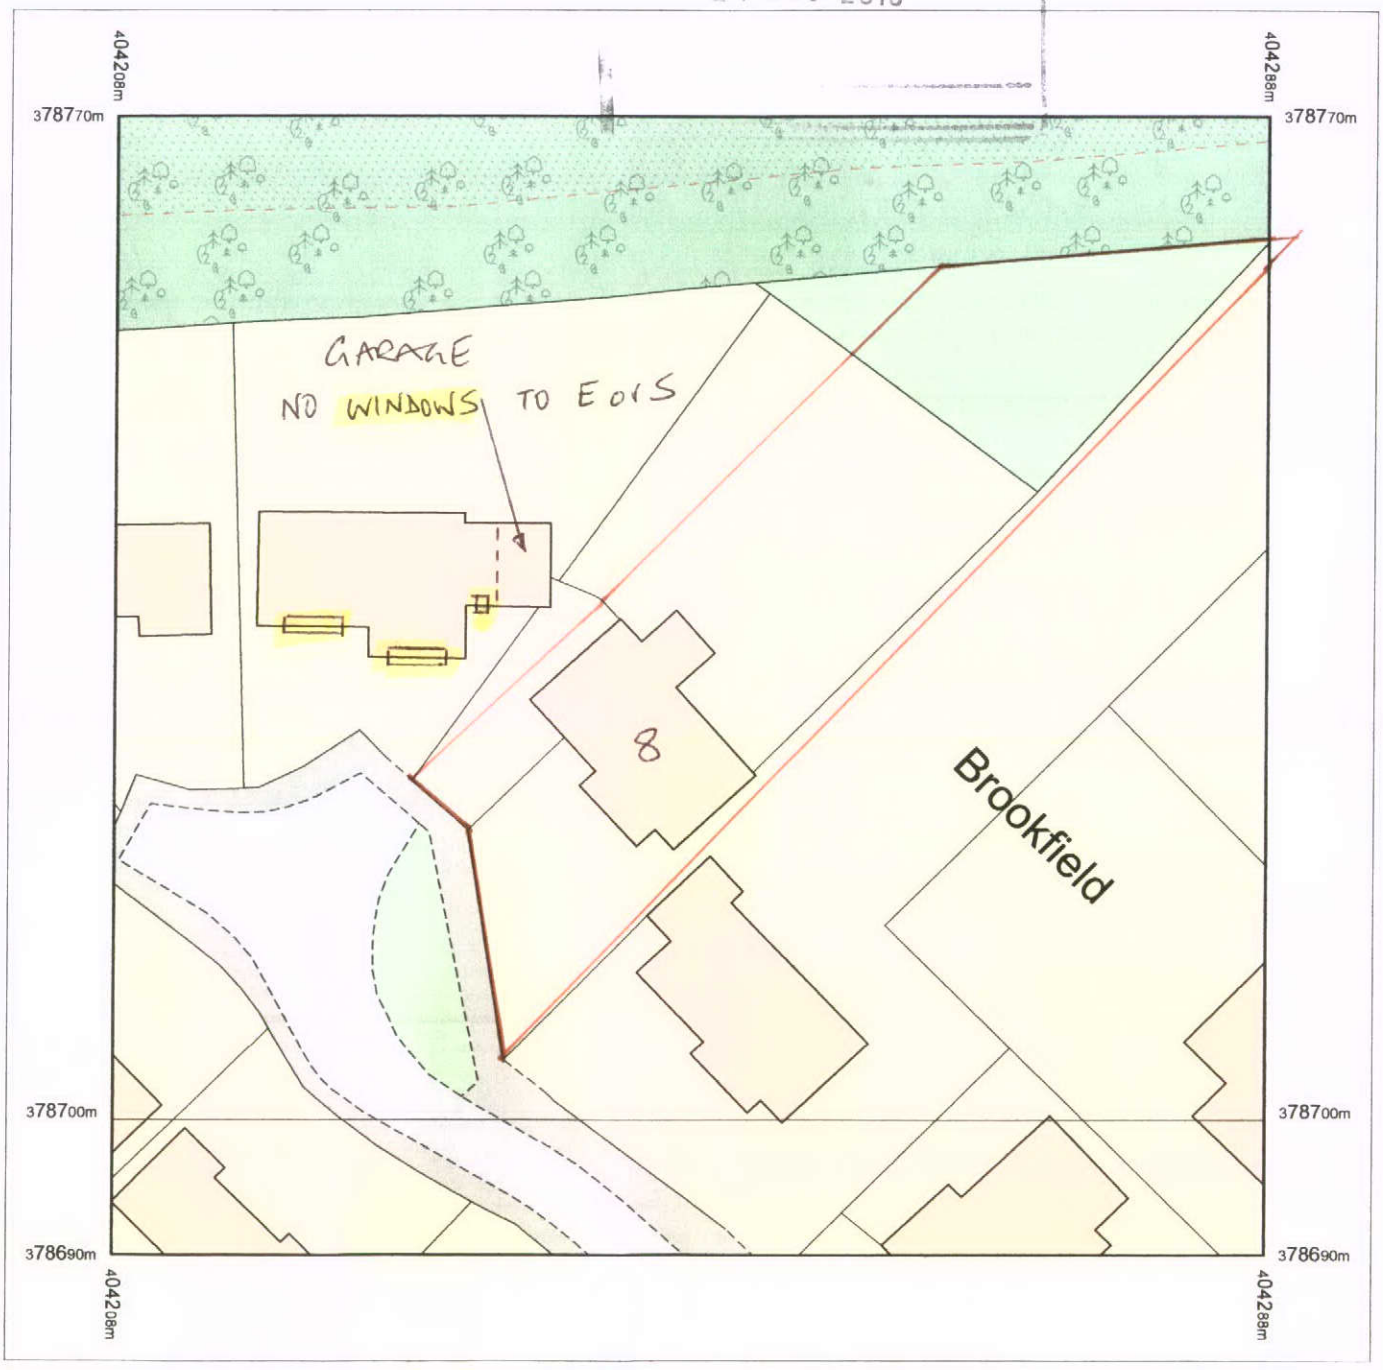

Produced 14.12.2010 from the Ordnance Survey National Geographic Database and incorporating surveyed revision available at this date. © Crown Copyright 2010.

Reproduction in whole or part is prohibited without the prior permission of Ordnance Survey.

Ordnance Survey, the OS Symbol and OS Sitemap are registered trademarks of Ordnance Survey, the national mapping agency of Great Britain.

The representation of a road, track or path is no evidence of a right of way.

The representation of features as lines is no evidence of a property boundary.

Part or all of this OS Sitemap is enlarged from mapping produced at one or more of the following scales: 1:1250, 1:2500, 1:10000.

Metres
0 5 10 15 20

Scale 1:500

Supplied by: **Outlet User**
Serial number: 00003900
Centre coordinates: 404248 378730.5

Further information can be found on the OS Sitemap Information leaflet or the Ordnance Survey web site: www.ordnancesurvey.co.uk

BOUNDARIES SHOWN ON SITE MAP INCORRECT

CORRECT BOUNDARIES SHOWN IN RED