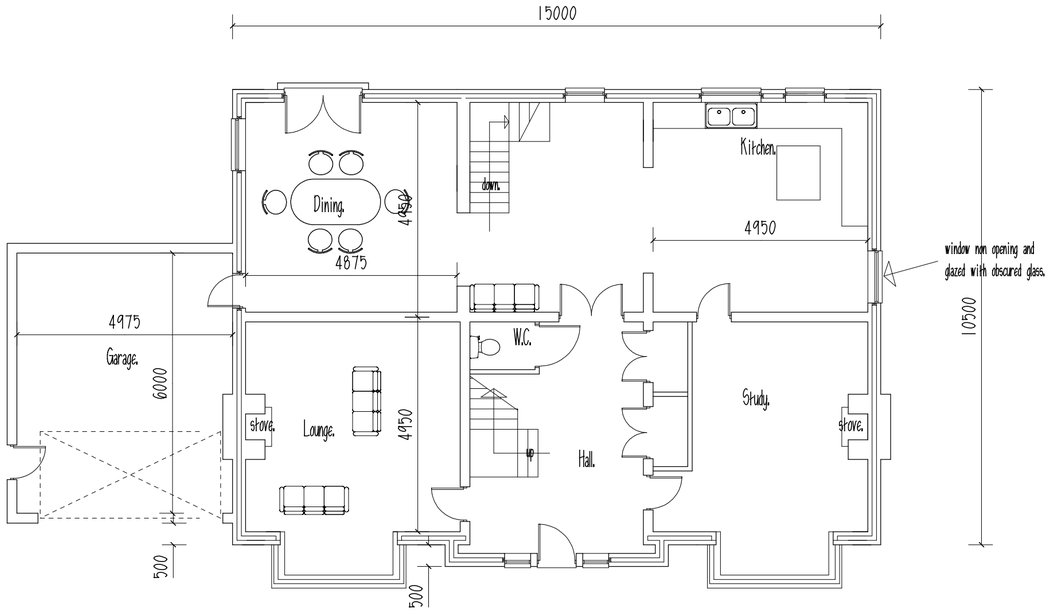

Proposed ground floor plan.

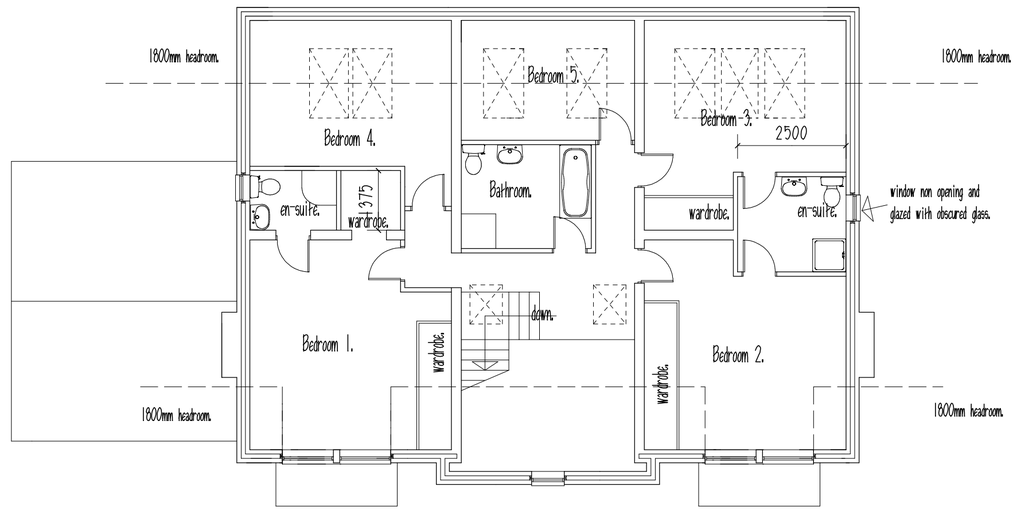

Proposed first floor plan.

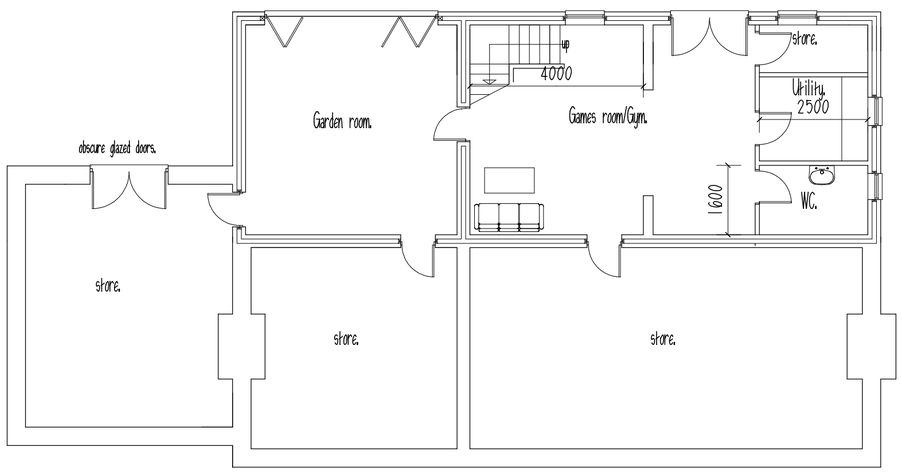

Proposed basement floor plan.

REVISIONS:
A. Depth of bldg reduced. Dec 08.
B. Gen. amendments. Dec. 08.
C. O/all size of unit reduced. March 08.
D. O/all dims reduced. May 09.
E. Width of unit reduced. May 09.
F. Depth of garage reduced. June 09.
G. GEN ALTS. TO AS BUILT 17.11.10

PLANMART

Client:
Mr & Mrs Bramall,

Project:
Proposed 5 bedroomed detached dwelling
at 34 Simmondley New Road, Glossop.

Title:
Proposed plans.

Scale: 1:100. A2 sheet.

Drawn:	Date:
MH	Nov 08.
Project no.: 2243.	Drawing no.: 2243-6F.

PLANMART LIMITED
53A High St. West, Glossop,
Derbyshire SK13 8AZ.
Tel: 01457 863153 E mail: planmart@btconnect.com

THIS DRAWING IS NOT TO BE COPIED OR REPRODUCED
WITHOUT THE PRIOR WRITTEN CONSENT OF PLANMART LTD.