
HPK/2011/0009

| | |
|---|---|
| SITE | 10 High Street Chapel en le Frith |
| CLIENT | Nigel Webb |
| TITLE | Proposed FF House |
| DWG NO. | 0187.P.108 |
| DATE | October 2008 |
| SCALE | 1:50 |

as approved and, for unit 4, as built.

HIGH PEAK BOROUGH COUNCIL
GLOSSOP SITE
RECEIVED
17 JAN 20[illegible]
FILE REF
REPLY REQUIRED

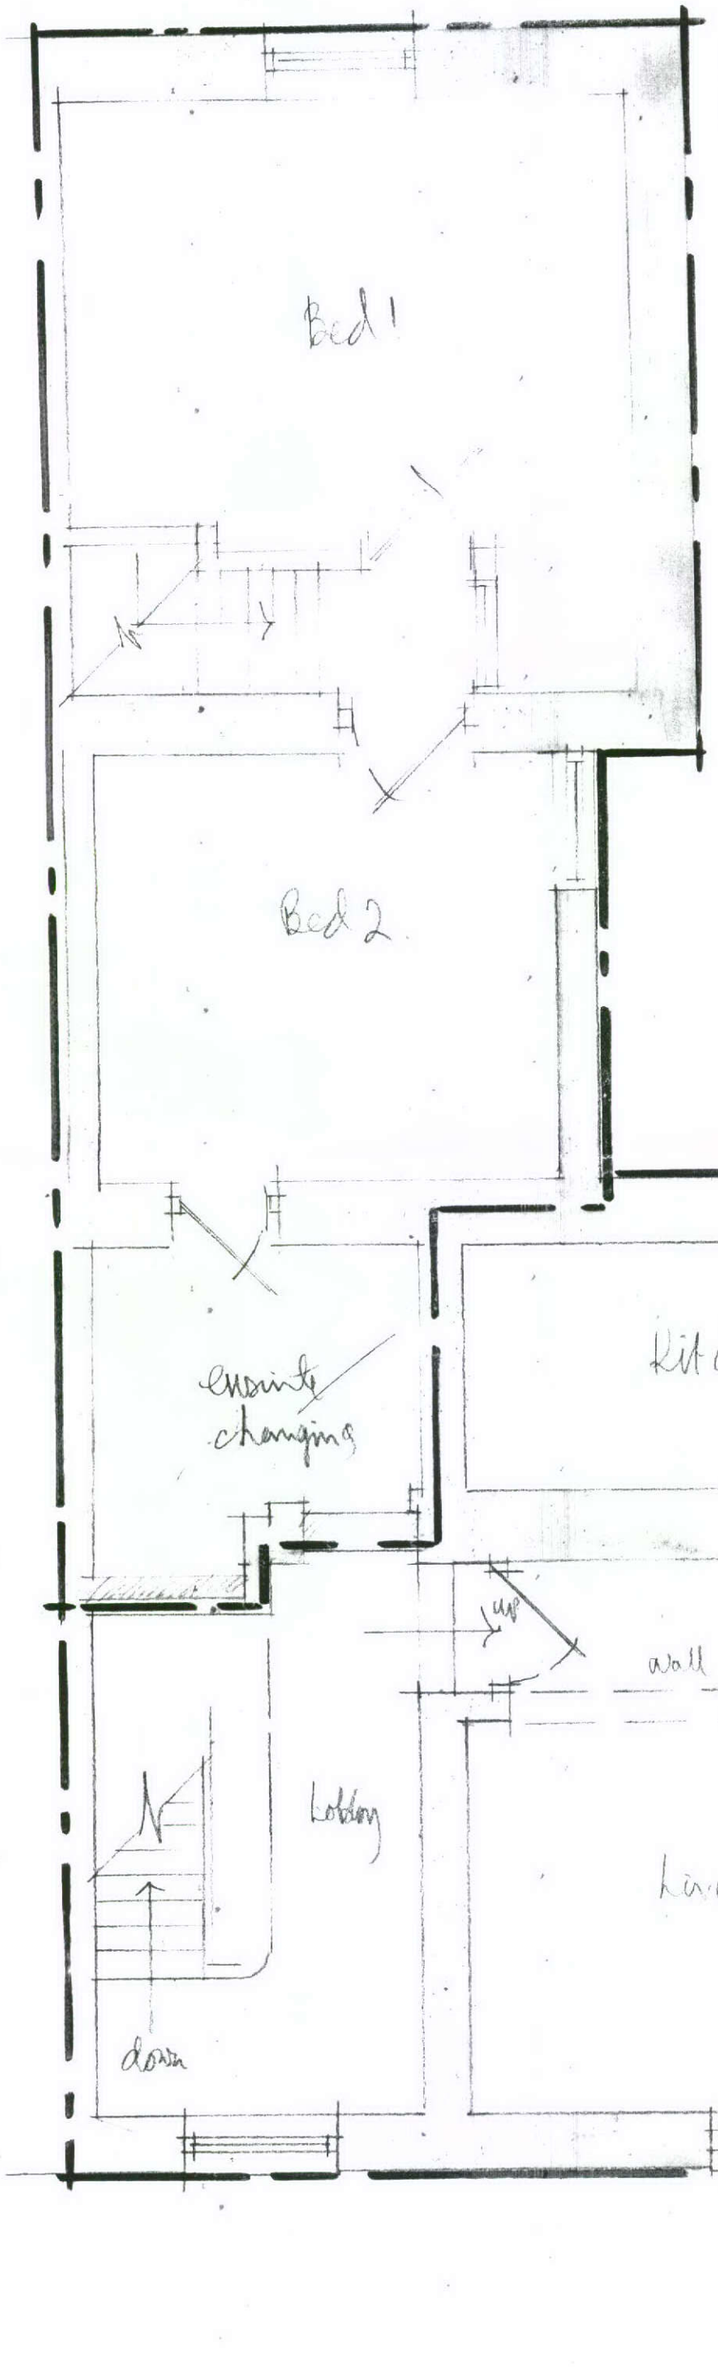


UNIT 4.

CAMplan