NMA/2011/0022

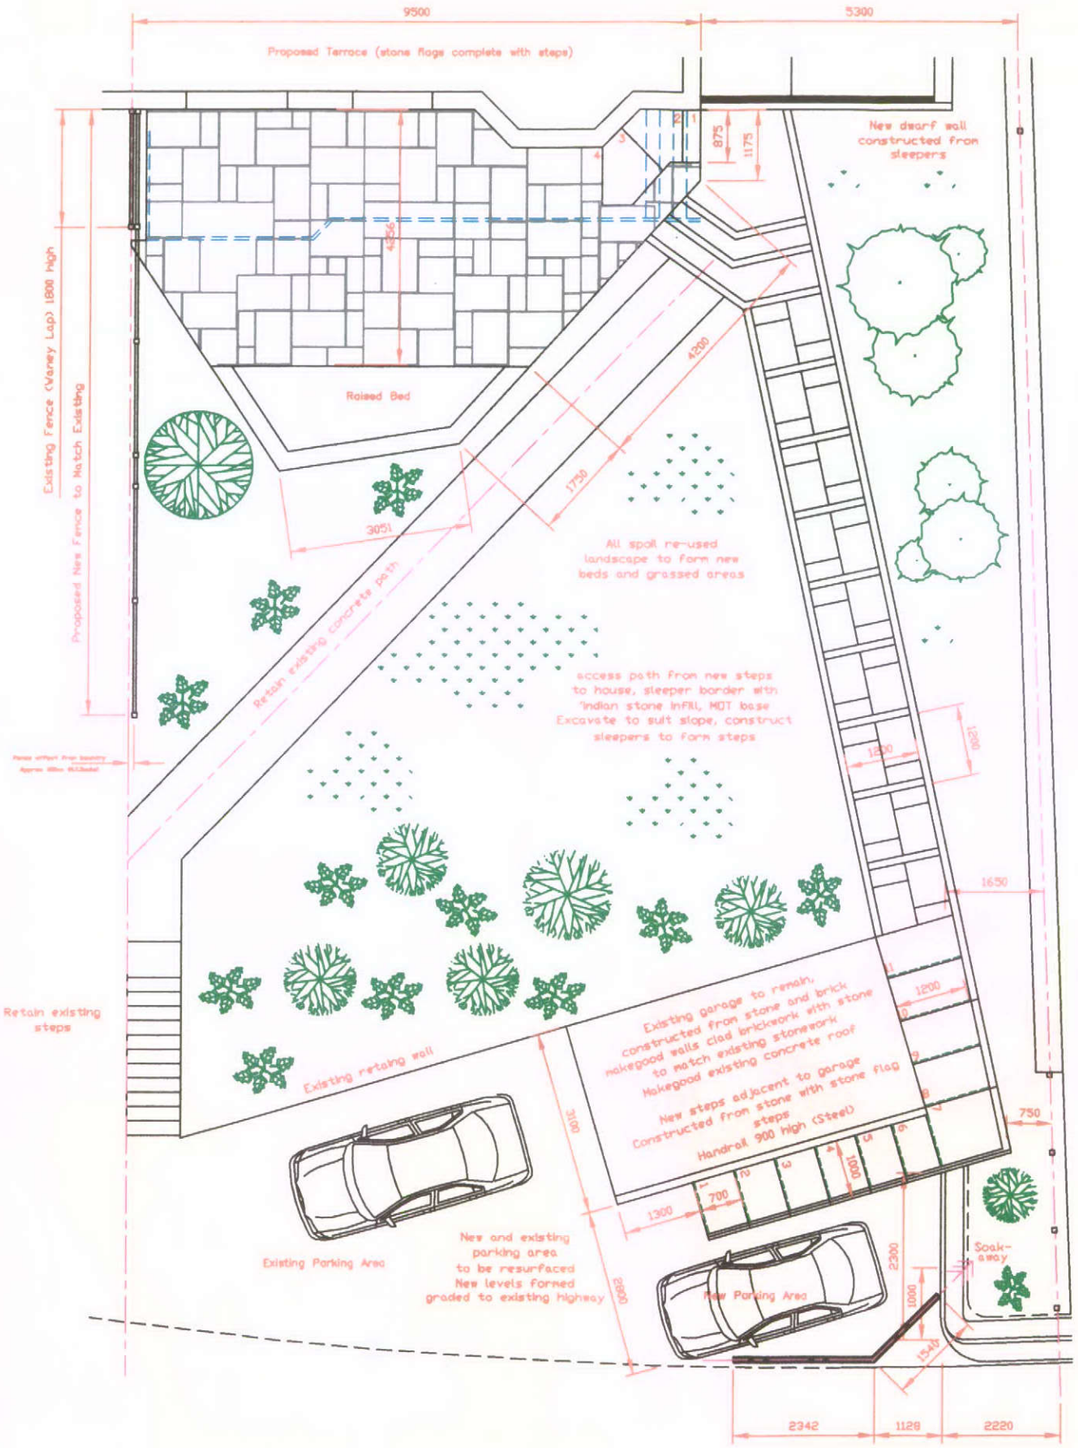

Material Ammendment
parking area
Rev'B' to be resurfaced 'Tarmac'
New levels formed
graded to existing highway
Top water diverted via arco drainage system
to new soak away below landscaped area

Part Plan (Front Garden)

Scale 1:100

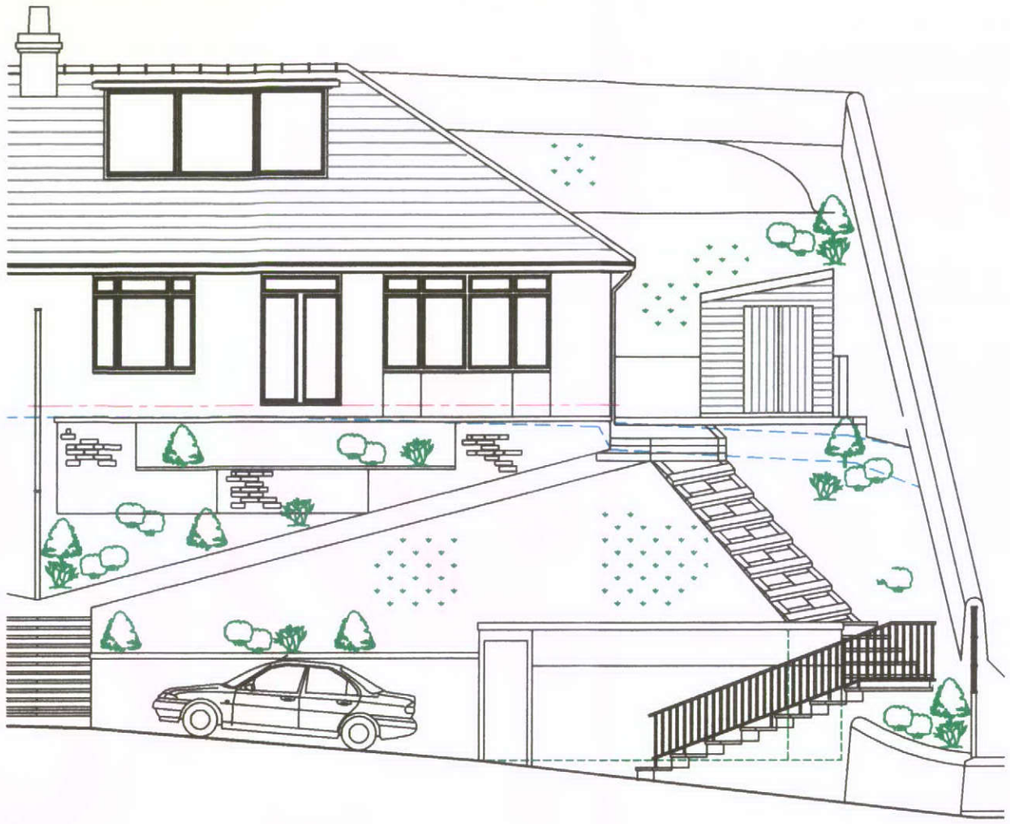

Elevation

Scale 1:100

No.	DESCRIPTION	DATE	BY
B	Material Ammendment – As Built	02–05–11	MW
A	ammdments to parking area dims added, boundry fence repositioned	25–10–10	MW

THIS DRAWING IS COPYRIGHT AND NO PORTION SHOULD BE COPIED OR REPRODUCED WITH OUT CONSENT OF M J WHELAN
DO NOT SCALE, DRAWING ERRORS OR OMISSIONS ARE TO BE REPORTED AND CHECKED WITH DESIGN OFFICE

M J Whelan
Design and Build
Design and Planning Services

M J Whelan Design and Build
49 Elnor Lane
Whaley Bridge, High Peak
Derbyshire
SK23 7EU
Tel.01663735472–07759483369
mike@whelandesign.co.uk

Scale 1:100@A3

Issue Date Sept2010 | Rev. B

Job–ref —

DESCRIPTION Mr & Mrs Watts Malvern Start Lane Whaley Bridge
Proposed Layout – Front Garden

DRWG No. 002

Form ref 000 Issue 1 Design (C:)Work\A3Drawing Sheet