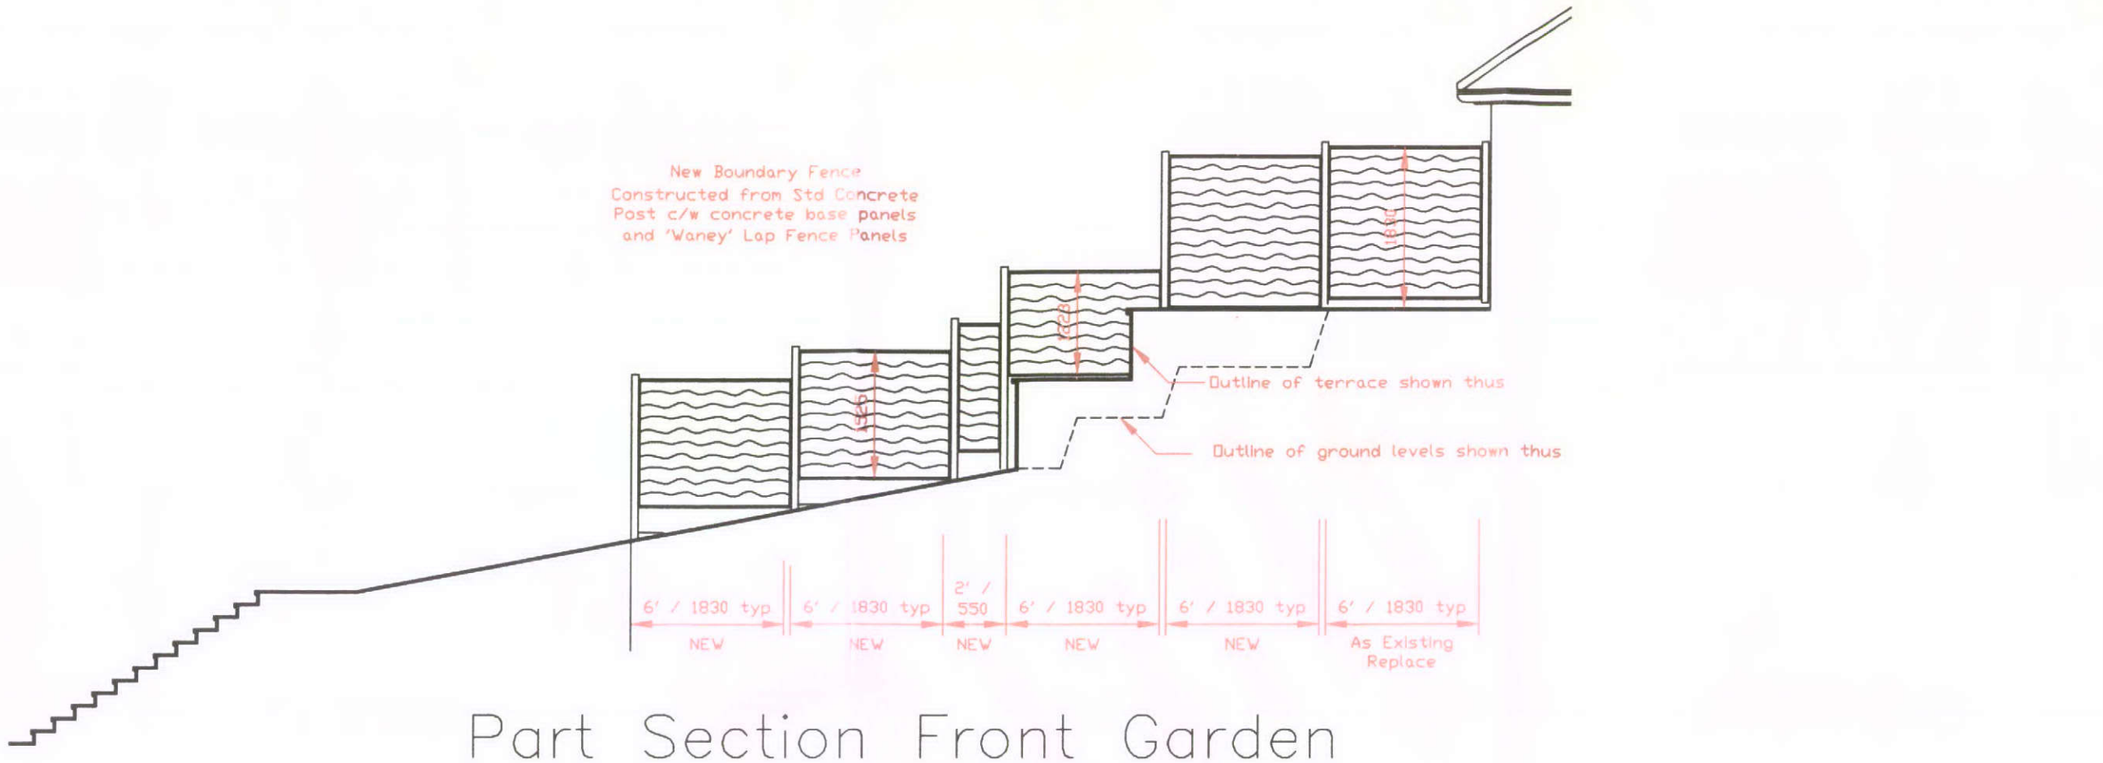

Part Section Front Garden

Scale 1:100

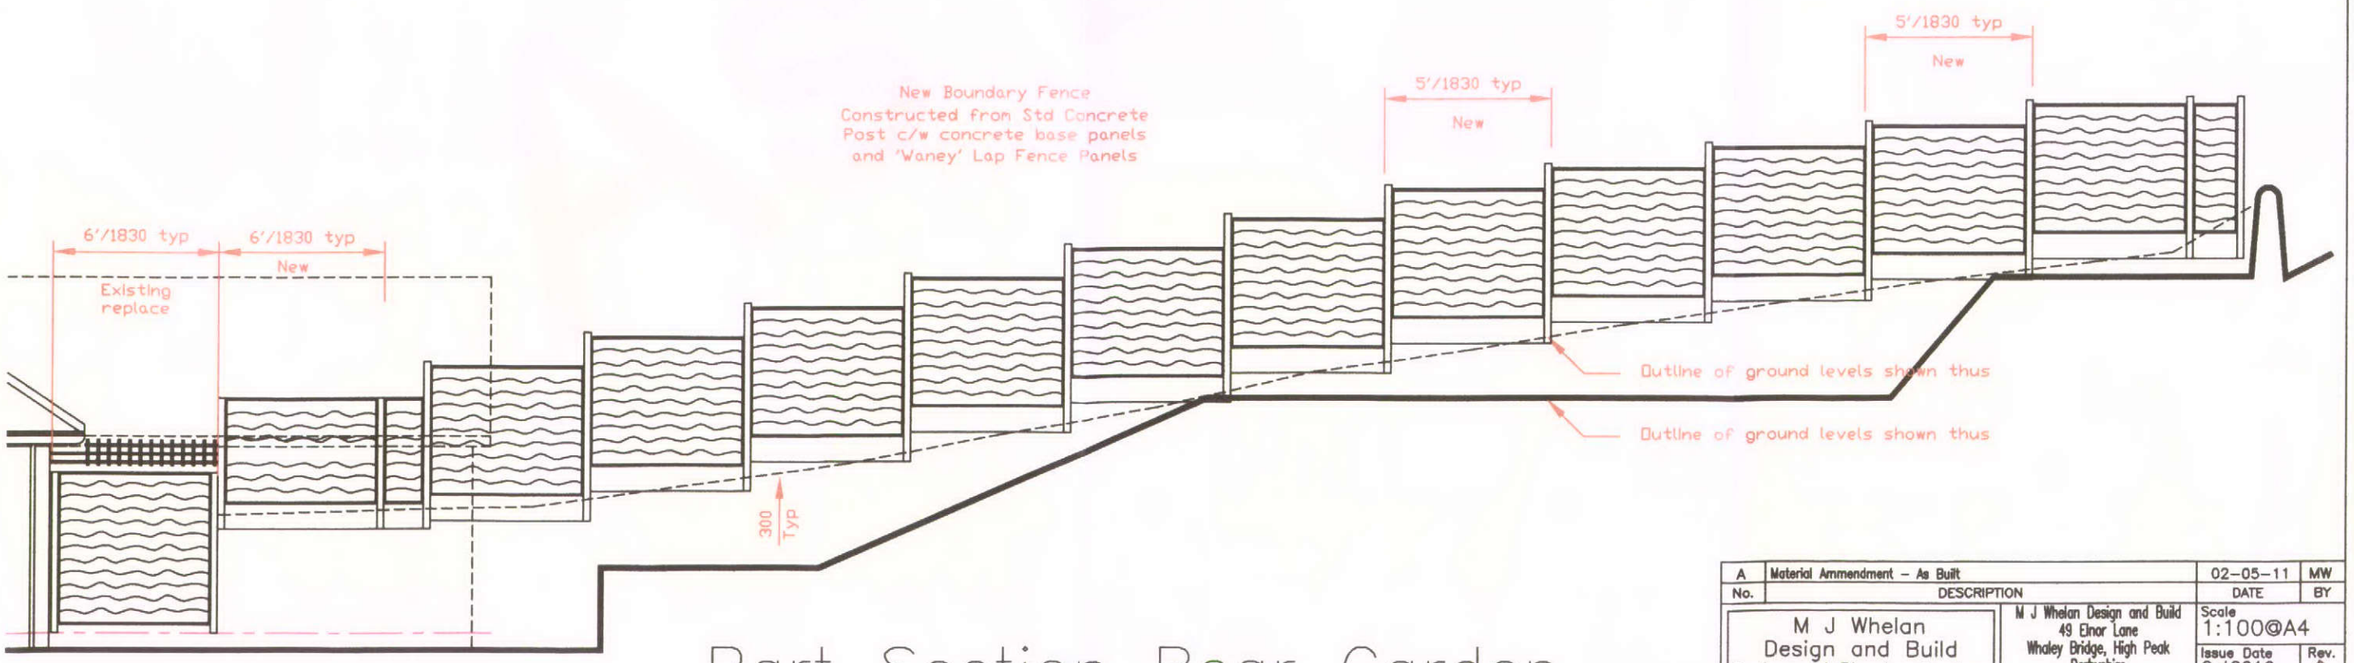

Part Section Rear Garden

Scale 1:100

No.	DESCRIPTION	DATE	BY
A	Material Ammendment – As Built	02–05–11	MW

M J Whelan
Design and Build
Design and Planning Services

THIS DRAWING IS COPYRIGHT AND NO PORTION SHOULD BE COPIED OR REPRODUCED WITH OUT CONSENT OF M J WHELAN
DO NOT SCALE, DRAWING ERRORS OR OMISSIONS ARE TO BE REPORTED AND CHECKED WITH DESIGN OFFICE

M J Whelan Design and Build
49 Elnor Lane
Whaley Bridge, High Peak
Derbyshire
SK23 7EU
Tel.01663735472–07759483369
mike@whelandesign.co.uk

Scale 1:100@A4
Issue Date Oct2010
Rev. A
Job–ref —
DRWG No. 004

DESCRIPTION Mr & Mrs Watts Malvern Start Lane Whaley Bridge
Proposed Layout – Boundry Fence

Form ref 000 Issue 1 Design (C:)Work\A3Drawing Sheet