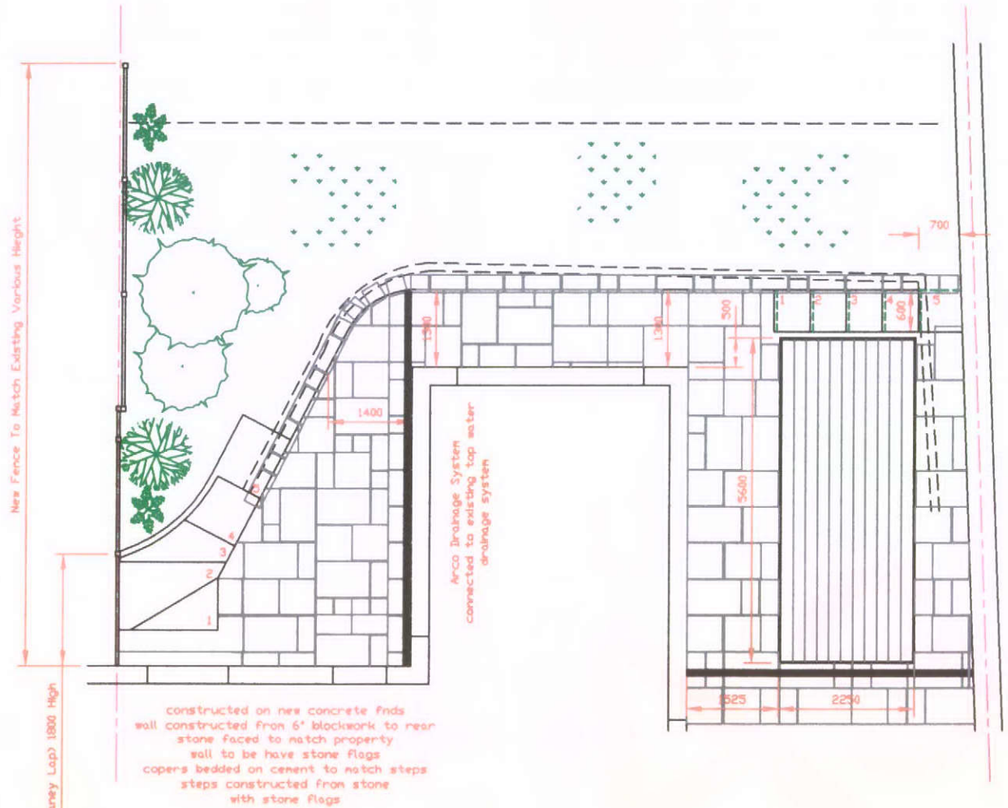

Part Plan (Rear Garden)

Scale 1:100

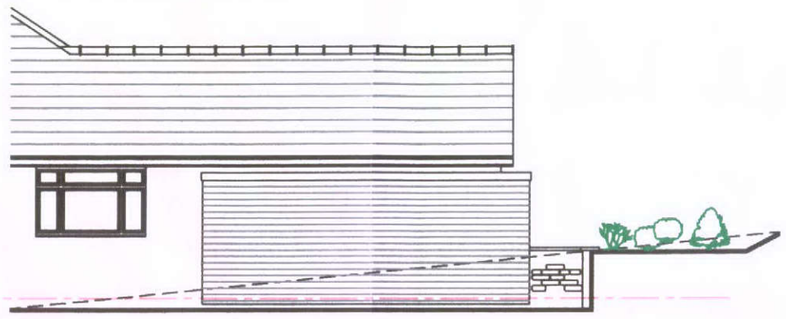

Sectional Elevation

Scale 1:100

No.	DESCRIPTION	DATE	BY
B	Material Ammendment – As Built	02–05–11	MW
A	Paving ammend rear of shed – Arco drainage / dwarf retain wall add	16–03–11	MW

M J Whelan
Design and Build
Design and Planning Services

THIS DRAWING IS COPYRIGHT AND NO PORTION SHOULD BE COPIED OR REPRODUCED WITH OUT CONSENT OF M J WHELAN
DO NOT SCALE, DRAWING ERRORS OR OMISSIONS ARE TO BE REPORTED AND CHECKED WITH DESIGN OFFICE

M J Whelan Design and Build
49 Elnor Lane
Whaley Bridge, High Peak
Derbyshire
SK23 7EU
Tel.01663735472–07759483369
mike@whelandesign.co.uk

Scale 1:100@A3

Issue Date Sept2010 | Rev. B

Job–ref —

DESCRIPTION Mr & Mrs Watts Malvern Start Lane Whaley Bridge
Proposed Layout – Rear Garden

DRWG No. 003

Form ref 000 Issue 1 Design (C:)Work\A3Drawing Sheet