

BDK/2011 /0481

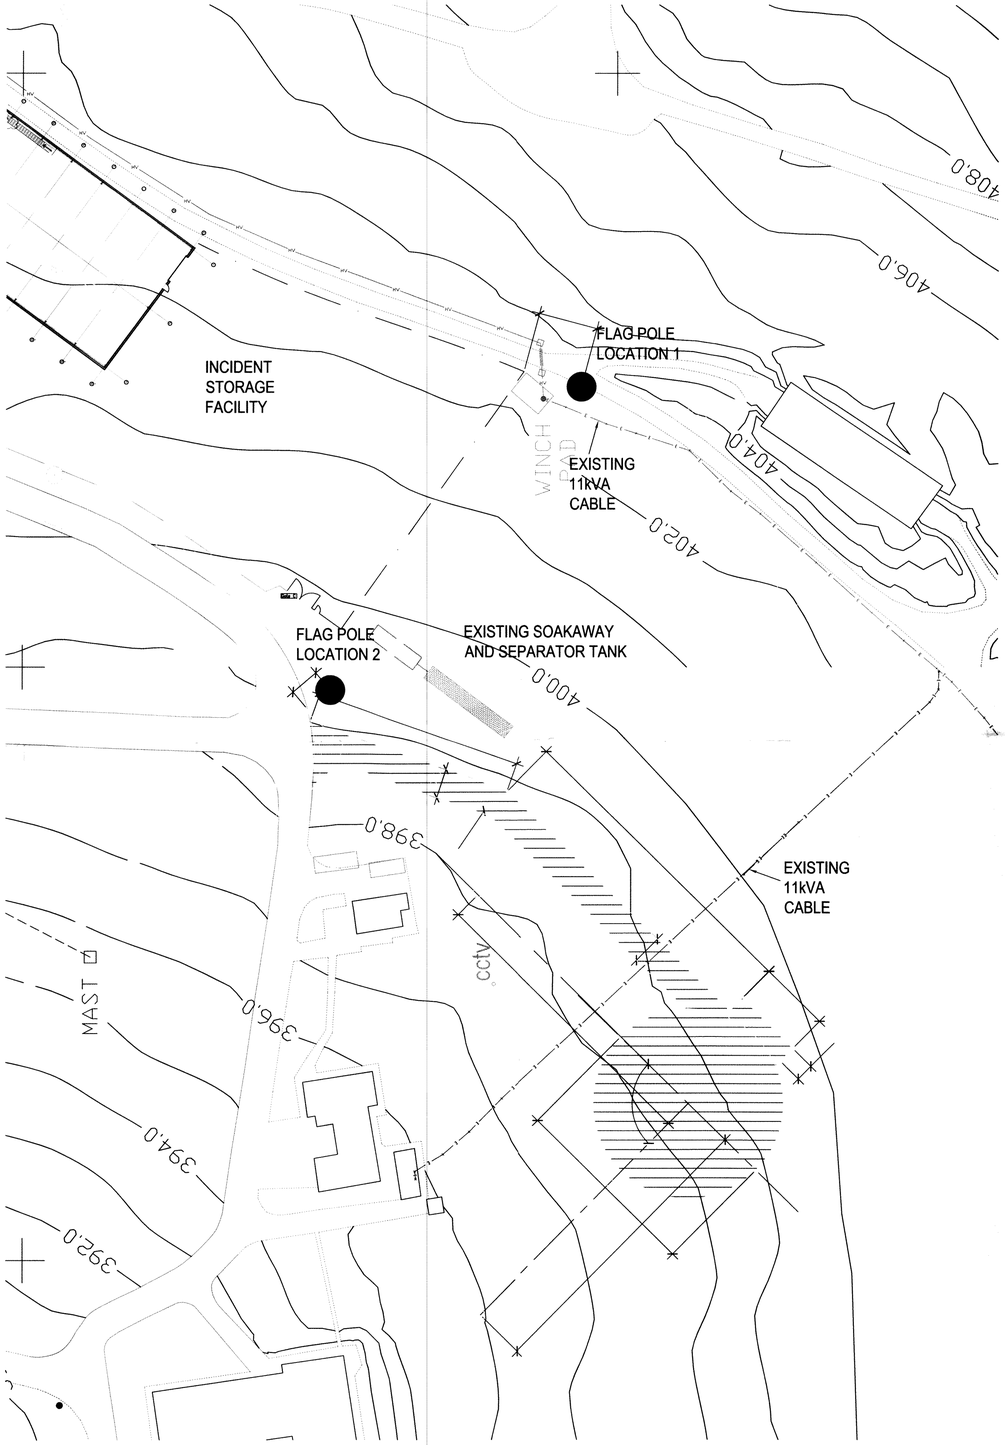

PROPOSED EXPLOSIVES TEST PAD
SCALE 1:1250

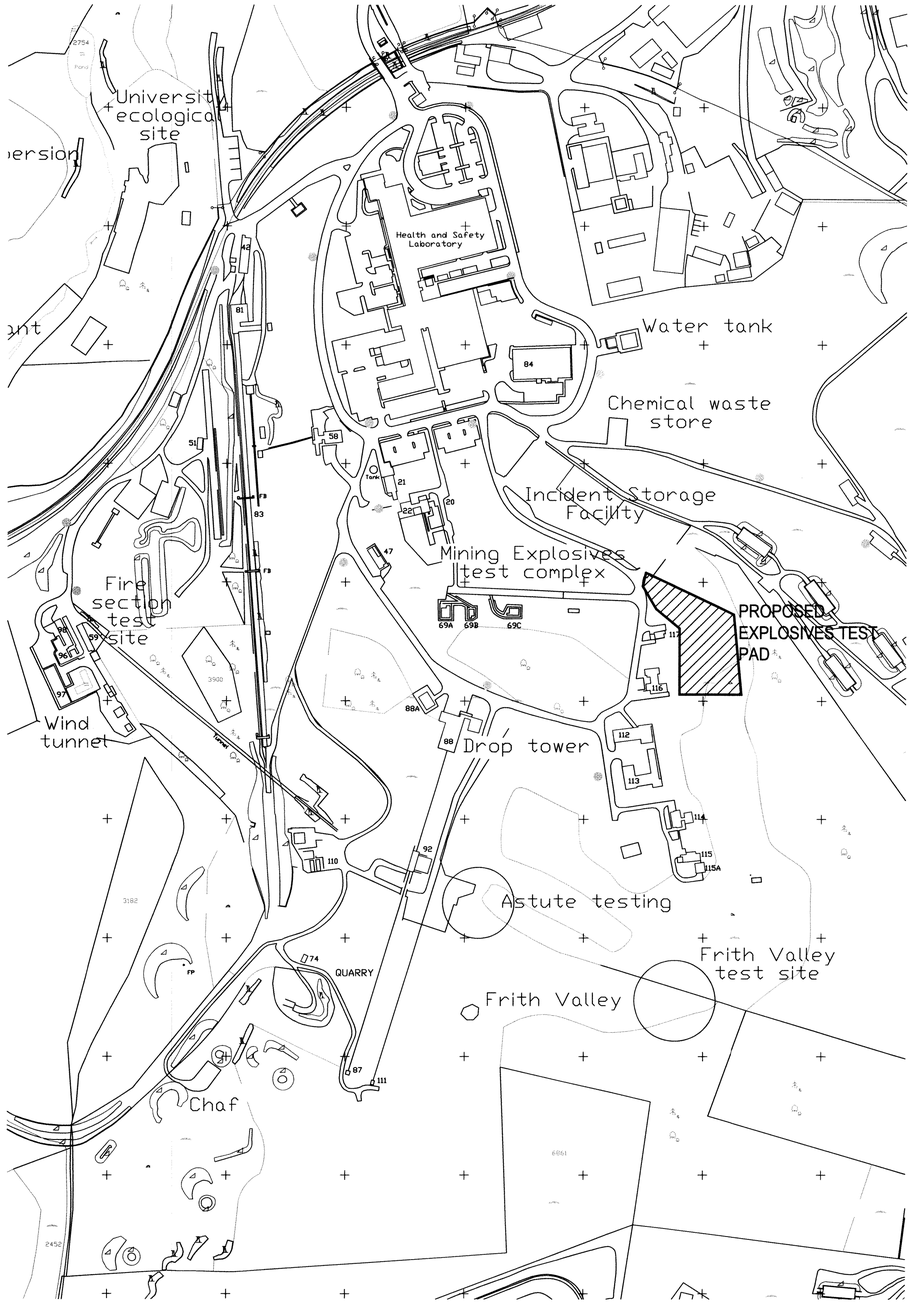

SITE LOCATION OF PROPOSED EXPLOSIVES TEST PAD
SCALE 1:2500

BUILDING DESIGN PARTNERSHIP SHALL HAVE NO RESPONSIBILITY FOR ANY USE MADE OF THIS DOCUMENT OTHER THAN FOR THAT WHICH IT WAS PREPARED AND ISSUED.

ALL DIMENSIONS SHOULD BE CHECKED ON SITE.

DO NOT SCALE FROM THIS DRAWING.

ANY DRAWING ERRORS OR DIVERGENCES SHOULD BE BROUGHT TO THE ATTENTION OF BUILDING DESIGN PARTNERSHIP AT THE ADDRESS SHOWN BELOW.

NOTES

ALL STEELWORK TO BE GALVANISED.

SHEETING TO BE KINGSPAN OR SIMILAR.

PEAK FOREST PARISH COUNCIL
CLERK'S SITE
RECEIVED
3 AUG 2011
FILE REF
REPLY REQUIRED

RECORD DRAWING

THIS DRAWING HAS BEEN REVISED TO INCORPORATE CHANGES MADE ON SITE BY ADMIRAL CONSTRUCTION.
IT CAN NOT BEEN GUARENTEED BY BDP AS BEING THE ONLY REVISIONS.

REVISION B	PB	BDP	02:06:2011
AS BUILT			
REVISION A	PB	BDP	12:10:2010
ROAD AND SLAB MOVED POSITION BY APPROX 5m . SLAB THICKNESS REVISED. SECTION THROUGH LAUNCH PAD ADDED. REVISED TO SUIT ADMIRAL CONSTRUCTION LETTER 26 08 10			
REVISION -	PB	BDP	30:07:2010
FIRST ISSUE			
FIRST ISSUE			
REVISION DESCRIPTION	DRAWN	CHECKED	DATE

CLIENT

BDP.

1 North Bank
Sheffield S3 8JY
United Kingdom
T +44 (0)114 273 1641
F +44 (0)114 228 9925
www.bdp.com

PROJECT TITLE
HSL BUXTON
PROPOSED EXPLOSIVES TEST PAD

DRAWING TITLE
PROPOSED SITE LOCATION PLAN

SCALE @ A1
VARIES

DATE

PROJECT NUMBER
P2004013

DRAWING No.

REVISION
B