

A

Sainsbury's Local
Cash machine

Externally illuminated projecting sign with 5mm wall plate & 50x3mm steel CHS arm. Arm to have 2no. 20mm mild steel flat bar welded to accept 2mm all panel. Gussets to be fitted to bottom & sides of CHS. Illuminated by 2no. mini trulight troughs mounted to frame using modified bracket.

Aluminum panel with face applied vinyl.

ATM background vinyl printed with "Free cash withdrawals" is to be internally applied to glazing with orange fascia surround

Proposed aluminium framed glazing system, charcoal grey in colour to RAL 7022.
Entrance door to be 1500 wide single sliding automatic door; 1400 clear opening required to receive refrigeration cabinets.

New non standard Sainsbury's 350mm deep sign vinyl text applied to fascia, signage to be externally illuminated
All dimensions tbc on site.


Opening times and services apply as white Vinyl letters to the inside of glazing.
All opening hours, offers and services are to be confirmed by Sainsbury's PM prior to manufacturer of signage

Manifestation to clear glazing 50mmØ, frosted vinyl equally spaced at normal 150 centres, in two rows at 900mm & 1500mm to centre of circles above finished floor level


Opening times to 162mm High white fret cut out of aluminium back panel fascia and externally illuminated. Fascia decorated in Sainsbury's Plum pantone 1955c Dulux 76RR 08/316. All dims tbc on site

1 no. Delivery/Car park poster frame applied externally to wall

## PROPOSED FRONT ELEVATION A
## (scale 1:100@A3)

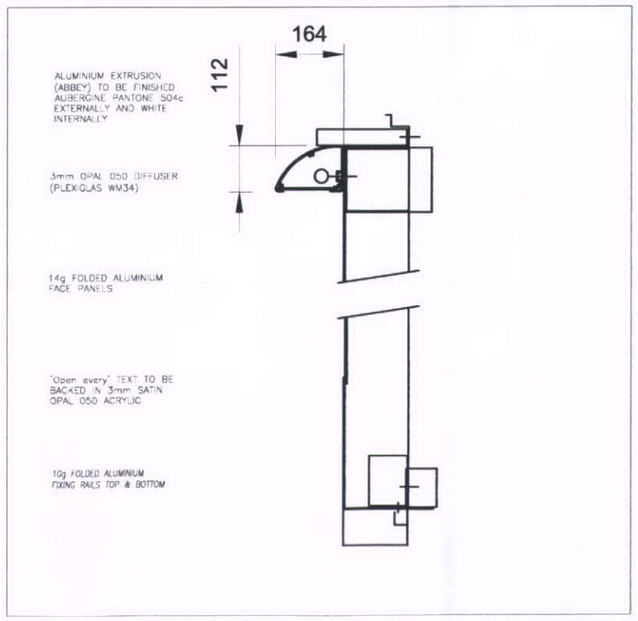


FASCIA SECTION WITH EXTERNAL ILLUMINATION

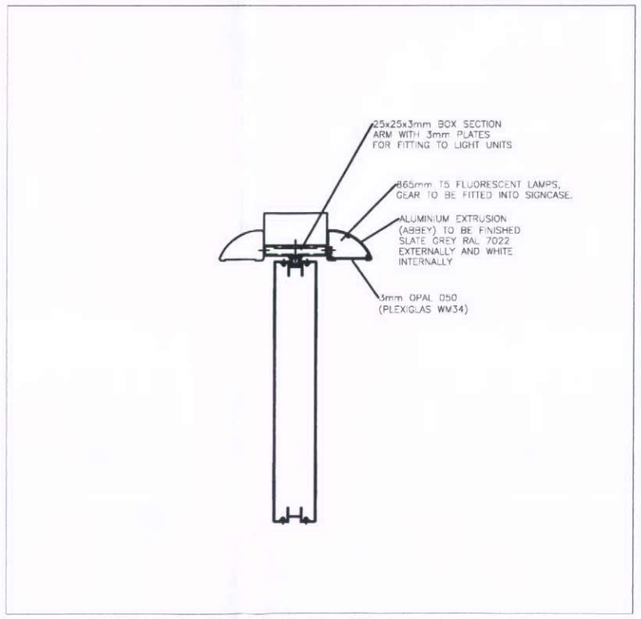


PROJECTING SIGN SECTION WITH EXTERNAL ILLUMINATION




PROJECTING SIGN DETAIL

| | | |
|---|---|---|
| C | 05/10/2011 | Revised to reflect as built. |
| B | 15/09/2011 | Glazing panel and projecting sign removed door entrance amended. |
| A | 18/07/2011 | Door entrance flipped. |

| Revision | Date | Description |
|---|---|---|


Walbrook | management
New Broad Street House
35 New Broad Street
London
EC2M 1NH
tel: 020 3009 3061
email: info@walbrookmanagement.com


Status: PLANNING

Client:

Project Title: TORR TOP STREET
DERBYSHIRE
NEW MILLS SK22 4BS

Drawing Title: PROPOSED SIGNAGE
ELEVATION A
SITE REF. 8946

| Project Number | Drawing Number | Revision |
|---|---|---|
| 11/W8946 | 208 | C |

| Drawn | Checked | Scale | Date |
|---|---|---|---|
| A.M | | 1:100@A3 | 02/06/2011 |

The content of this drawing is the property of Walbrook Management LLP and may not be copied in whole or part without formal consent.