


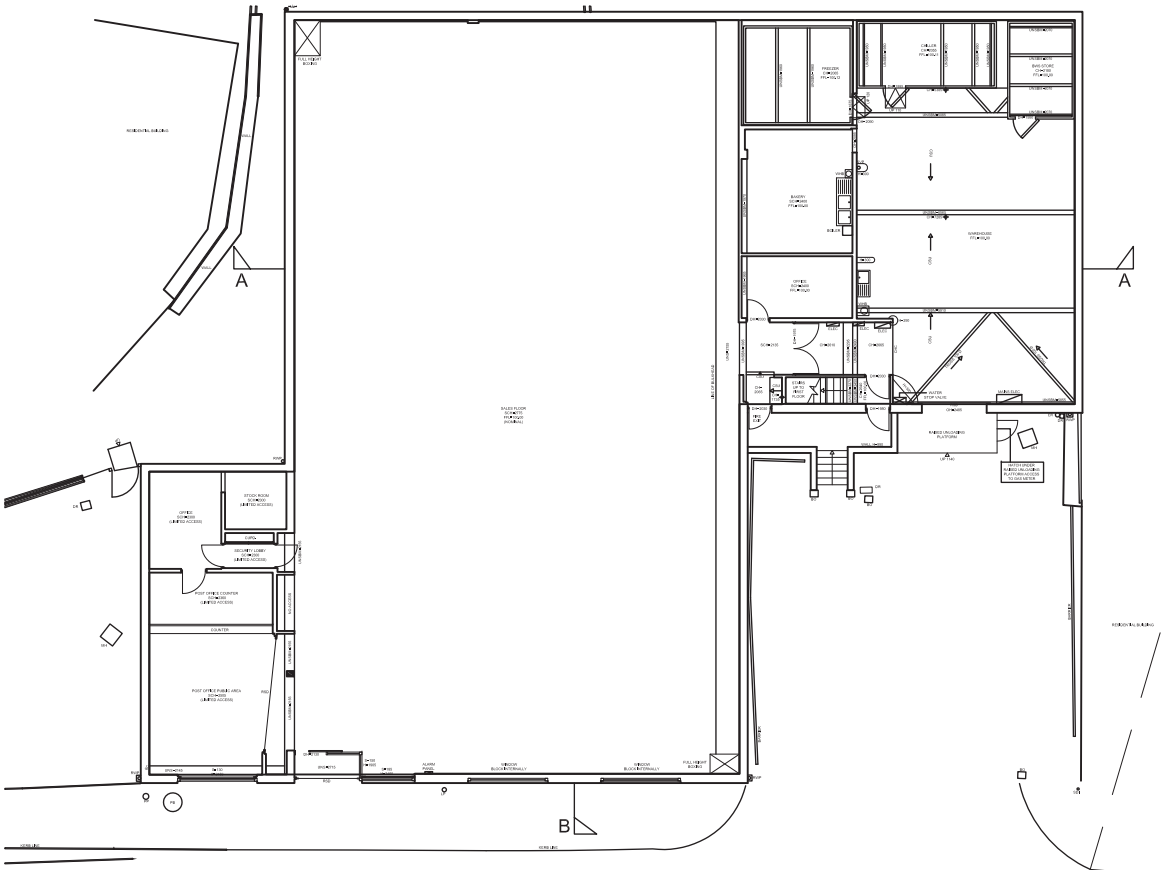


TORR TOP STREET

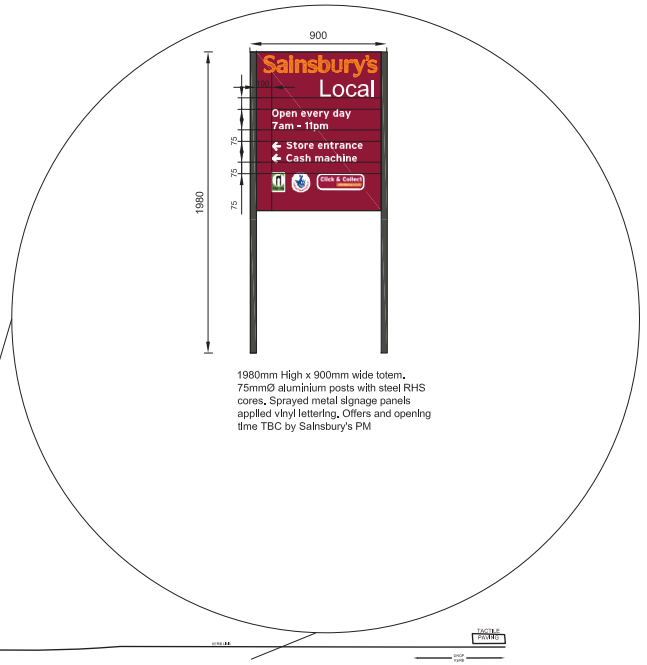

1980mm High x 900mm wide totem. 75mmØ aluminium posts with steel RHS cores. Sprayed metal signage panels applied vinyl lettering. Offers and opening time TBC by Sainsbury's PM

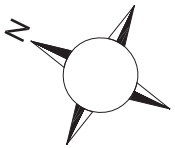

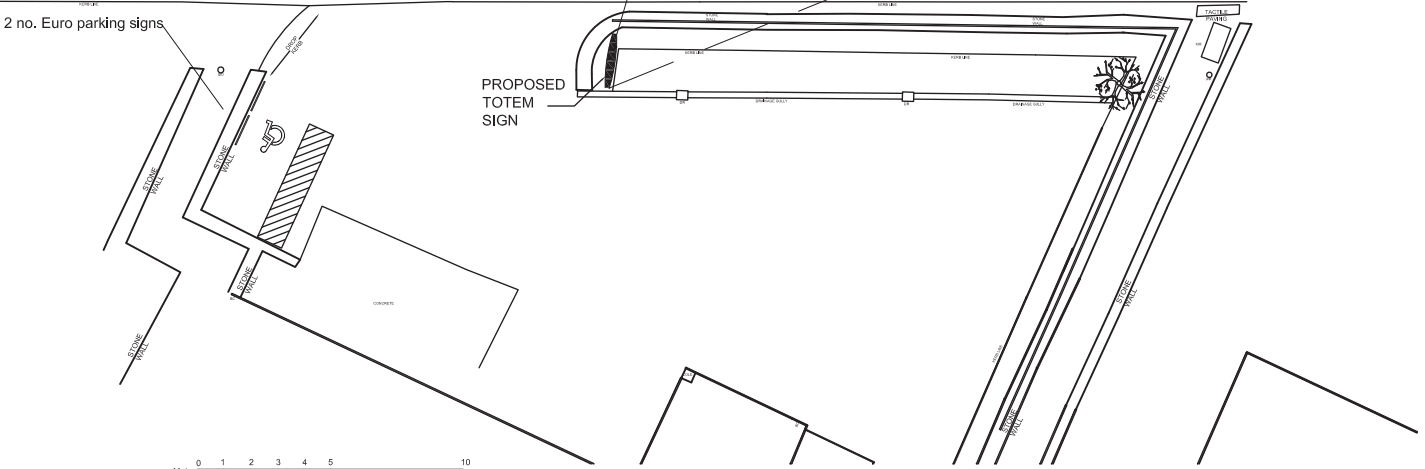

EXISTING GROUND FLOOR
(scale 1:200@A3)

Revision	Date	Description
D	02.12.11	Totem sign reduced in height as built.
C	10.11.11	Euro parking signs indicated.
B	11.10.11	Euro parking signs removed.
A	05.10.11	Revised to reflect as built.

Walbrook | management
New Broad Street House
35 New Broad Street
London
EC2M 1NH
tel: 020 3009 3061
email: info@walbrookmanagement.com

Status: PLANNING

Client:

Project Title:
TORR TOP STREET
DERBYSHIRE
NEW MILLS SK22 4BS

Drawing Title:
PROPOSED
TOTEM SIGN LOCATION PLAN
SITE REF. 8946

Project Number	Drawing Number	Revision
11/W8946	210	D

Drawn	Checked	Scale	Date
A.M		1:200@A3	02/06/2011

The content of this drawing is the property of Walbrook Management LLP and may not be copied in whole or part without formal consent.