HPK/2012/0037

ALL DIMENSIONS TO BE CHECKED ON SITE

DO NOT SCALE

IF IN DOUBT - ASK

21 JAN 2012

NO WORK TO COMMENCE ON SITE PRIOR TO PLANNING CONSENT BEING OBTAINED AND BUILDING REGULATIONS APPROVED.

© COPYRIGHT
NOT TO BE REPRODUCED WITHOUT THE WRITTEN AUTHORITY OF LDP.



FRONT ELEVATION - SOUTH

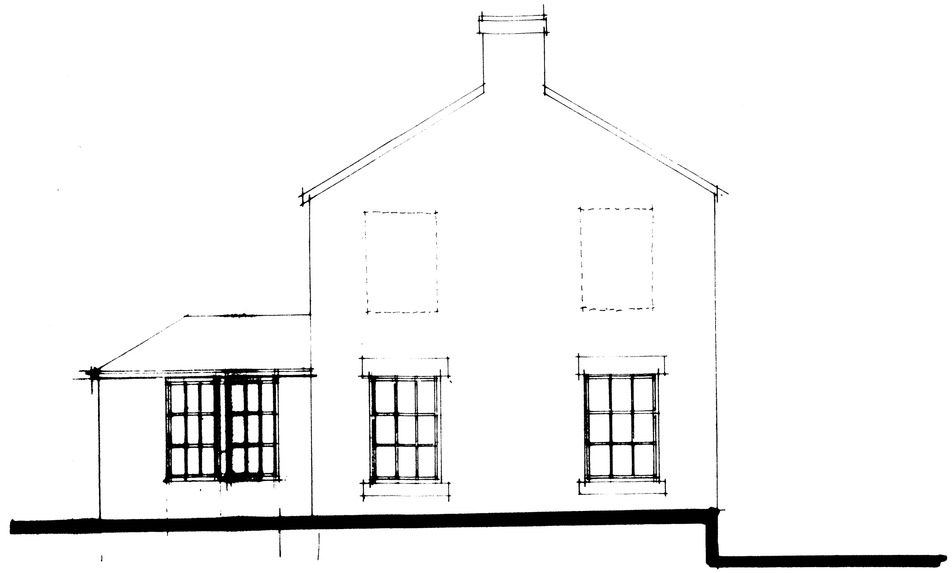

SIDE ELEVATION - WEST

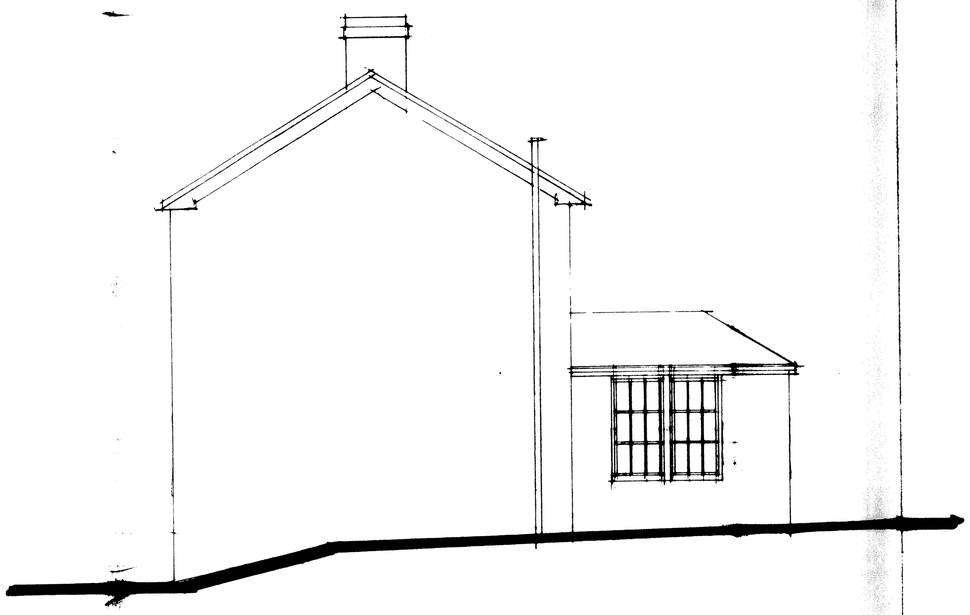

SIDE ELEVATION - EAST



REAR ELEVATION - NORTH

HIGH PEAK

3 SETT CLOSE, NEW MILLS

RETENTION OF HPK/2011/0026 & SINGLE STOREY EXTENSION

MR N WALKER

ELEVATIONS

AS BUILT

LOCKSIDE DESIGN PARTNERSHIP
ARCHITECTURAL + HISTORIC BUILDING CONSULTANTS
Lockside Mill, St. Martins Road, Marple, Stockport SK6 7BZ
Telephone: 0161-427-7721 Fax: 0161-427-7721

11/1934/03 1:50 Dec '11