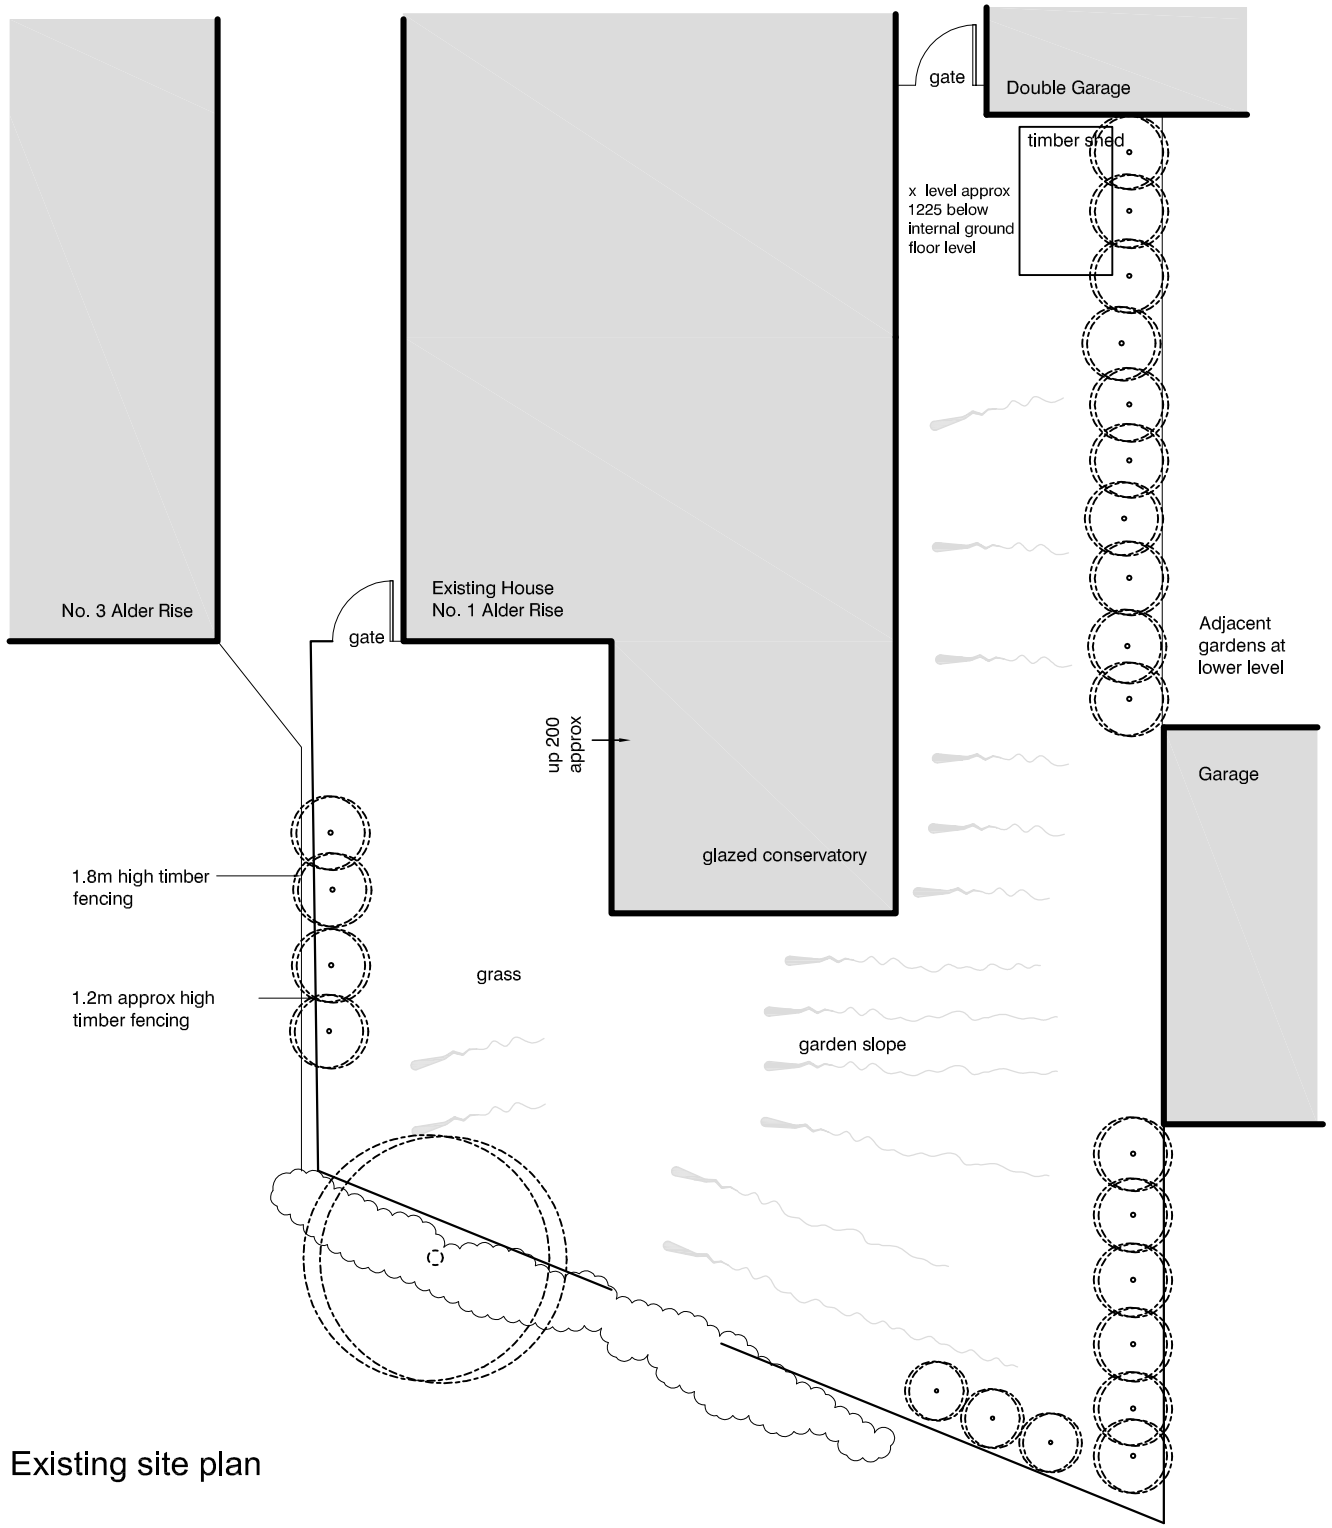

Existing site plan

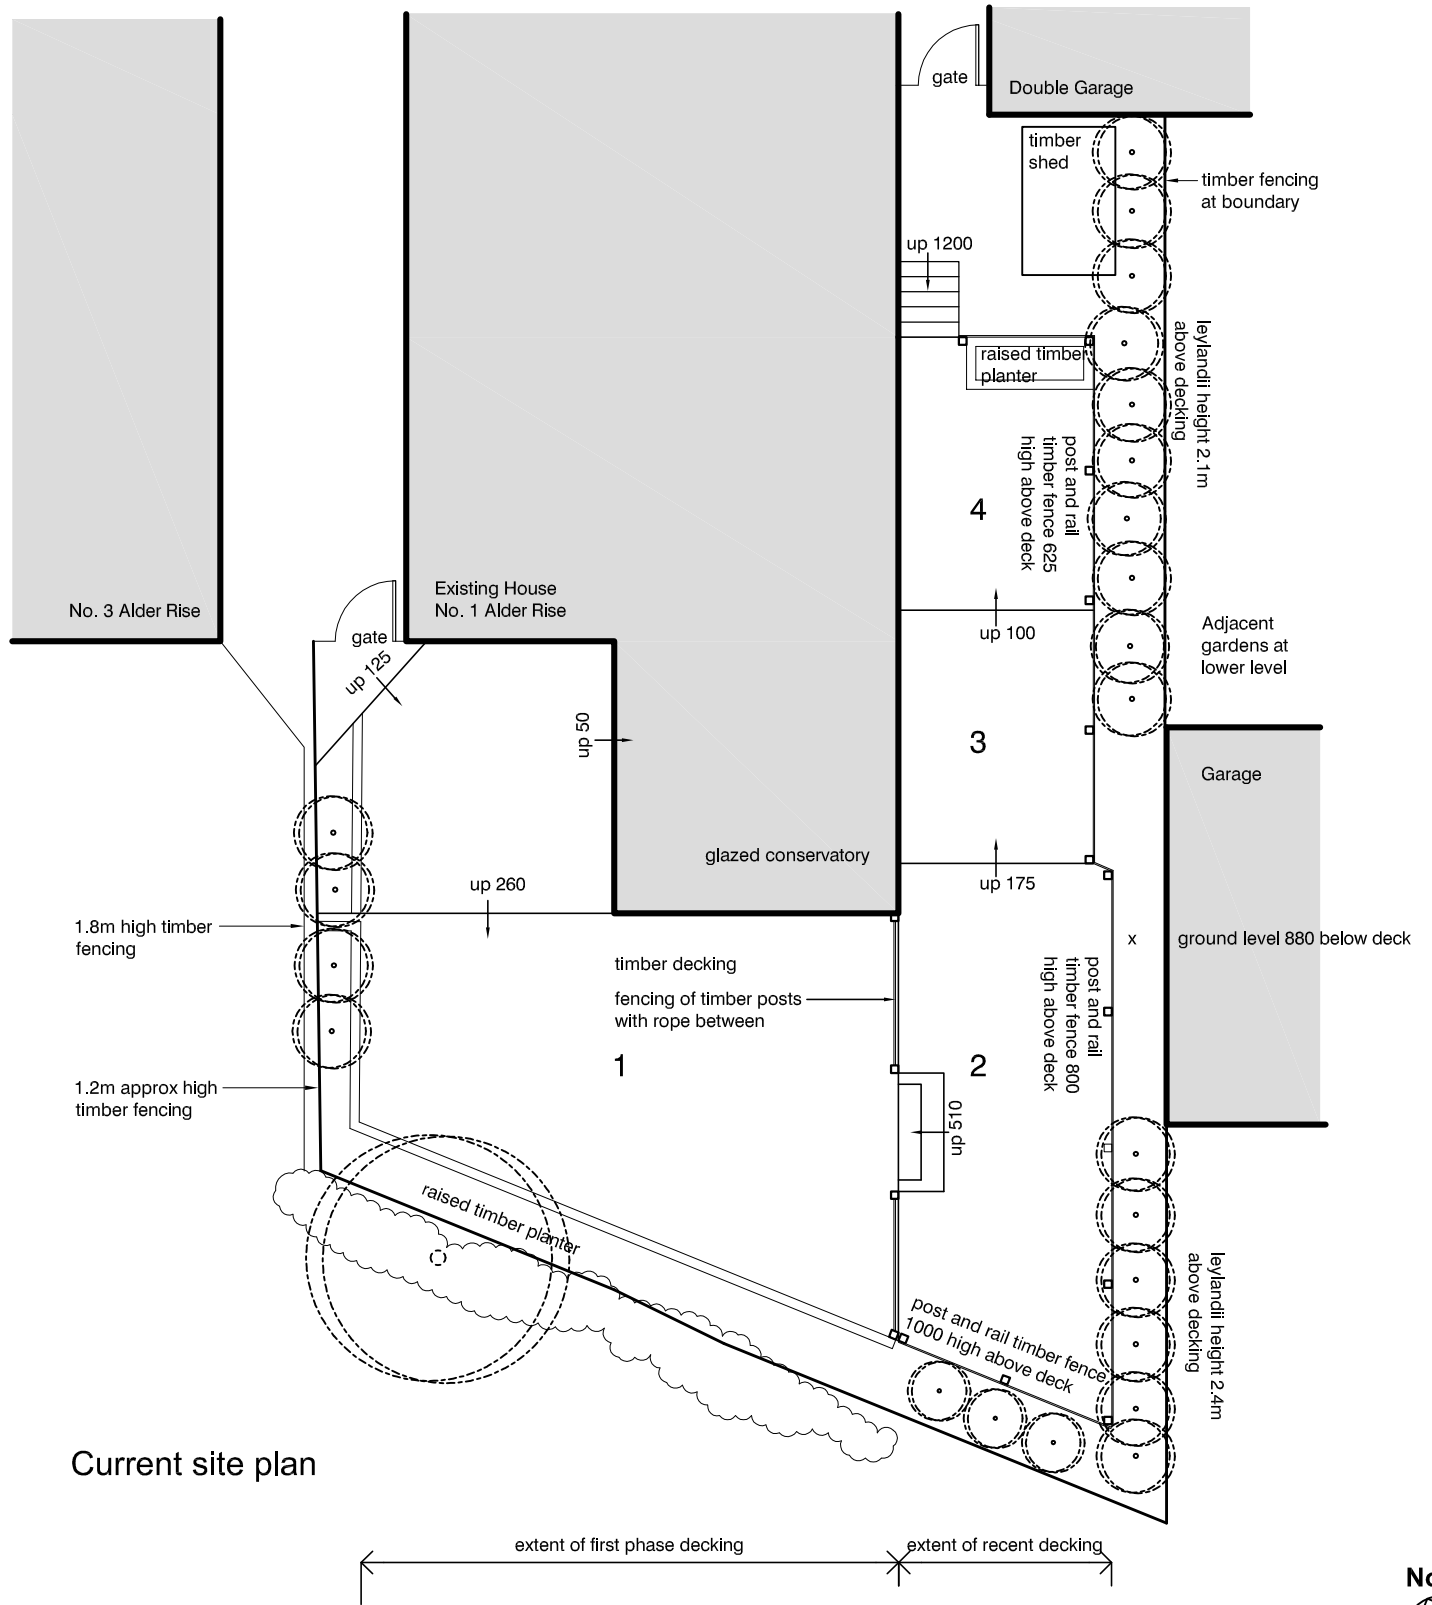

Current site plan

The decking work was carried out in two stages:
First in spring 2010 where the decking was laid from the edge of the conservatory towards no.3 Alder Rise. Due to the slope on the garden, a lot of earth was moved to level the site as best as possible and a raised planter was required at the edge due to the higher ground level of adjacent gardens. (Area 1)
The second phase was completed summer 2011. (Areas 2,3 and 4) Due to the slope on the garden, the land to the side of the house was not much used, this becomes usable space when decked. The gradient on the garden means the decking is raised above existing ground level from 200mm up to a maximum of 1200mm at the steps.
Survey of existing levels could not be taken as access was too difficult due to location of decking and surrounding trees. Any levels that could be taken are indicated.

Rev A: 01.02.12 Labelling updated for revised planning submission

North

HIGH PEAK **ARCHITECTS** LTD
2nd Floor, Wharf House, Wharf Road, Whaley Bridge, High Peak, Derbys SK23 7AD
Tel: 01663 719717 Web: www.highpeakarch.com Email: hpa@highpeakarch.com

External Decking

1 Alder Rise, Whaley Bridge

Existing & Current Site Plan

1116.02

Scale: 1:100 @ A3 Date: October 2011 DO NOT SCALE OFF THIS DRAWING Rev: