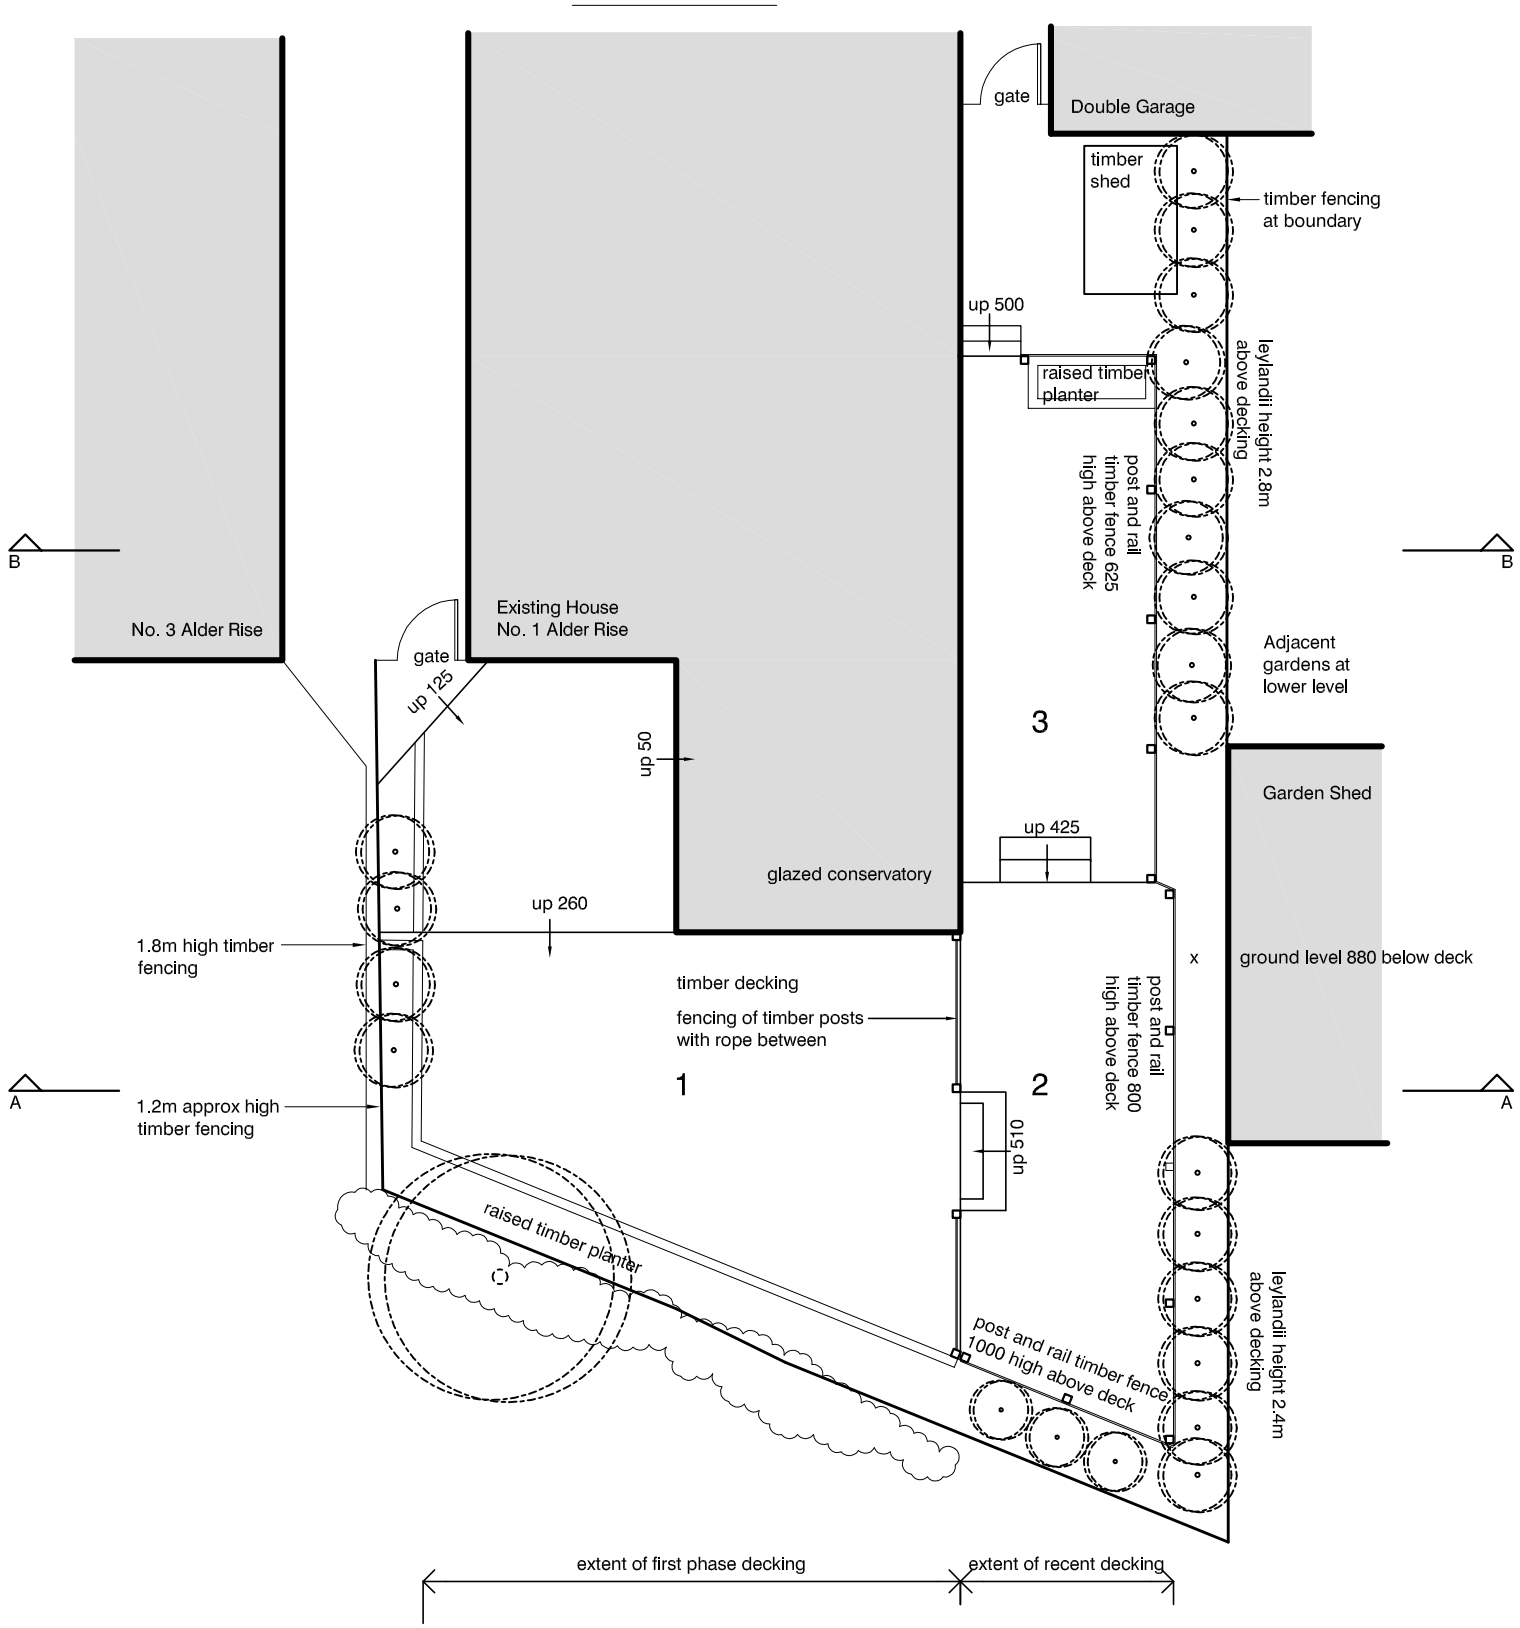

Proposed site plan

Revised proposal:
Sections of decking 3 and 4 reduced in height by 600mm below what is currently the level of section 3. This is the lowest it can be taken without removing earth from underneath.
Section 1 and 2 remain the same as the current condition as neither can be dropped any further.
The safety fencing is shown as current - however the client would be amenable to a close boarded fence to a height of 1.8m if required.

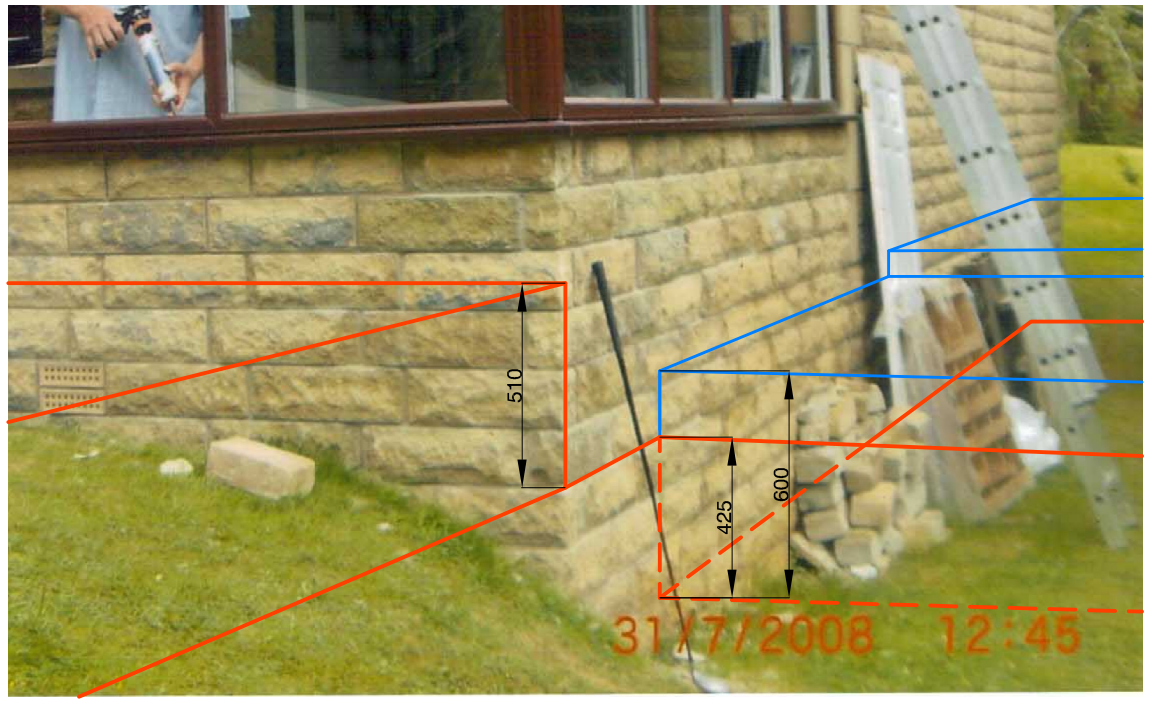

Indicitive drawing to give a guide where the decking is located adjacent to existing house

The red lines show the revised proposed decking location
The blue lines show the previous levels of decking areas 3 and 4

North

HIGH PEAK ARCHITECTS LTD
2nd Floor, Wharf House, Wharf Road, Whaley Bridge, High Peak, Derbys SK23 7AD
Tel: 01663 719717 Web: www.highpeakarch.com Email: hpa@highpeakarch.com

External Decking

1 Alder Rise, Whaley Bridge

Proposed Site Plan and sketch

1116.05

Scale: 1:100 @ A3 Date: October 2011 DO NOT SCALE OFF THIS DRAWING Rev: