LLOYDS TSB.

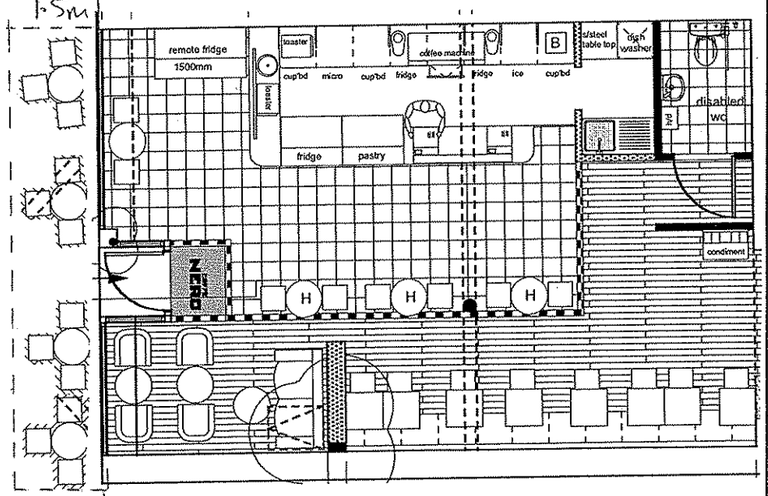

PEDESTRIANISED AREA.

HARGREAVES.

Rev N°	Description	Drawn by	Date
A	layout changes	HS	29.01.2007

Notes

This drawing represents a performance guide upon which the contractor/subcontractor must base his/her working drawings & details. Include all necessary tolerances prior to manufacture and installation

Contractor to must undertake a full survey of the area to establish all dimensions & ensure accurate setting out.

Advise on suitability of all details shown to ensure structural stability, ease and economy of construction

Refer to digital master artwork in regard to all graphic work shown

A3 PAPER SIZE

AS BUILT

bedrock
Bedrock Design Consultants Ltd
4th Floor, 57 Hatton Garden, London, EC1 8HP
T 020 3116 0120
F 020 3116 0121
john@bedrockdesign.co.uk

Client: Caffe Nero

Project: Buxton

Description: Proposed Ground Floor Plan

Merchandise GA

Scale	Drawn by	Date
1/100	HS	29/01/07

Drawing N°	Revision
CN292-001	A

This drawing is the copyright of Bedrock Design Consultants Ltd. This drawing cannot be copied, reproduced, retained or disclosed to any unauthorised person without prior permission in writing from the designer.