

Elevations


Walls: Random/coursed natural stone
Roof cover: Blue slate
Windows/doors: Timber framed

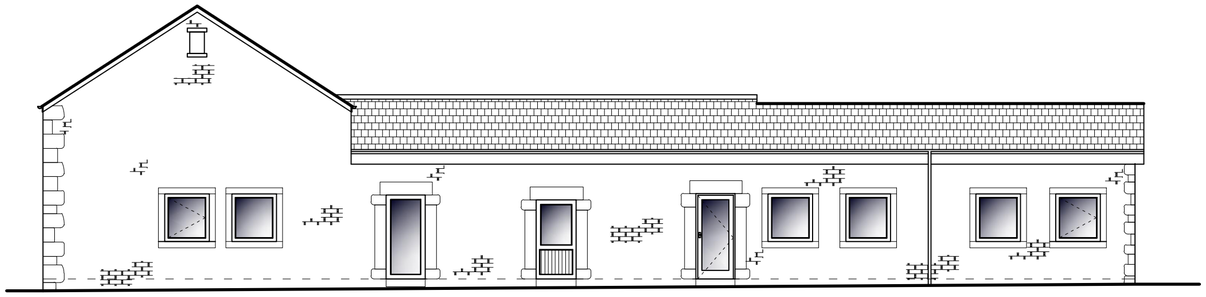


North

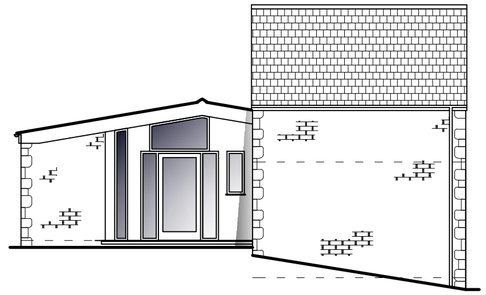

East

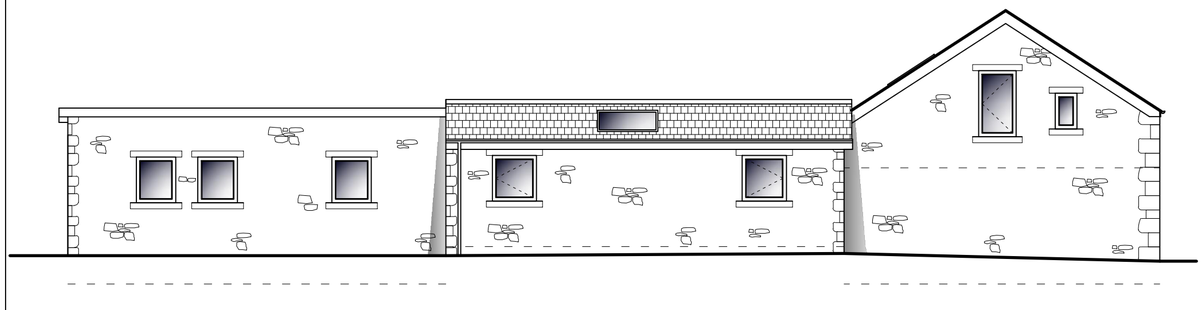


South

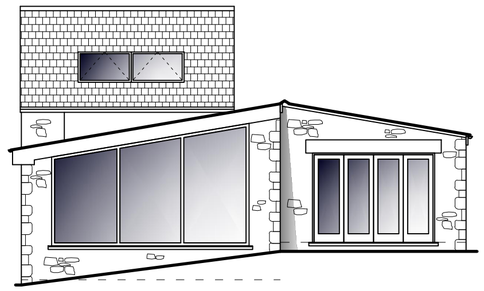


West

Floorplans

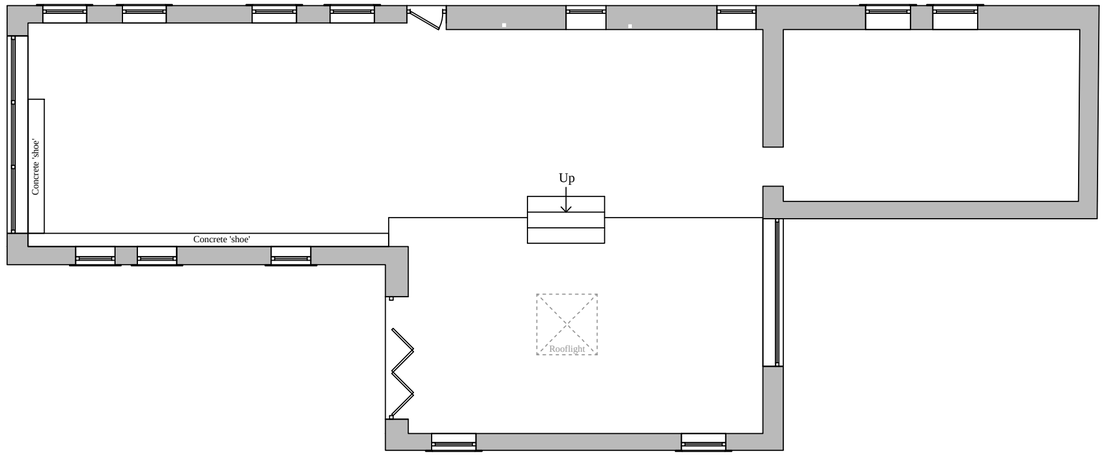

Ground

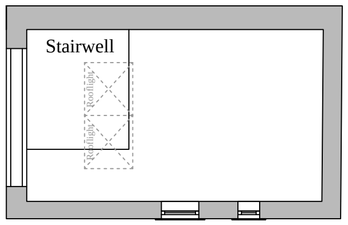

First

This drawing is the Copyright of SJ Design Limited.
All dimensions must be checked on site and not scaled from this drawing.
All materials and workmanship are to be in accordance with prevailing British Standards, Codes of Practice, Building Regulations, manufacturers and federation recommendations and all to the complete satisfaction of SJ Design Limited.

SJ DESIGN LTD
Building Design & Surveying Consultants
The Old Co-Op Building, Church Street,
Hayfield, High Peak SK22 2JE
Tel:01663 742903 Fax:01663 751247
Mobile: 07984 007 087 Email: info@sjdesign.net
www.sjdesign.net

Client
Paul & Sheridan Coverley

Job Title
Meadows Farm
16 Ridge Top Lane
Hayfield
High Peak
SK22 2JQ

Drawing Title
Barn plans as built

Scale
1:100; @A2 unless stated

Date
June 2012

Drawn by
SJ

Drawing No.
200

Rev.