
3, LAKE VIEW , FURNESS VALE

RETAINING WALL, SHED WITH SITTING AREA AND GARDEN


HPK/2012/0481

AS CONSTRUCTED

-3 AUG 2012

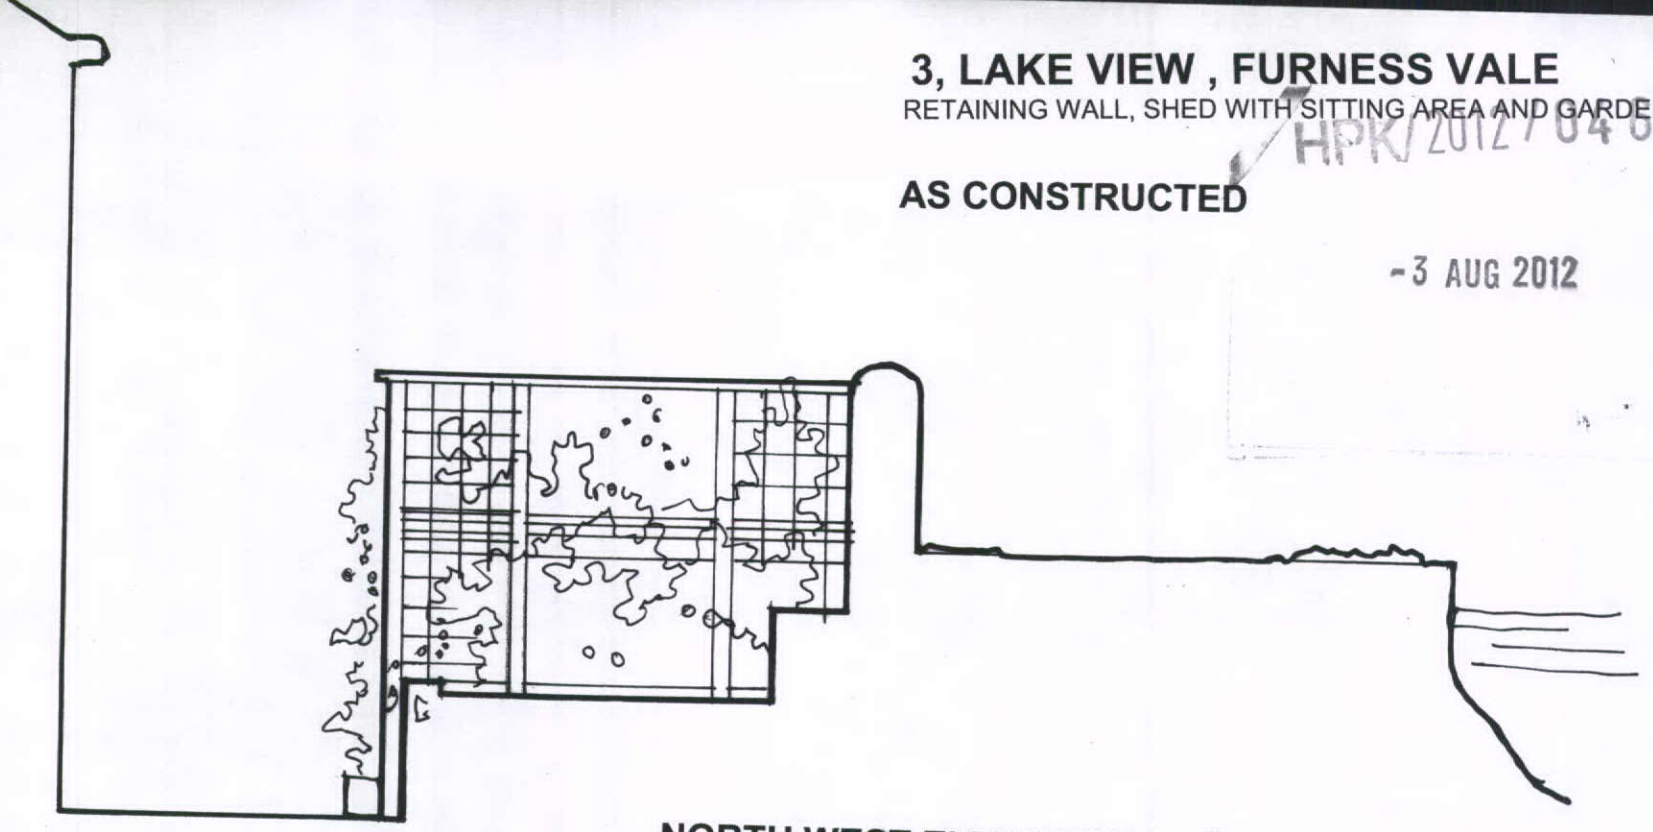

NORTH WEST ELEVATION 1.50

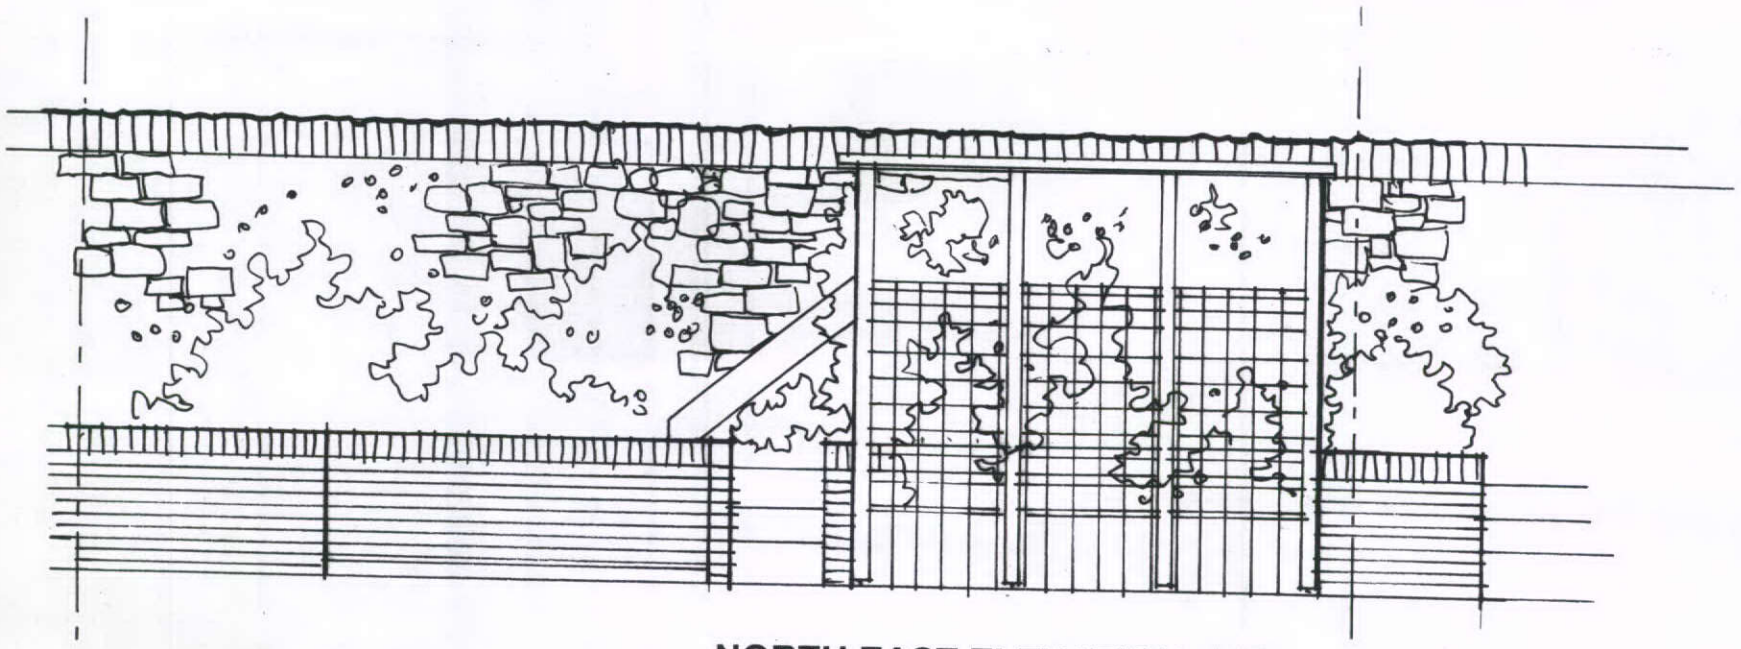

NORTH EAST ELEVATION 1.50