
PK/2012/0461
-3 AUG 2012

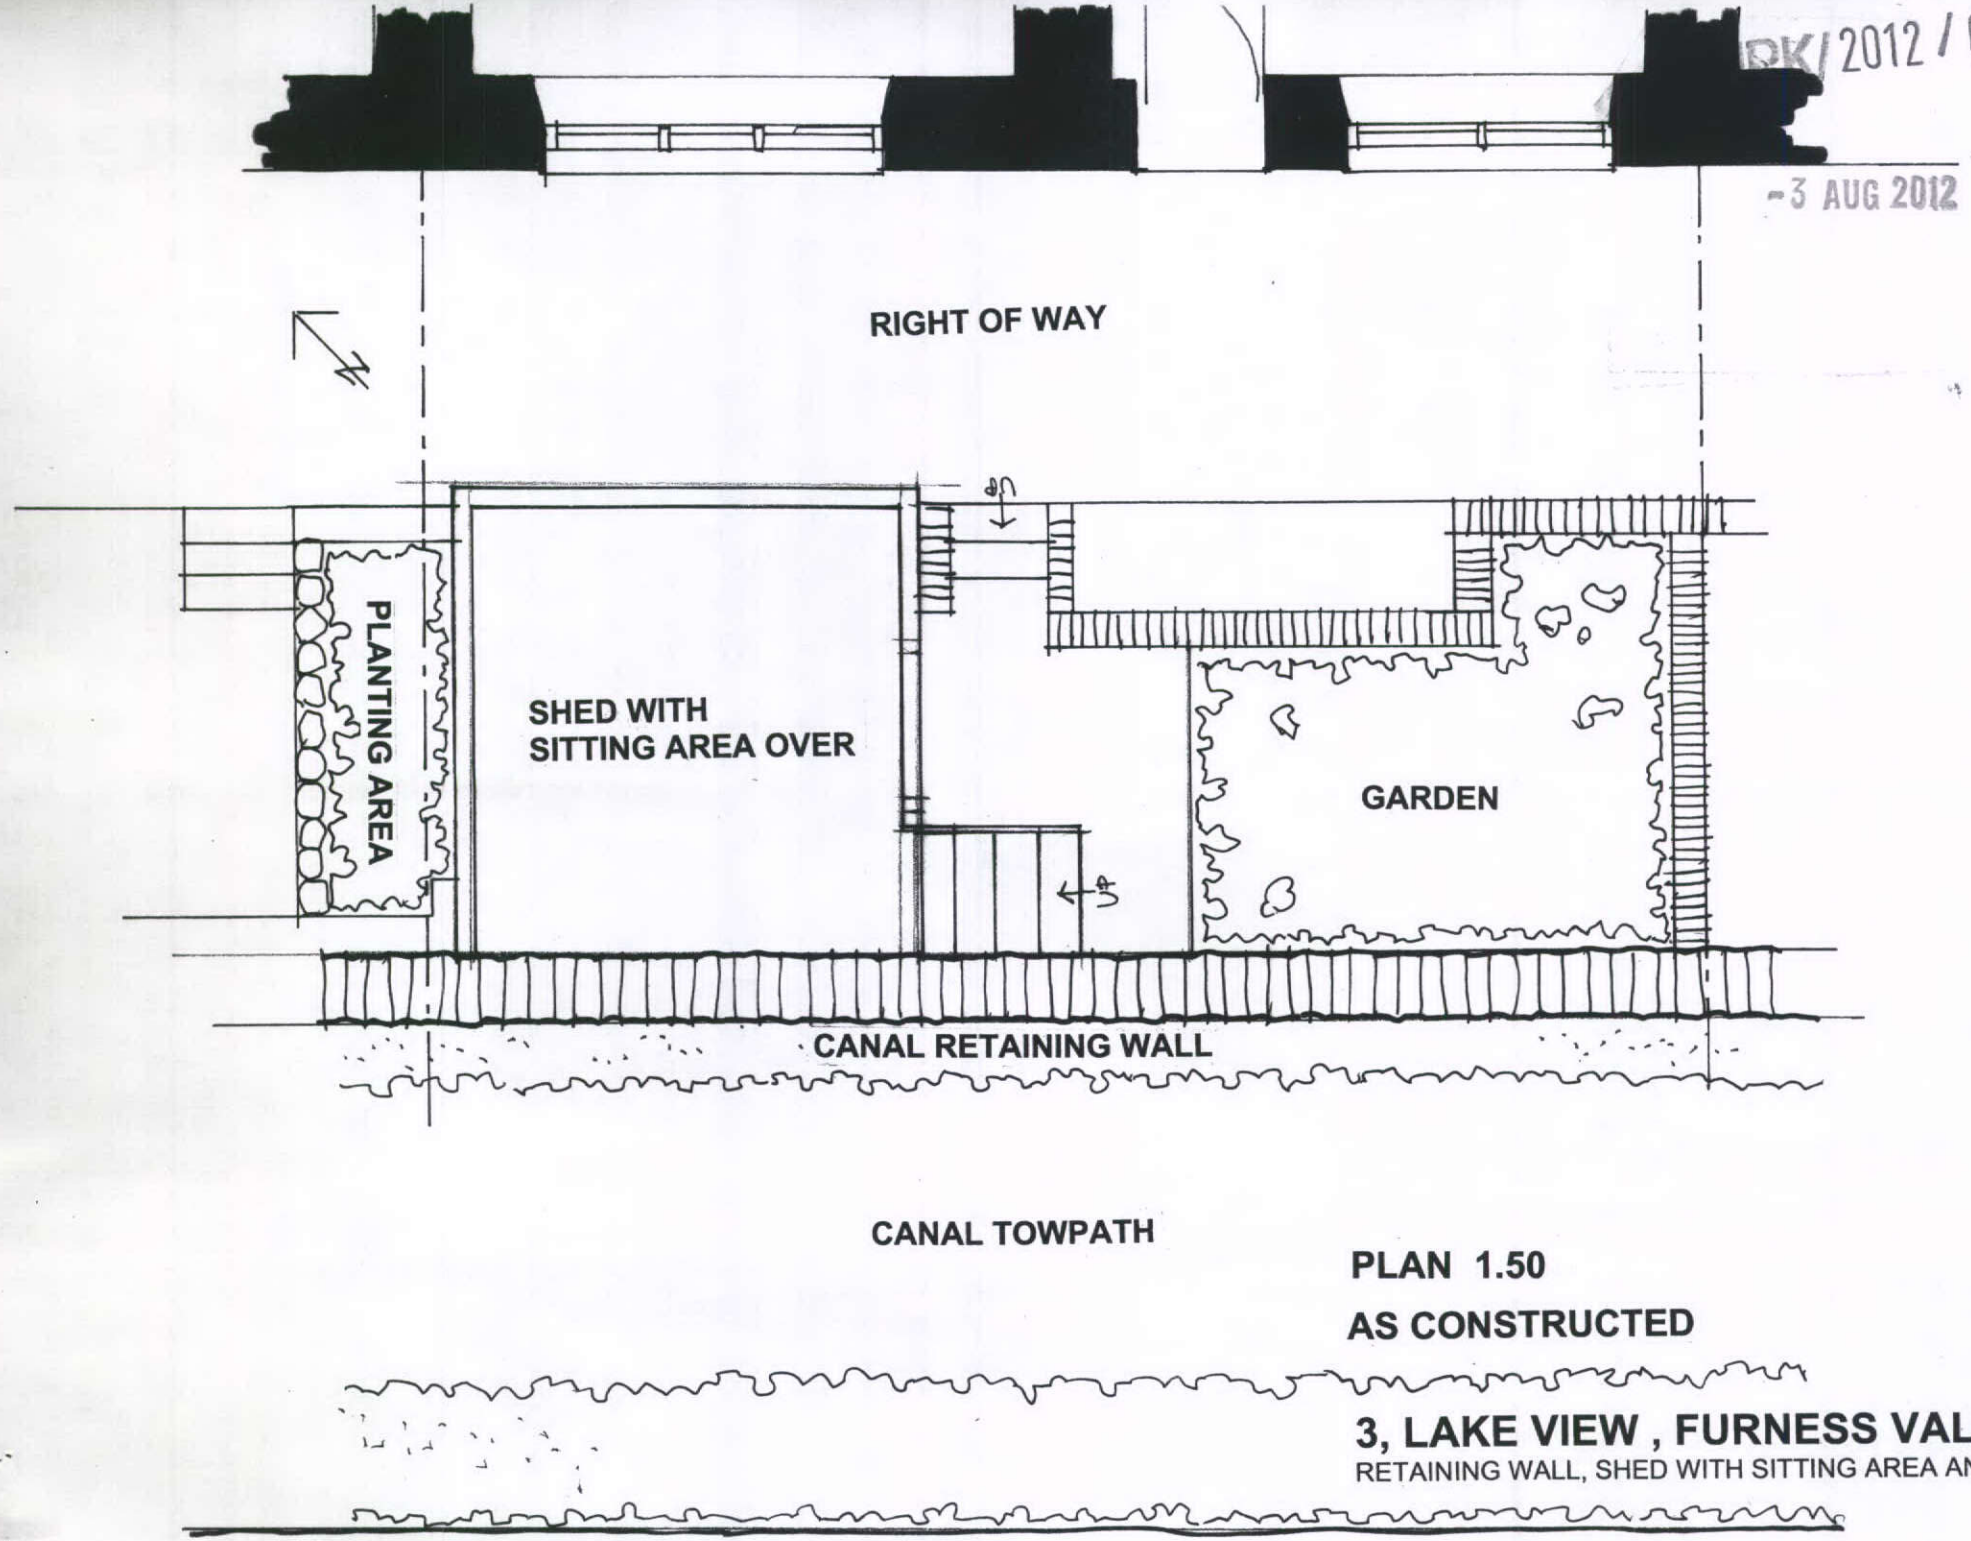

PLAN 1.50

AS CONSTRUCTED

3, LAKE VIEW , FURNESS VALE

RETAINING WALL, SHED WITH SITTING AREA AND GARDEN