
THDK/2012/0461

3, LAKE VIEW , FURNESS VALE

RETAINING WALL, SHED WITH SITTING AREA AND GARDEN

- 3 AUG 2012

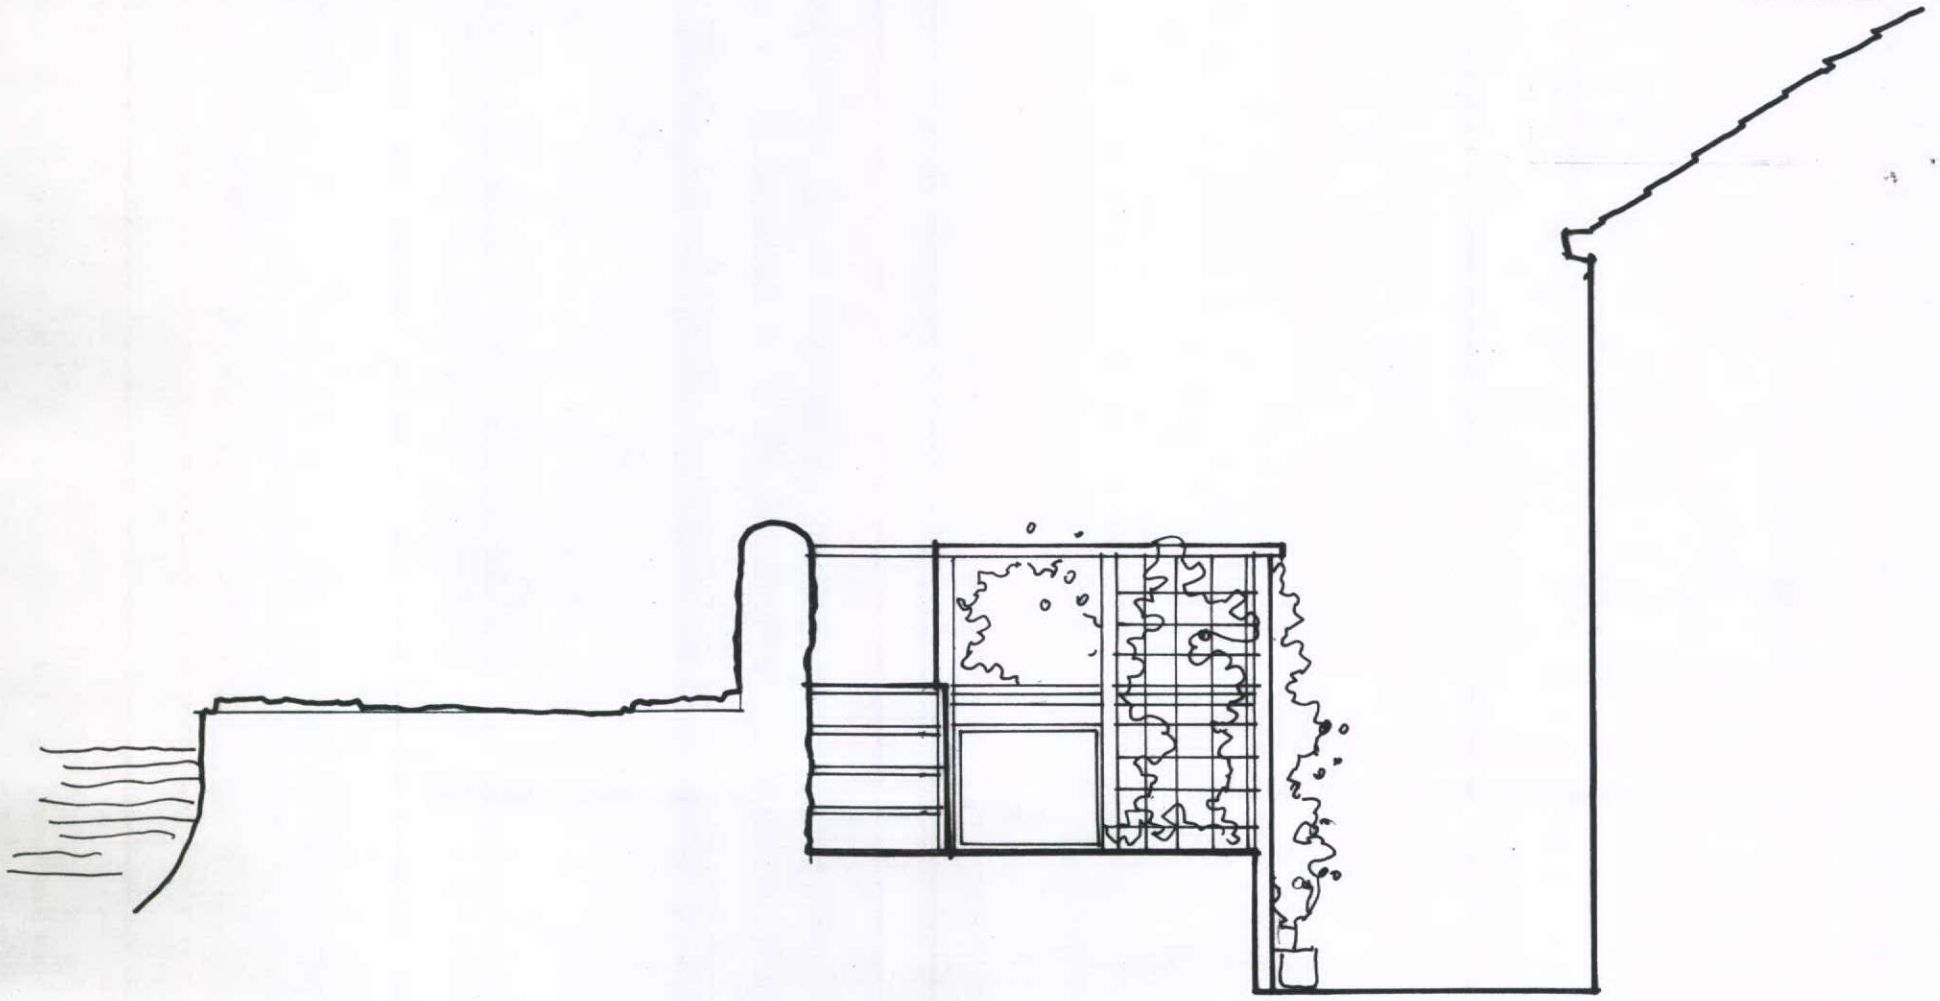

SOUTHEAST ELEVATION 1.50

AS CONSTRUCTED