

Green Outline relating to planning application for 3 Lambsgate

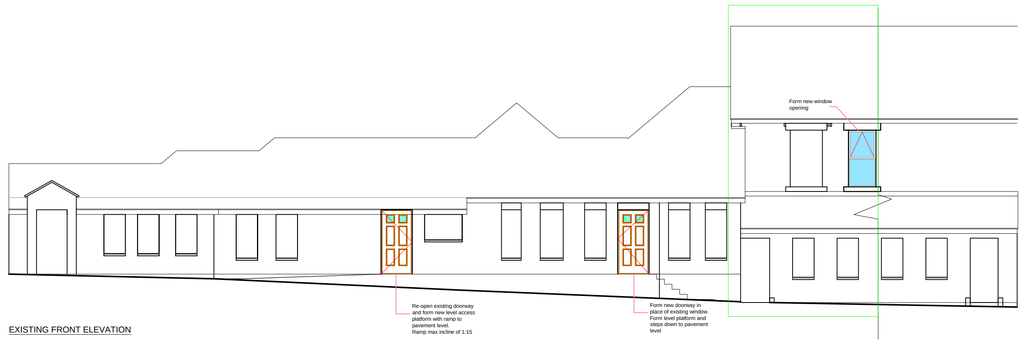

EXISTING FRONT ELEVATION

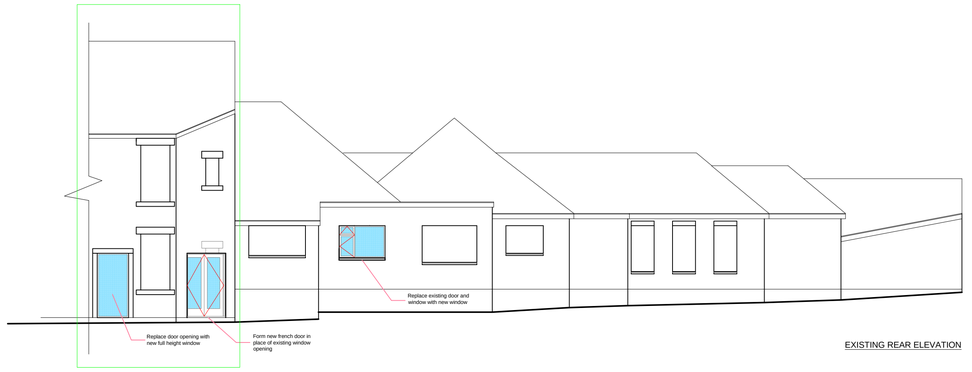

EXISTING REAR ELEVATION



PROPOSED SIDE ELEVATION

PhilipMillsonAssociates
Hyde Park House, Cartwright Street, Newton, Hyde, Cheshire, SK14 4EH
Tel: 0161 367 2320
Email: info@philipmillson.com
Web: www.philipmillson.com

CLIENT

All levels and dimensions must be checked on site by contractor prior to commencement of works. Any variations must be reported to Philip Millson Associates Ltd.
All information hereon in is the copyright of Philip Millson Associates Ltd. Copying in full or in part is forbidden without the written permission from Philip Millson Associates Ltd.

APPROVAL ■ TENDER ☐ CONSTRUCTION ☐
INFORMATION ☐ PRELIMINARY ☐ AS BUILT ☐

Rev.A - 20.11.12 - NH - Outline colour changed to green

PROJECT
Proposed Conversion of Doctors Surgery at: Lambsgate, Hadfield

DRAWING NUMBER
1634-PL-4.01

DRAWING
Proposed Elevations

REVISION
A

DRAWN
NH

CHECKED
PJM

DATE
Nov '12

SCALE
1:100@A1