


Elevations

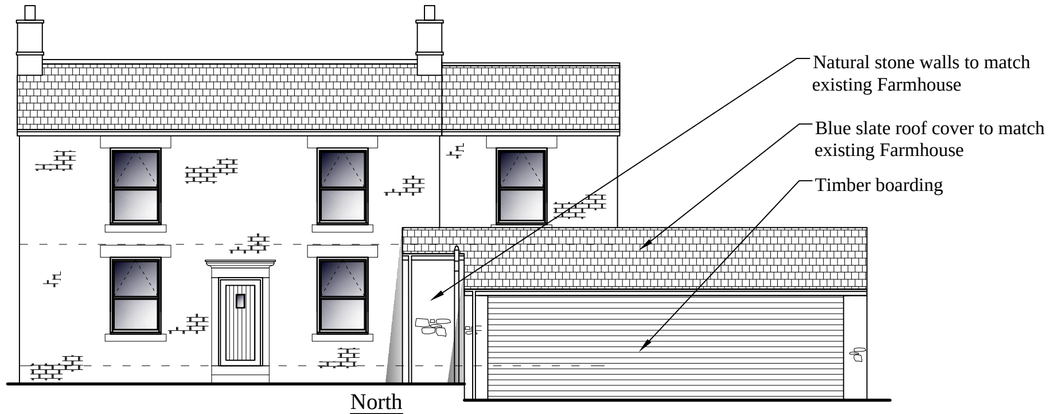


North

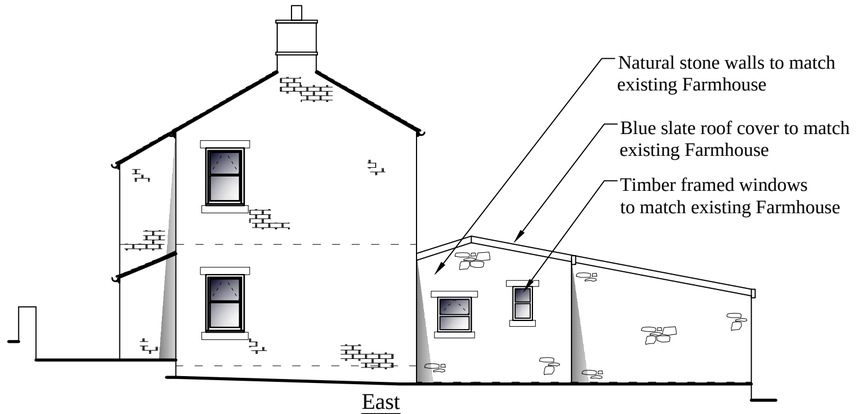

East

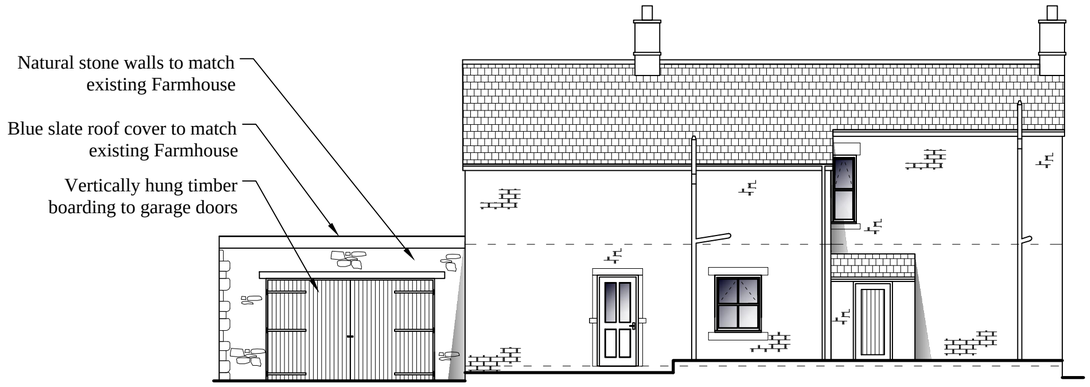


South

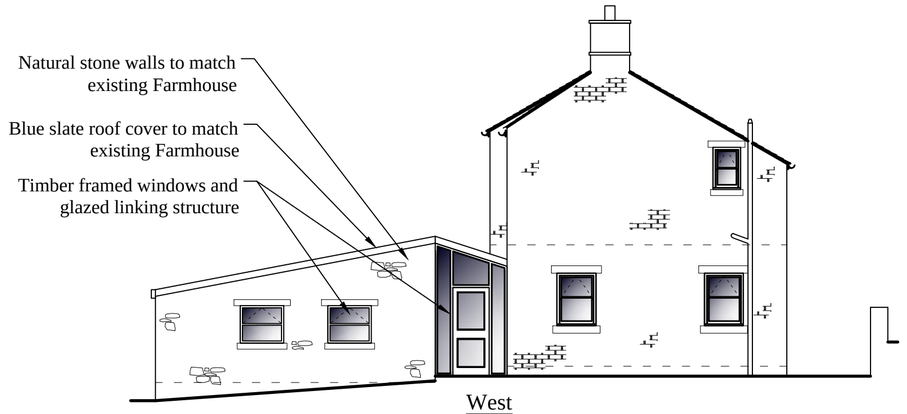

West

Floorplans

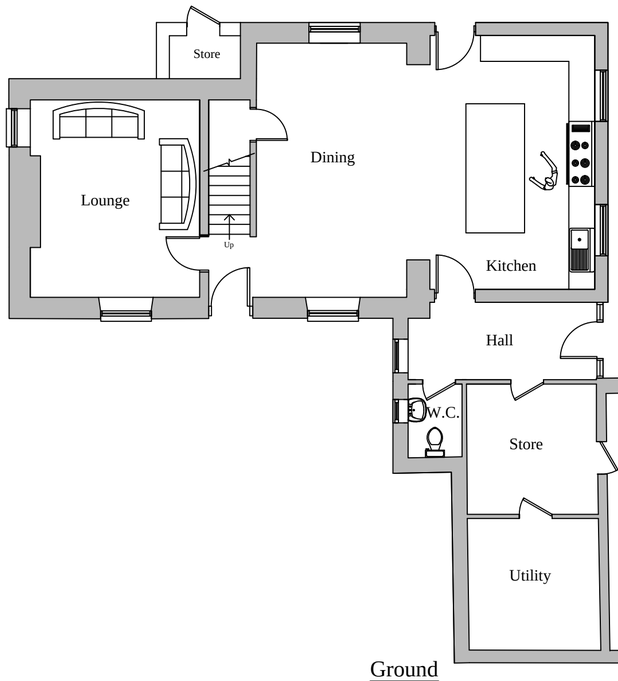

Ground

Planning

This drawing is the Copyright of SJ Design Limited.
All dimensions must be checked on site and not scaled from this drawing.
All materials and workmanship are to be in accordance with prevailing British Standards, Codes of Practice, Building Regulations, manufacturers and federation recommendations and all to the complete satisfaction of SJ Design Limited.

SJ DESIGN LTD
Building Design & Surveying Consultants
The Old Co-Op Building, Church Street,
Hayfield, High Peak SK22 2JE
Tel:01663 742903 Fax:01663 751247
Mobile: 07984 007 087 Email: info@sjdesign.net
www.sjdesign.net

Client
Paul & Sheridan Coverley

Job Title
Retention of Garage at
Meadows Farm
16 Ridge Top Lane
Hayfield
High Peak
SK22 2JQ

Drawing Title
Farmhouse, garage and linking structure as built

Scale
1:100; @A2 unless stated

Date
December 2012

Drawn by
SJ

Drawing No.
200

Rev.