HPK/2013/0043

(1)

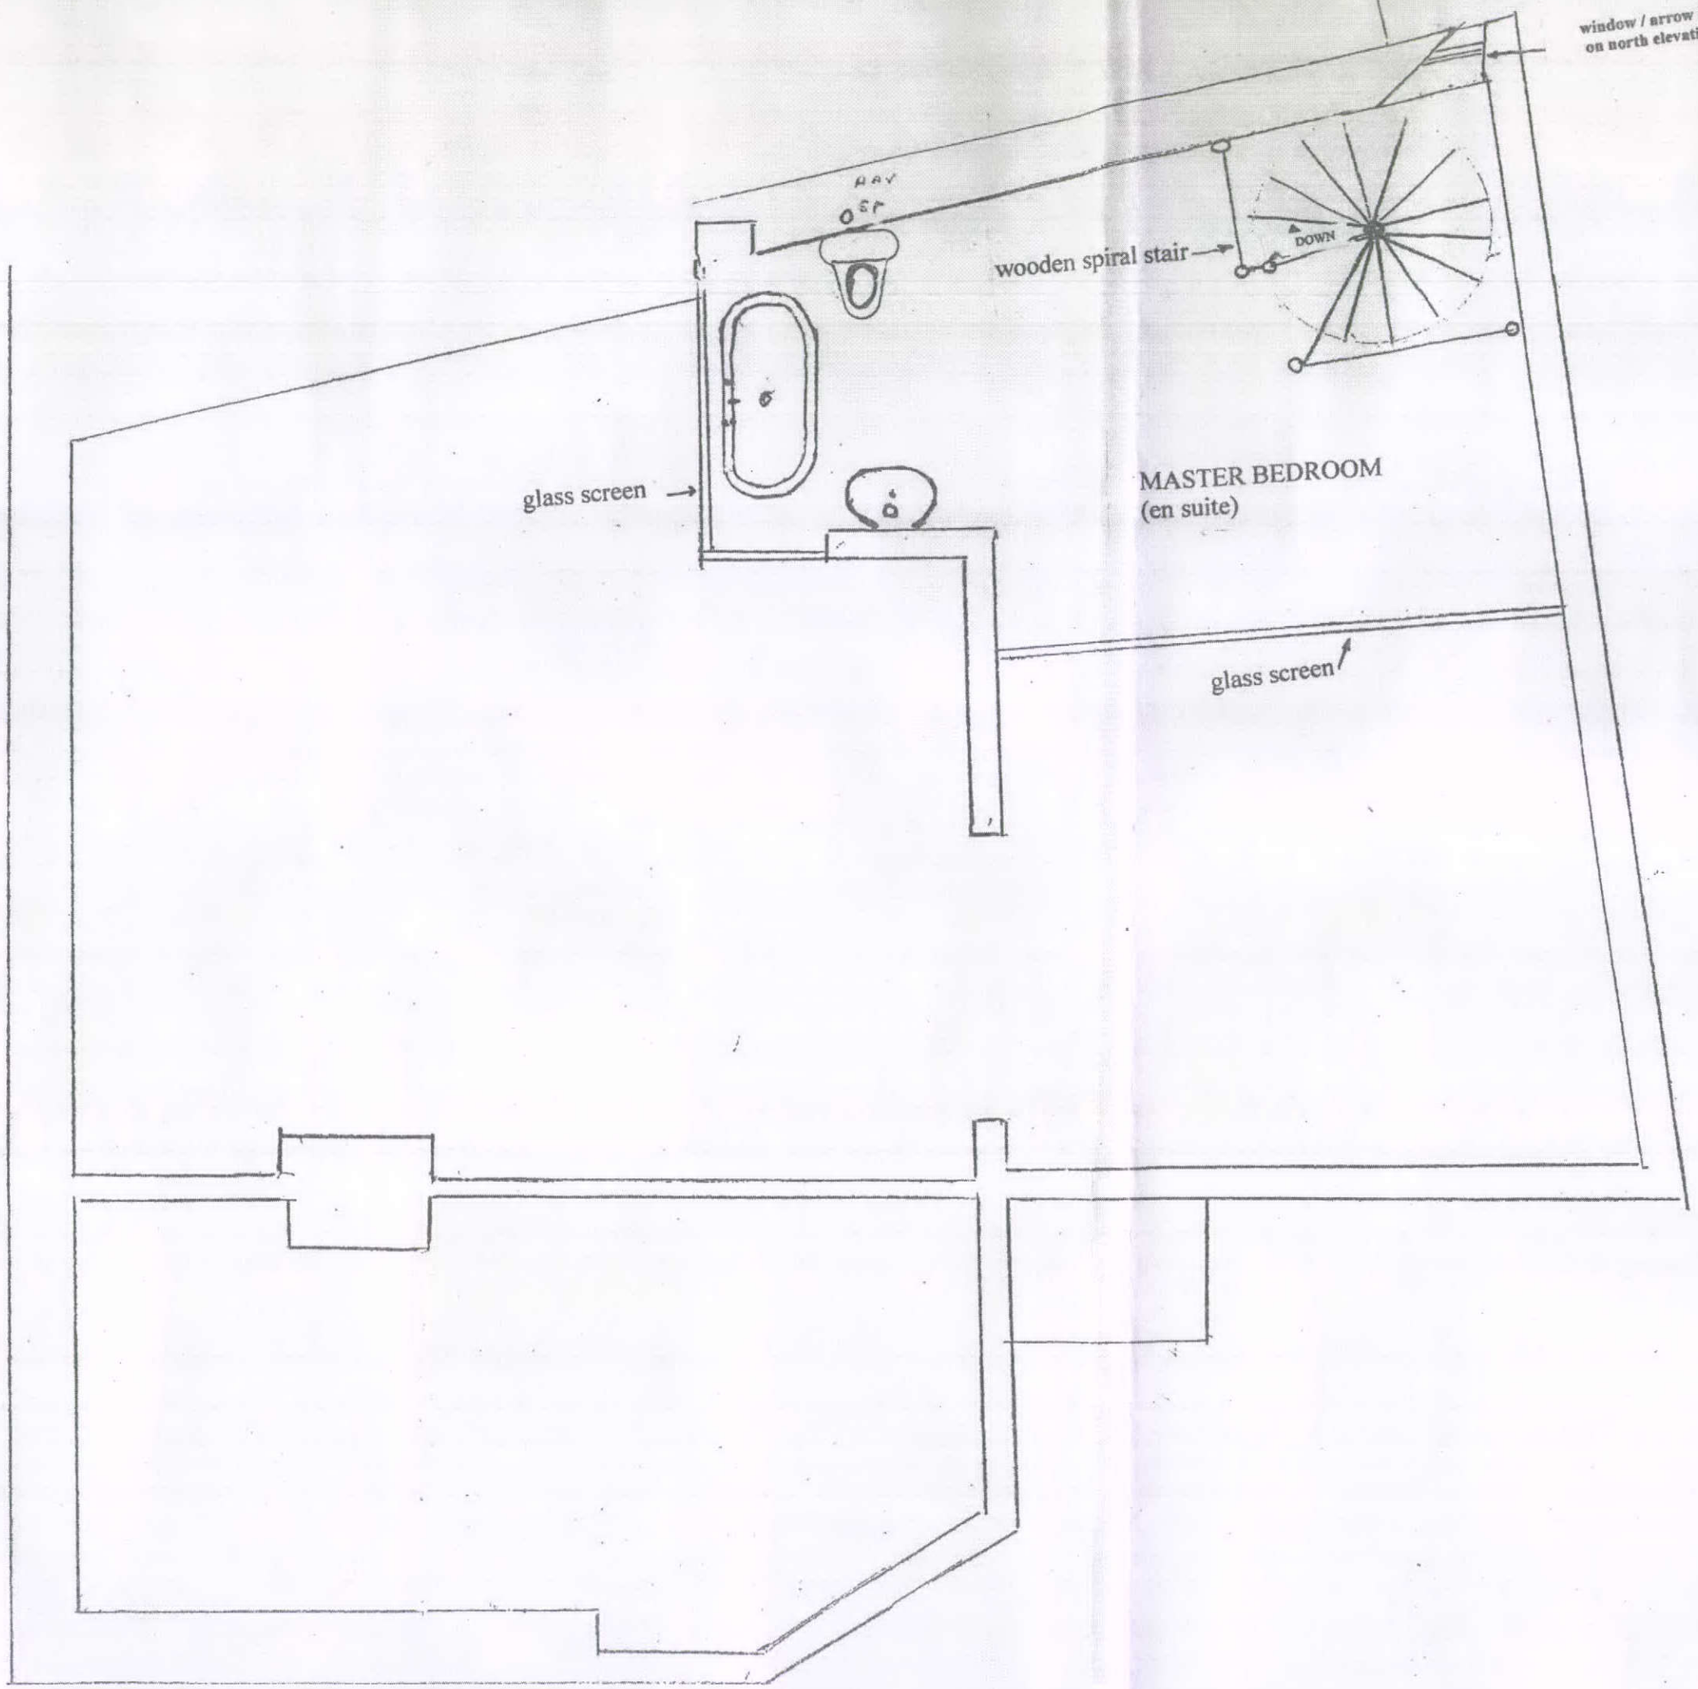

THE COTTAGE TORR ST MEWS
PROPOSED/AS CONSTRUCTED MEZZANINE
DRAWING No 11
SCALE 1-50

HIGH PEAK BOROUGH COUNCIL
POST ROOM
REC'D 24 JAN 2013