
HPK/2013/0319

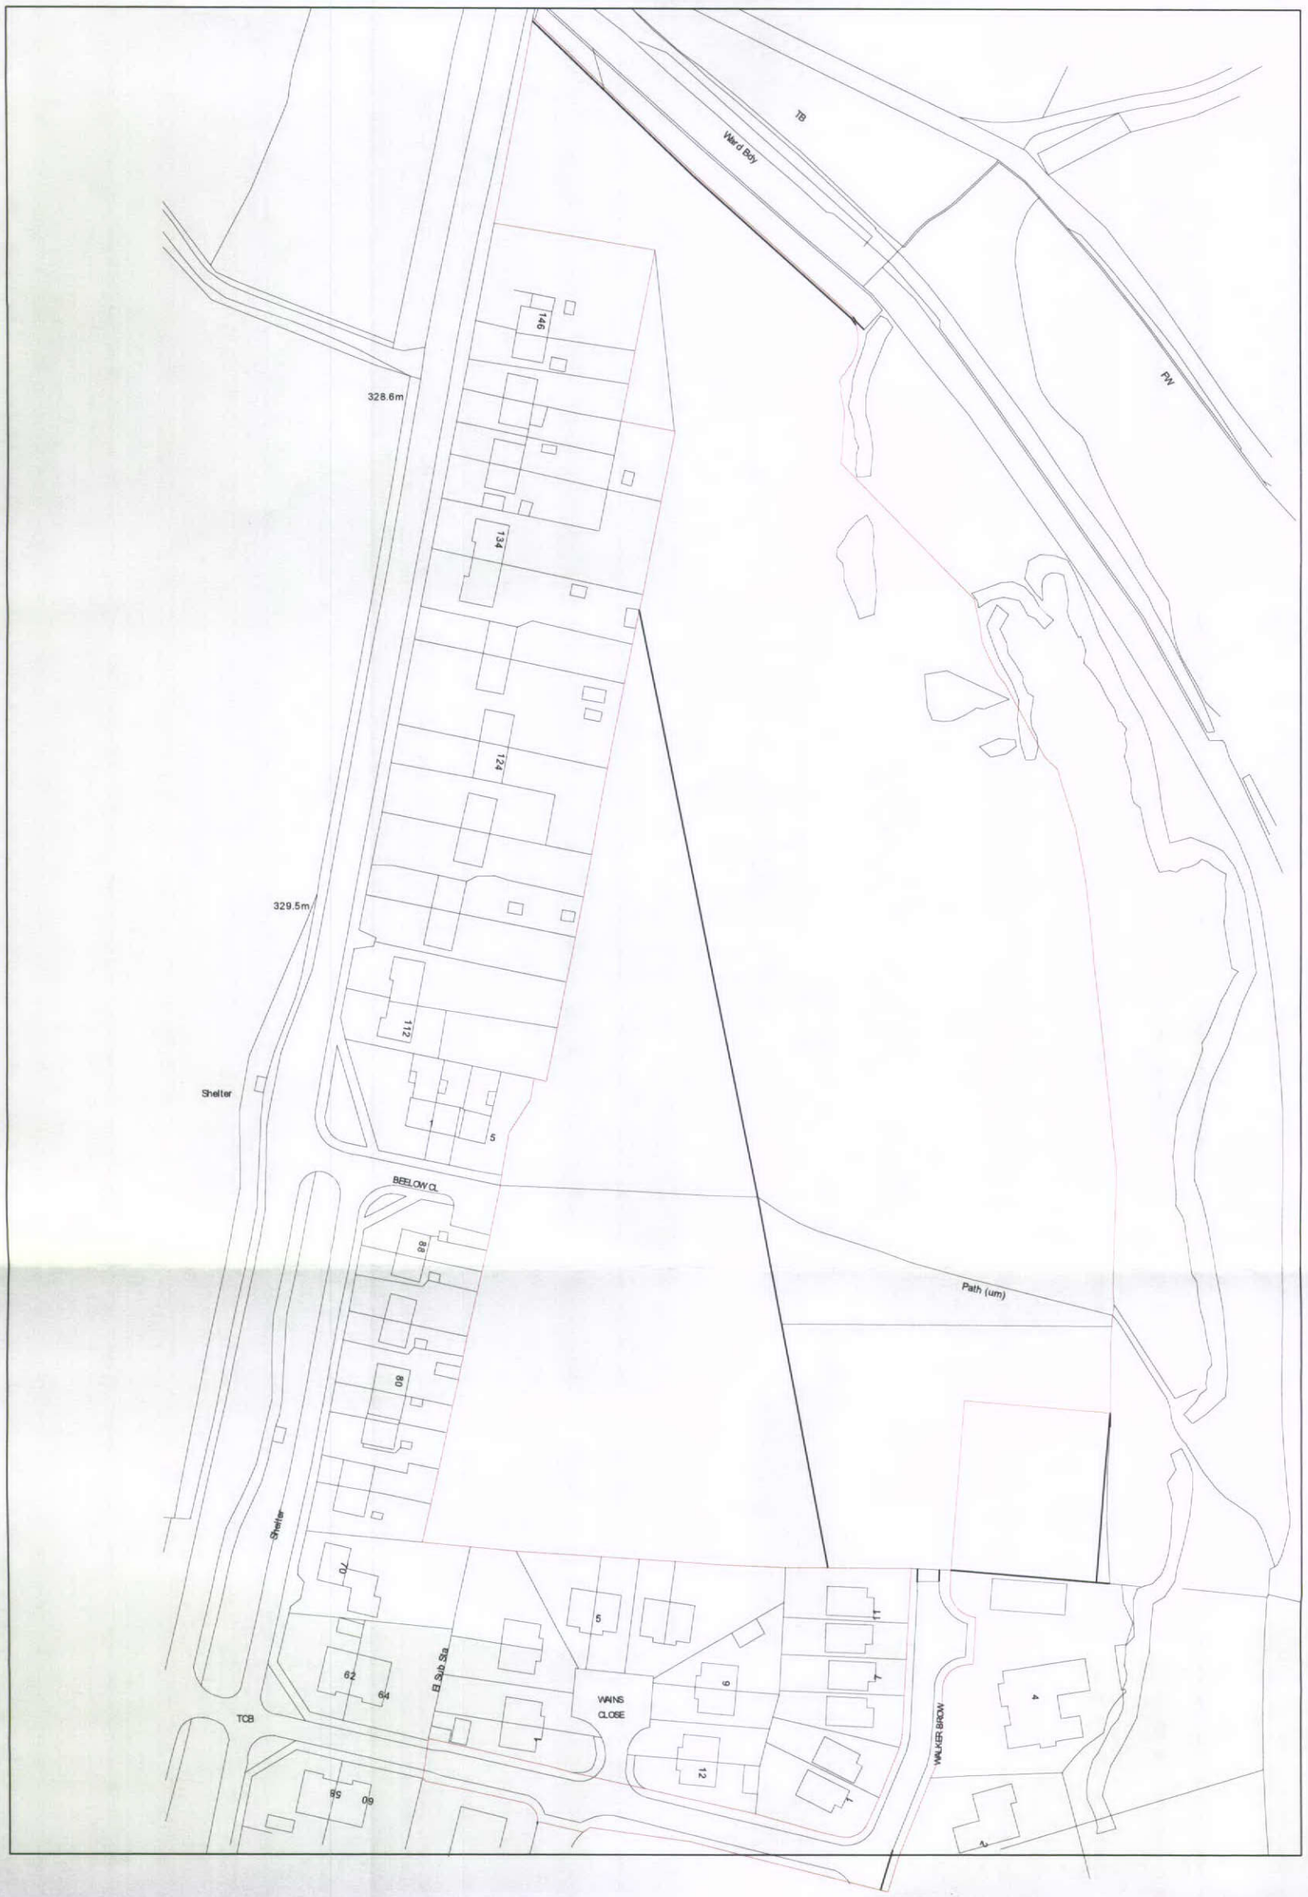

RECEIVED
11 JUN 2013
DERBYSHIRE DALES

0 10 20 30 40 50 100

Rev A Date 07-06-13 Red line revised

LEE ARCHITECTS LTD
1/F Cypress House
3 Grove Avenue Wilmslow
Cheshire SK9 5EG
T 01625 527448
F 01625 521946
M 07710 539748
E info@eearchitects.co.uk
copyright reserved

CLIENT
Jalo Enterprises Co. Ltd

PROJECT
Land to rear of Hallsteads
Hallsteads (A6)
Dove Holes
Buxton SK17

DRAWING
Outline Site Plan

DRAWING NUMBER
L558 / 10rA

DATE 12-09-12 SCALE 1:1000@A1