HPK/2013/0397

HIGH PEAK
22 JUL 2013
BOROUGH COUNCIL

This drawing is copyright.
Do not scale from this drawing.
All dimensions are to be checked on site.
Principal Dimensions are to main structure eg blockwork walls and timber stud walls not to finishes
All levels are in metres.


REFERENCE DRAWINGS AND SPECIFICATIONS

Drawings to be read in conjunction with the Building Regulations Notes & Specification Document

Planning - Client to submit drawing to confirm acceptability for as Permitted Development and acquire a Certificate of Lawful Construction in Local Authority approval of this status.


Building Regulations - Drawings and Specification subject to Building Regulations Approval via a Building Notice submission. Refer also to Separate Building Regs Notes (4679Drawing Spec Notes) and Calculations.

FOR CONSTRUCTION

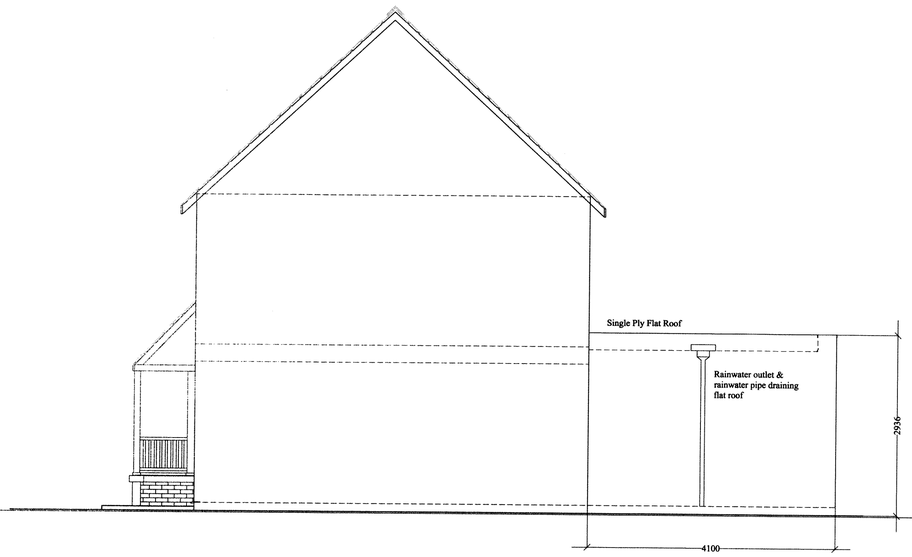

PROPOSED RIGHT ELEVATION

Scale 0 0.5 1 2 3 4 5 6 7 8 9 10 metres

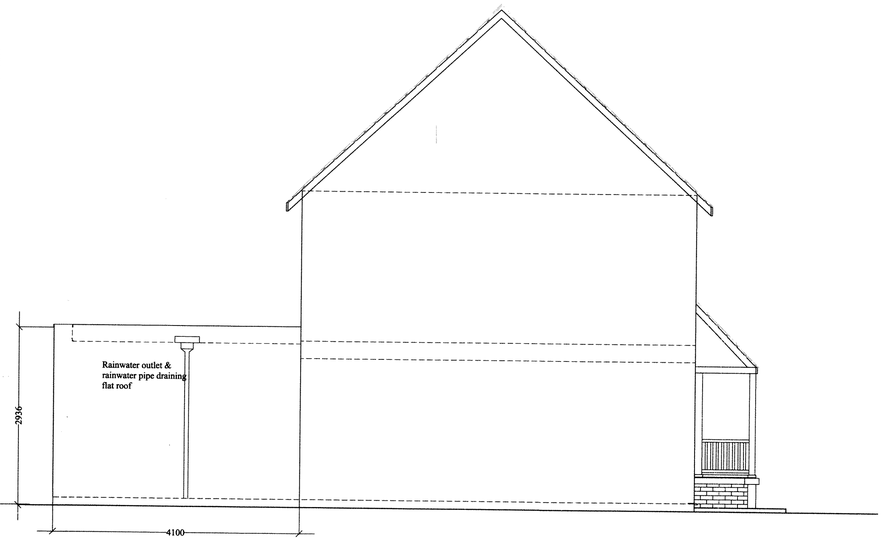

PROPOSED LEFT ELEVATION

Scale 0 0.5 1 2 3 4 5 6 7 8 9 10 metres

B	13/07/13	As built Depth of extension 4100mm
A	19/06/13	Depth of extension increased to 4300mm

REVISIONS:

J H Consulting
In Association with James Halldron Associates Consulting Engineers

Devon Office: Penquite House, 88 Dawlish Road, **TEIGNMOUTH**, Devon TQ14 8TG
Tel: 01626 777555, Fax: 01626 777555

WebSite: www.jameshalldronassociates.co.uk
Email: jh_consulting@btconnect.com

Associate Practice - James Halldron Associates Consulting Engineers
Devon Office: Bank Chambers, 1 Vaughan Parade,
TORQUAY, TQ2 5EG. Tel 01803 201771

Project:
20 Valley Road, Glossop

Drawing Title:
Proposed Side Elevation

Client:
Mr Gary Hopkins

Scale: **1/50**

Drawn:	Date:	Chkd:	Date:
JRH	18/06/13	JRH	18/06/13

Drwg No:
JHC-1023-04B