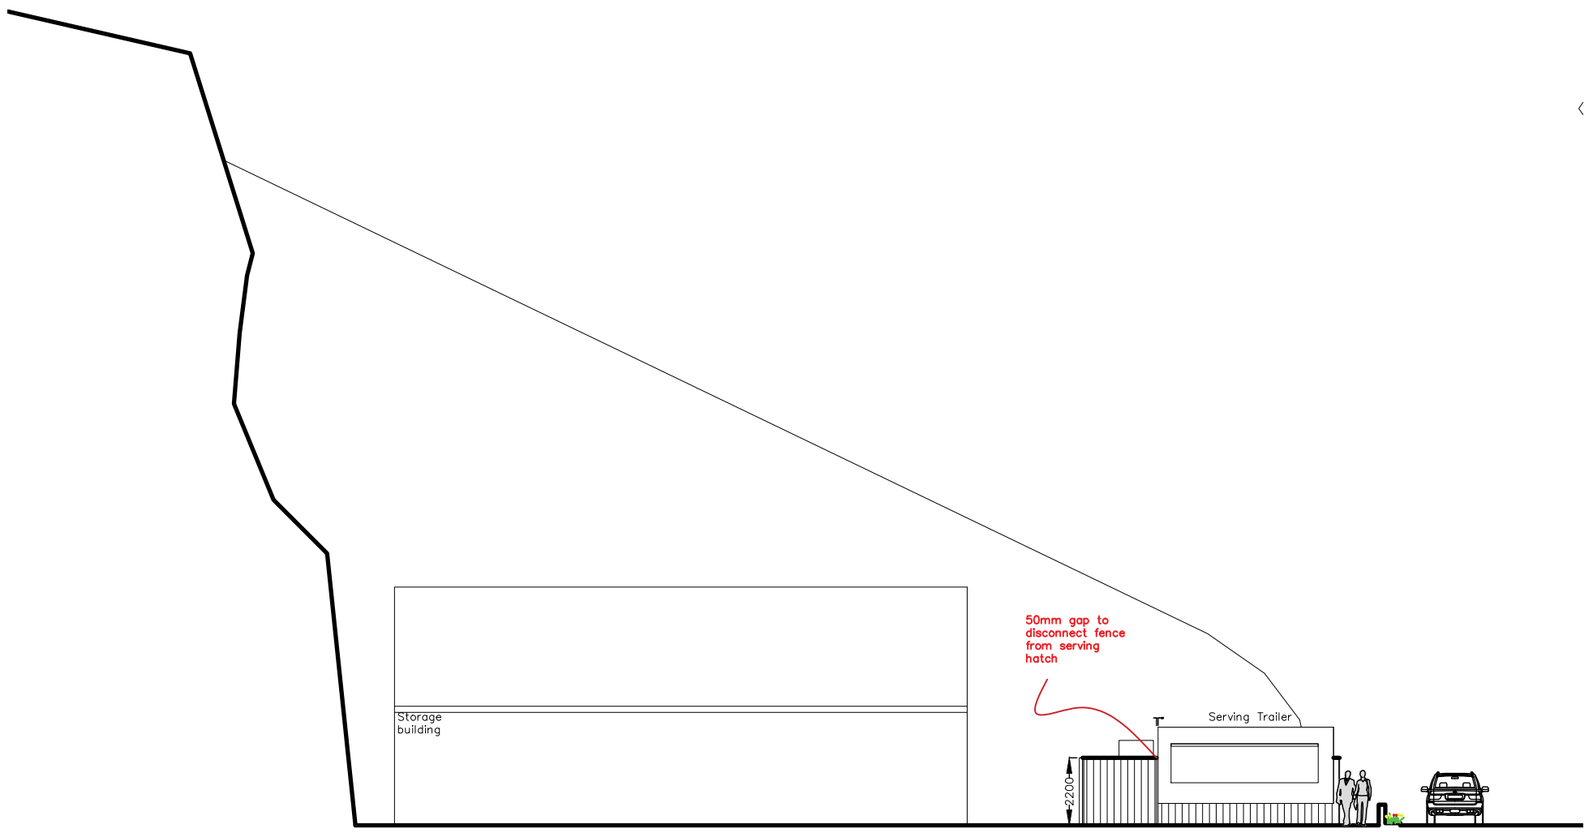

East Elevation and section through site

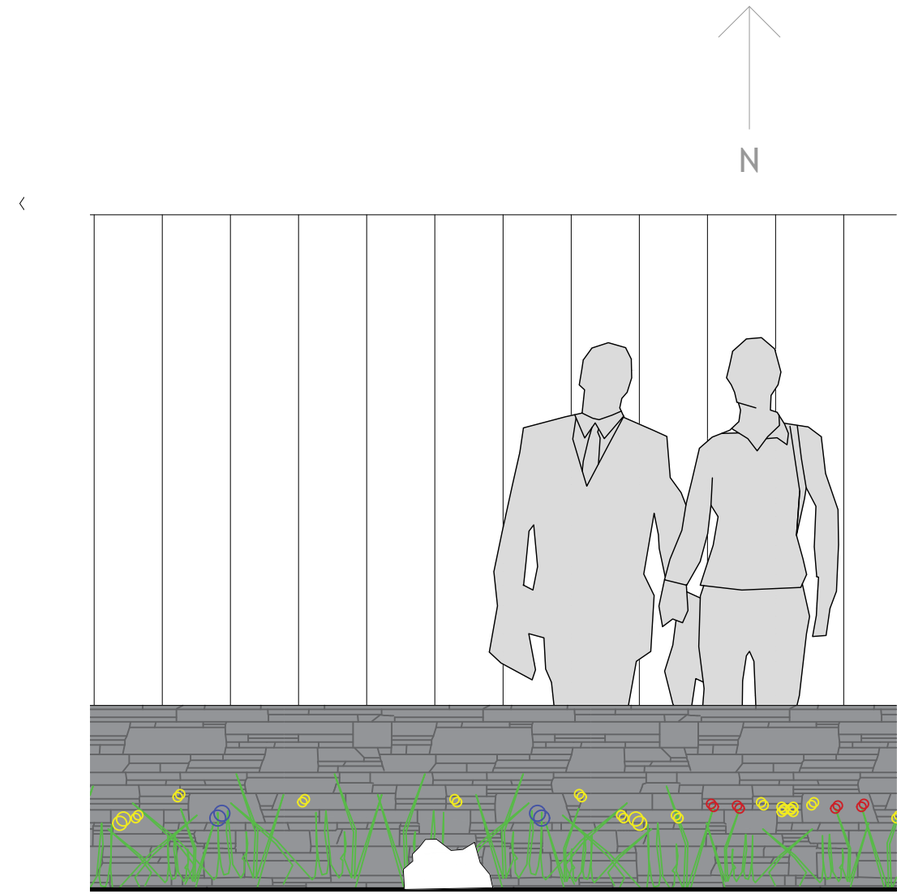

South Elevation $\frac{1}{20}$ extract

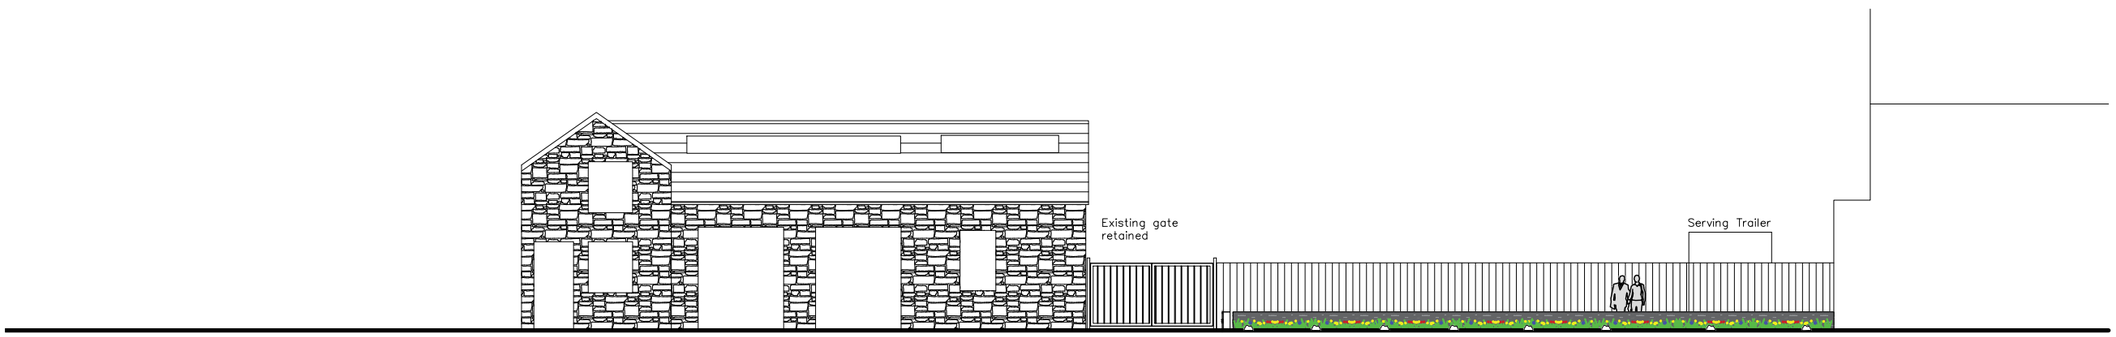

South Elevation

NOTES:

Grace Architecture take no responsibility for any dimensions obtained by scaling from this drawing. If no dimension is shown the recipient must ascertain the dimension specifically from the Contract Administrator or by site measurement. Supplying this drawing in digital form is solely for convenience and no reliance may be placed on digital data. All data must be checked against hard copy. Dimensions must be checked on site. Any discrepancies must be reported to the Contract Administrator immediately. This drawing is copyright of Grace Architecture.

The Old Firehouse

Pr	Preliminary		C	Contract
F	Feasabilty		Cn	Construction
P	Planning		As	As Built
T	Tender		Other	

Hague bar

Elevations Proposed

0 2m 4m Scale 1:200 A3

014-06

C

Grace Architecture

Shady Oak
Marple Road
Offerton
Stockport
SK2 5HF

www.gracearchitecture.co.uk
gracearchitecture@gmail.com